



Site Location (Basement)

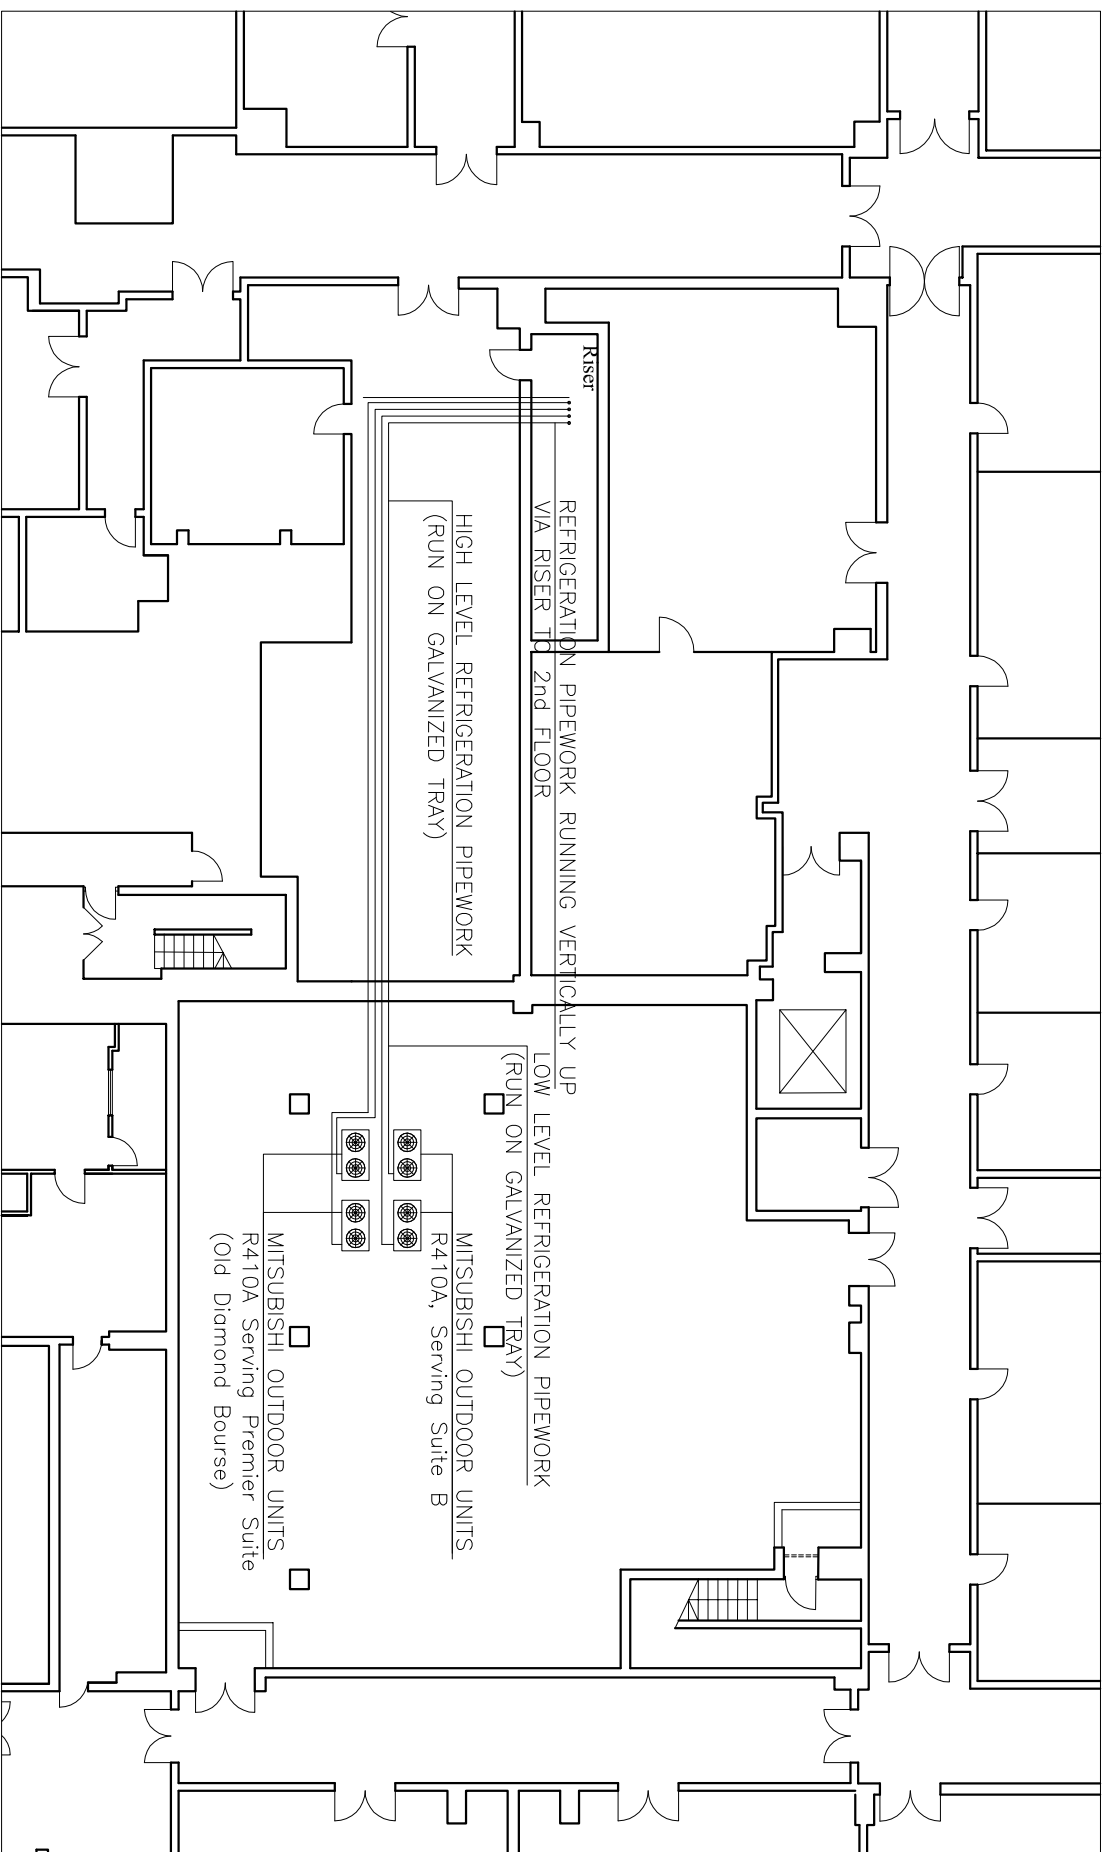

Notes:

Revision No.	Date

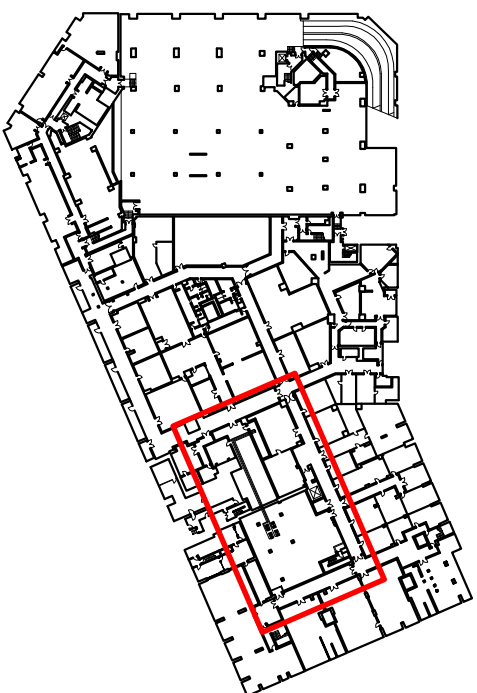

143 Lemna Street, London E1 8EY
 Tel: 020 7481 0222, Fax: 020 7481 3233
 Web site: www.polyteck.co.uk

Client / Location : Diamond Bourse
 100 Hatton Garden
 London EC1

Drawing : As Installed Outdoor AC Units

Scale : 1:200@A3
 Date : 13.11.07
 Drawing No. 3435B-09
 Drawn By : AK
 Revision :