

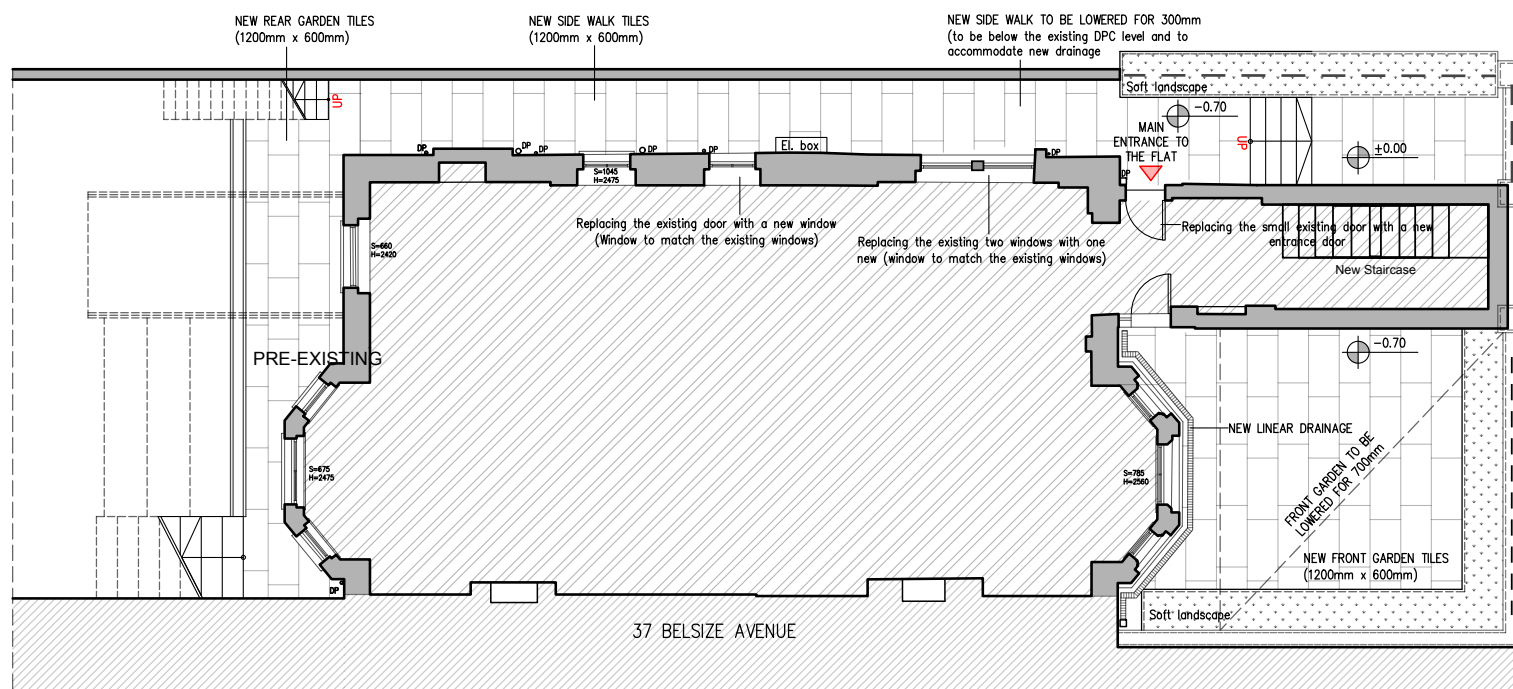


1 LOWER GROUND FLOOR LAYOUT PRE-EXISTING  
1:100 @ A2

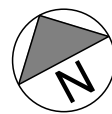

2 LOWER GROUND FLOOR LAYOUT AS BUILT  
1:100 @ A2

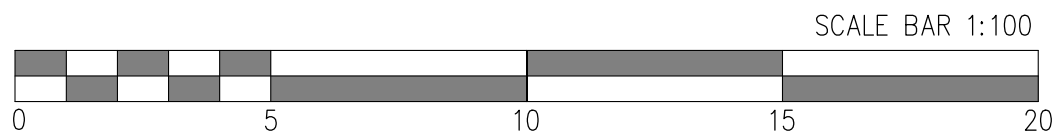

BELSIZE AVENUE

BELSIZE AVENUE

GENERAL NOTES:

1. This drawing is copyright of Zax Construction Ltd.
2. Dimensions should not be scaled from the drawings where accuracy is essential.
3. Details dimensions and levels to be checked on site by builder prior to commencement of works. Any works commenced prior to all necessary local authority approvals are entirely at the risk of the owner & builder.



COMPANY NAME:  
ZAX CONSTRUCTION LTD  
zaxconstructionltd@gmail.com  
07753613051

PROJECT:  
Belsize Avenue, NW3 5AS London

DRAWING TITLE:  
Lower Ground Floor Layout  
Pre-Existing & As Built

DATE CREATED: 08/08/2022  
SCALE: 1:100; A2