

THIRD FLOOR


SECOND FLOOR

FIRST FLOOR

GARDEN FLAT 39A

GROUND FLOOR

LOWER GROUND FLOOR

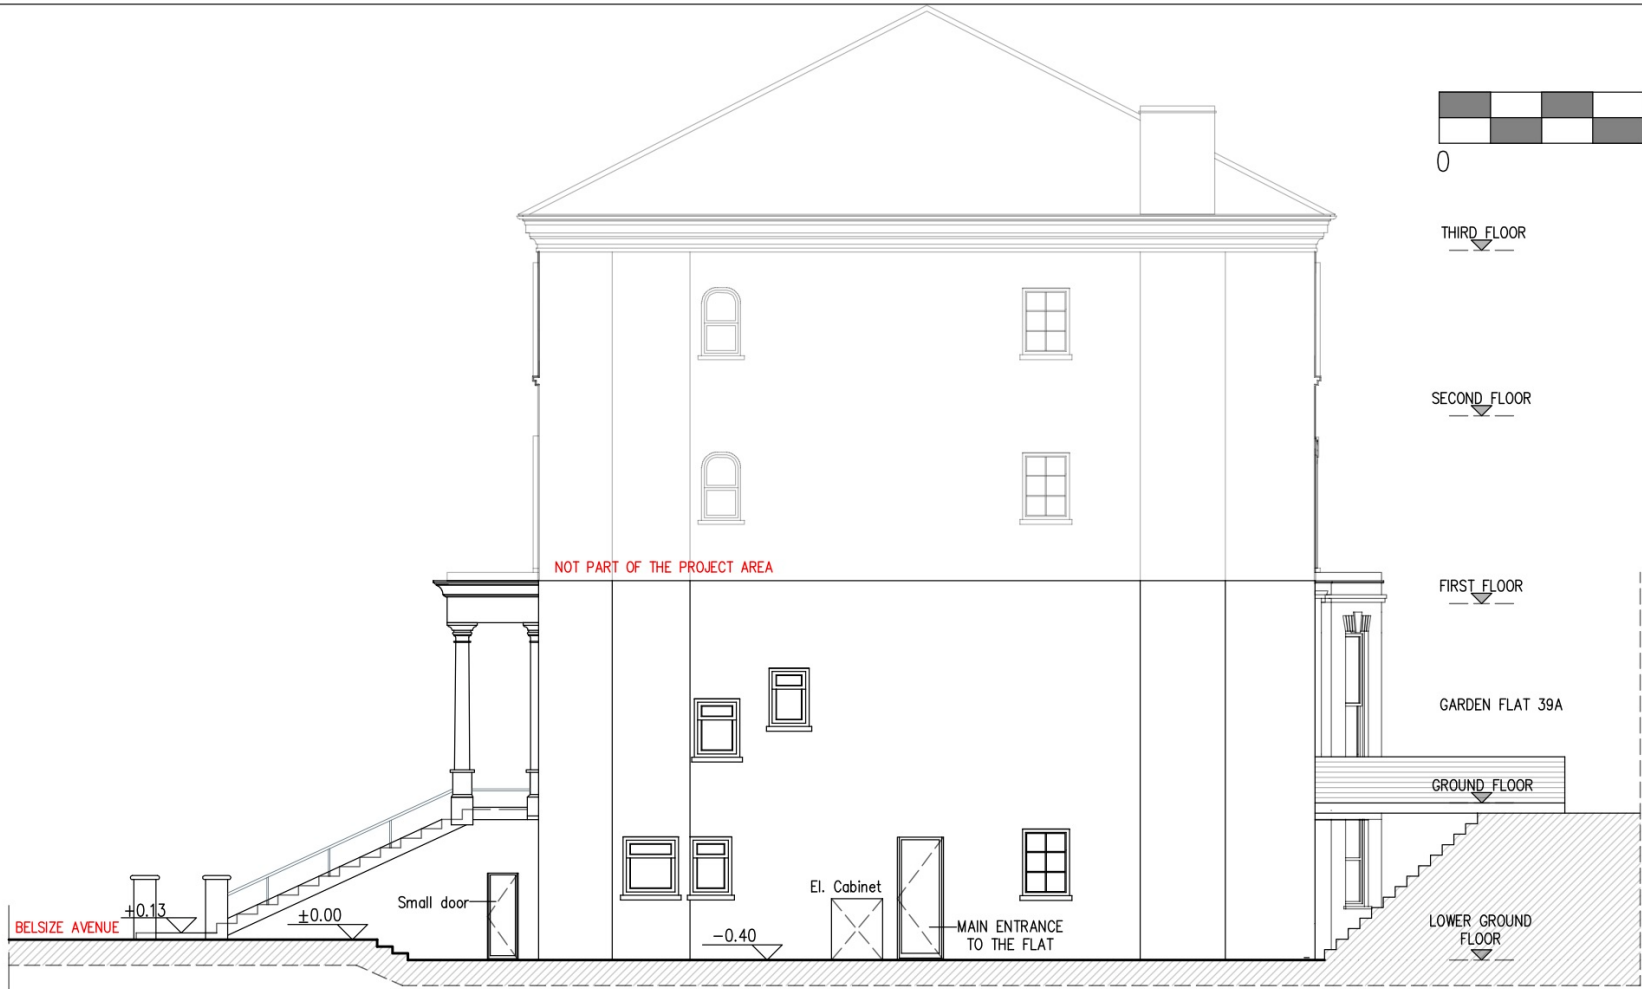

9 SIDE ELEVATION PRE-EXISTING
1:100 @ A2

THIRD FLOOR


SECOND FLOOR

FIRST FLOOR

GARDEN FLAT 39A

GROUND FLOOR

LOWER GROUND FLOOR

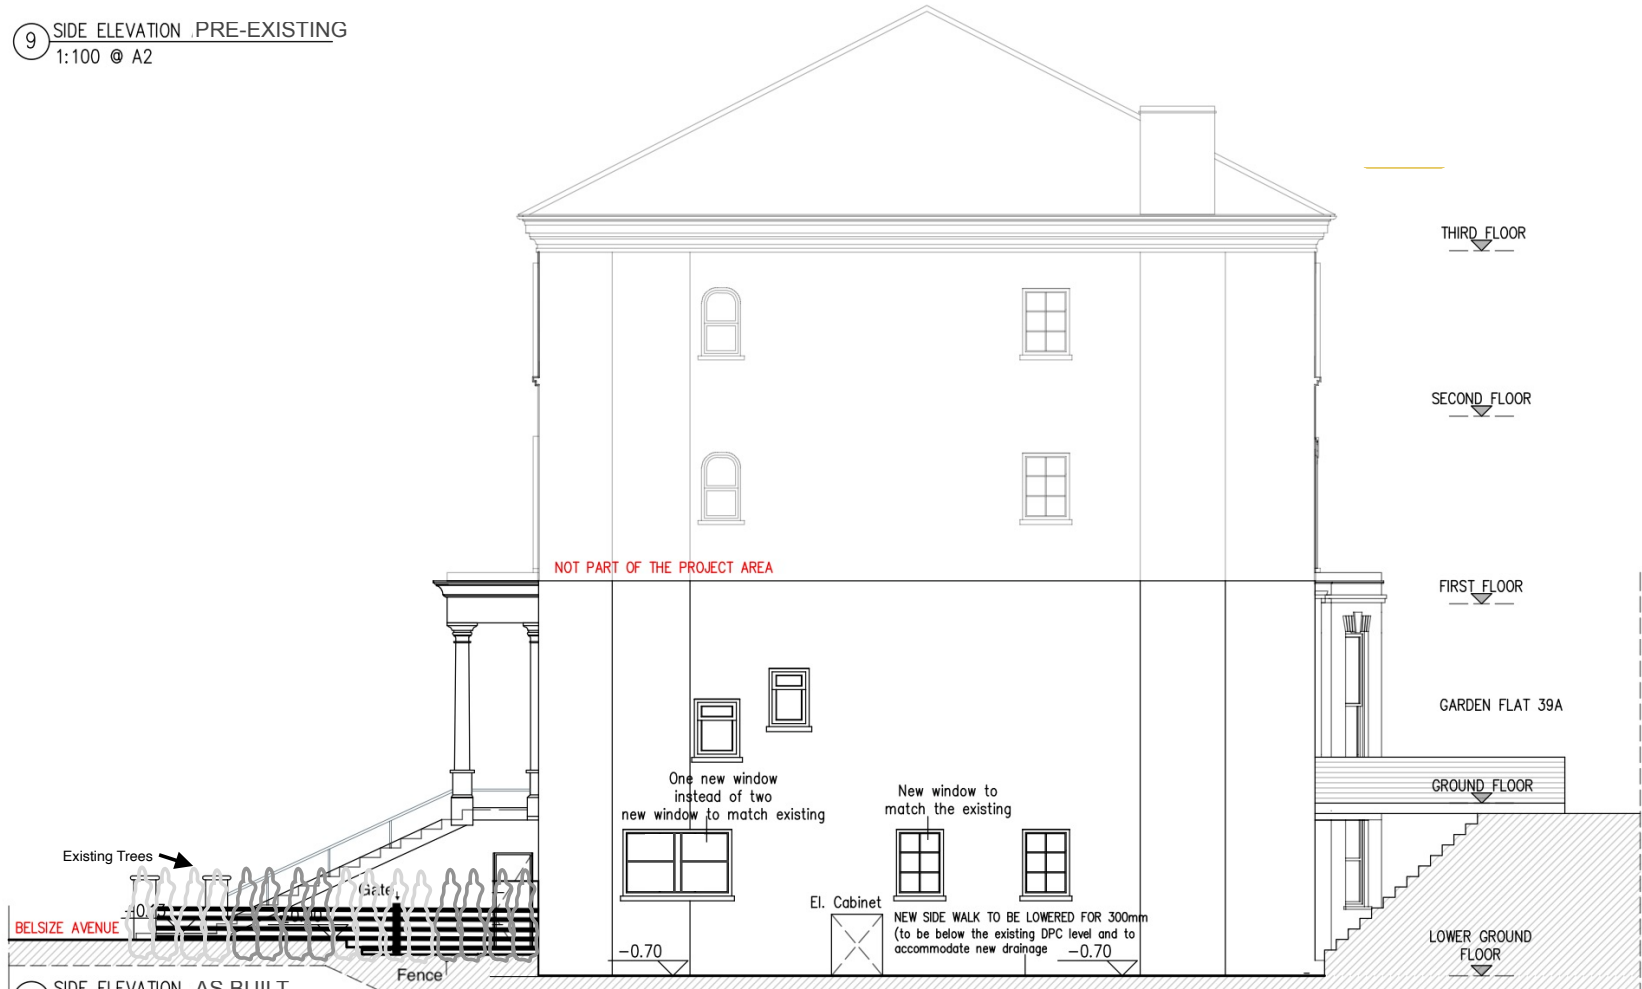

10 SIDE ELEVATION AS BUILT
1:100 @ A2

GENERAL NOTES:
 1. This drawing is copyright of Zax Construction Ltd.
 2. Dimensions should not be scaled from the drawings where accuracy is essential.
 3. Details dimensions and levels to be checked on site by builder prior to commencement of works. Any works commenced prior to all necessary local authority approvals are entirely at the risk of the owner & builder.



COMPANY NAME:
 ZAX CONSTRUCTION LTD
 zaxconstructionltd@gmail.com
 07753613051

PROJECT:
 Belsize Avenue, NW3 5AS London

DRAWING TITLE:
 Side Elevation
 Pre-Existing & As Built

DATE CREATED: 08/08/2022
 SCALE: 1:100; A2