



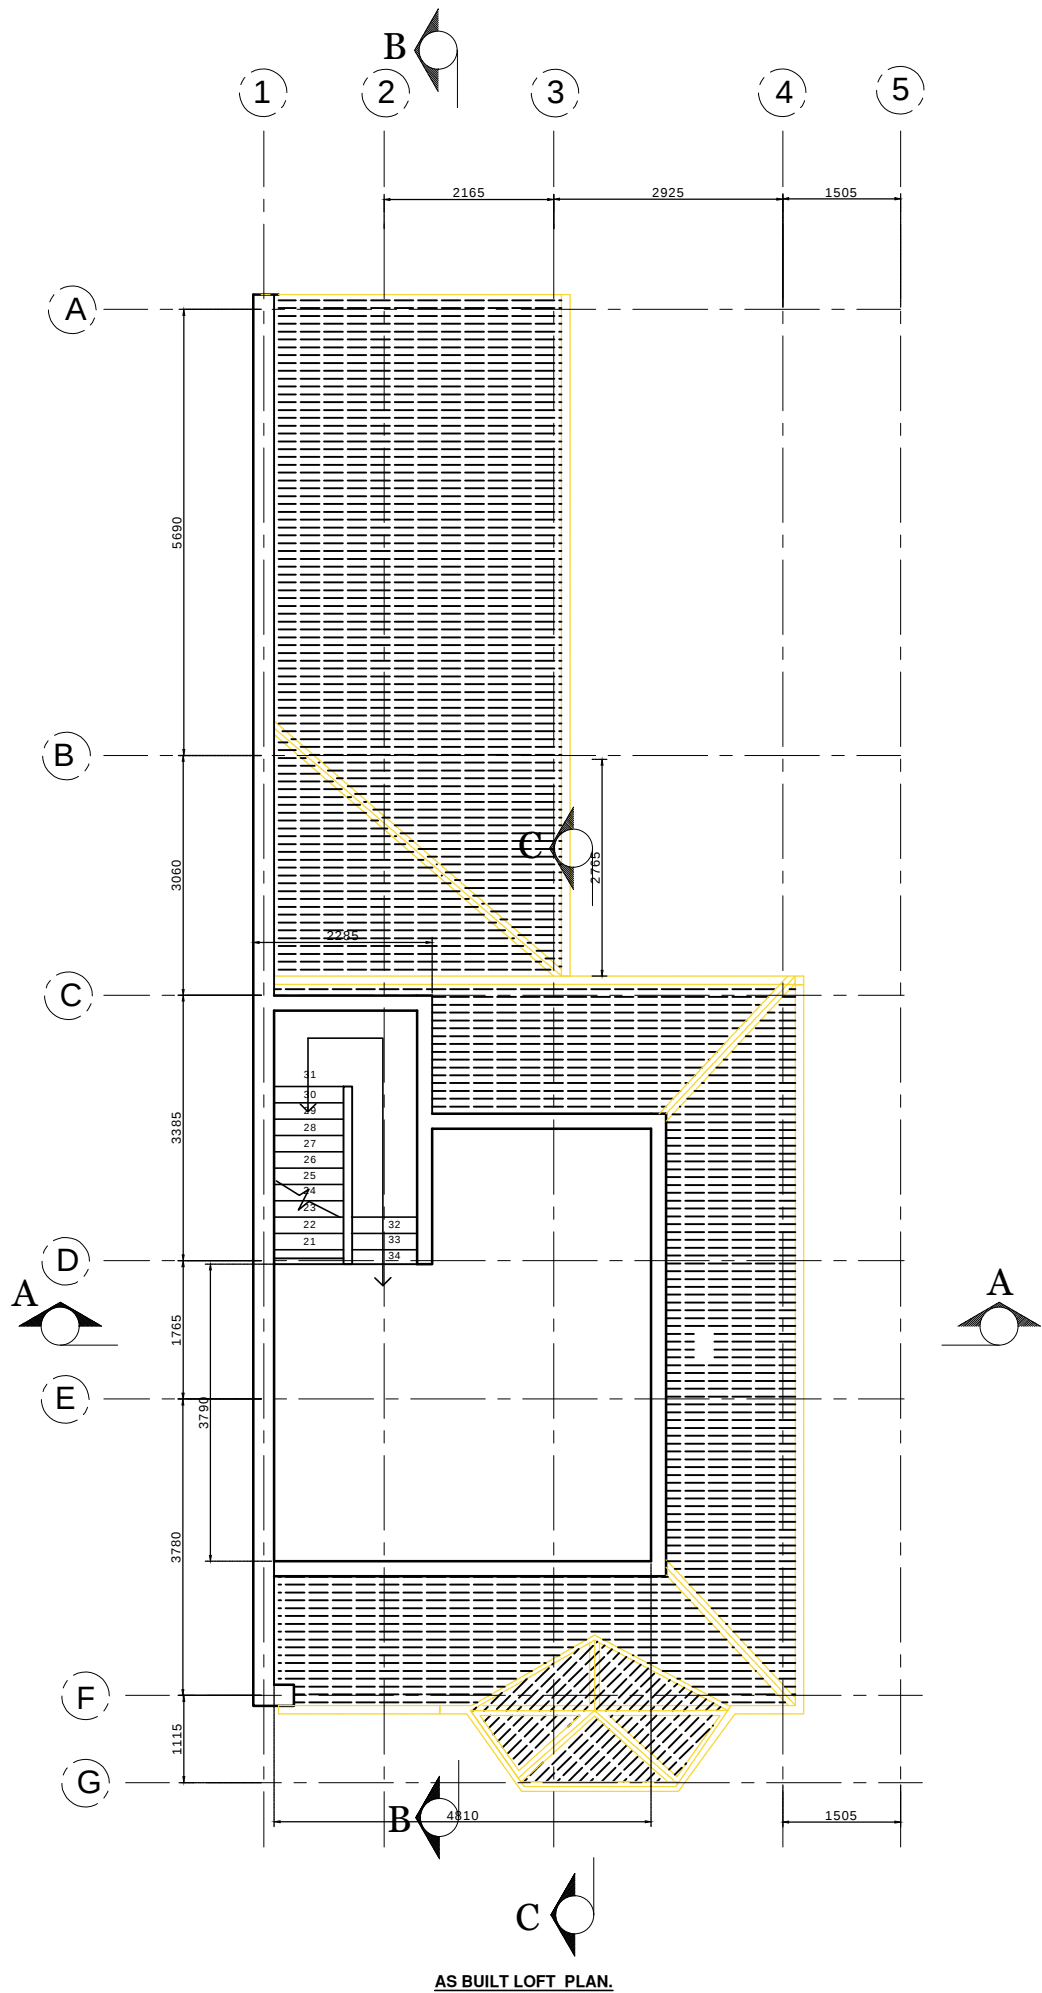

AS BUILT LOFT PLAN.

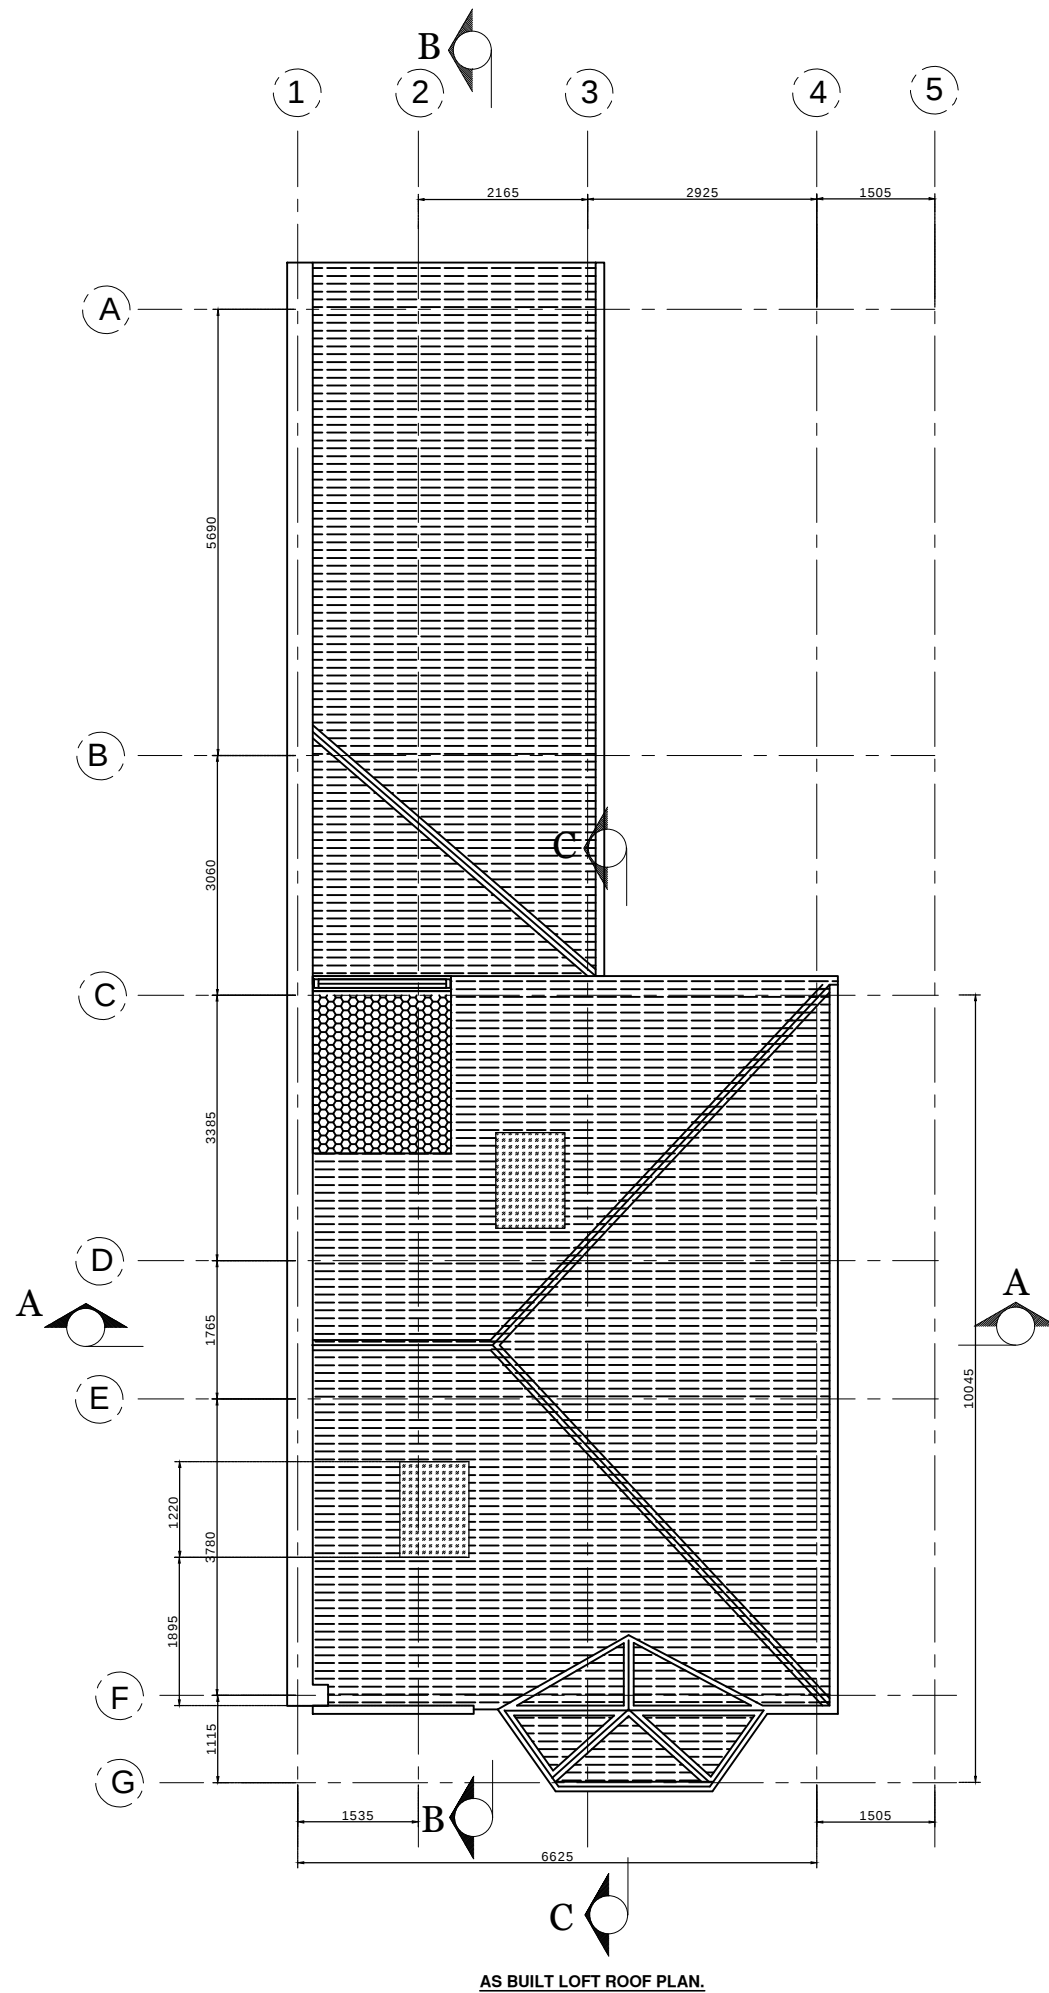

AS BUILT LOFT ROOF PLAN.

Client MR MICHAEL	
Project 24 EBBSFLEET ROAD, London, NW23 NA	
Job Title LOFT AS BUILT	
Drawing Title AS BUILT LOFT PLAN AND ROOF	
Date December 2022	Drawing No. INT/2022/12/01/05
Revision: PLANNING/03	
Date: 19/02/2022	
Suitability	
Ref Archt. Dwg.	
INTELLECT C&C LIMITED 30 MOUNTSIDE STANMORE, HA7 2DP.	
1:50 Scale 1:50 1m 0 1m 2m	
1:100 Scale 1:100 2m 0 2m 4m	