



REAR ELEVATION AFTER LOFT CONSTRUCTION.



FRONT ELEVATION AFTER LOFT CONSTRUCTION.

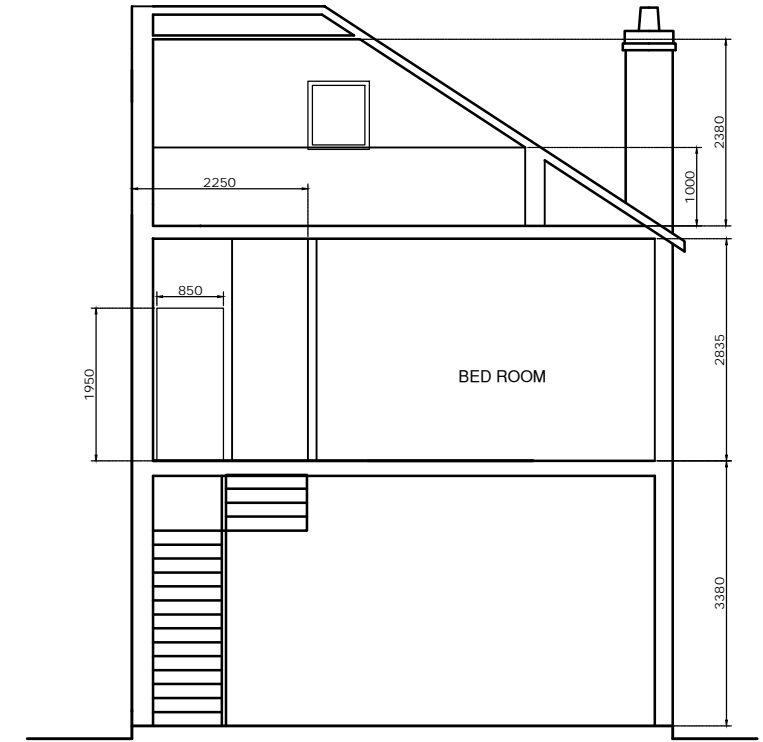

SECTION A-A

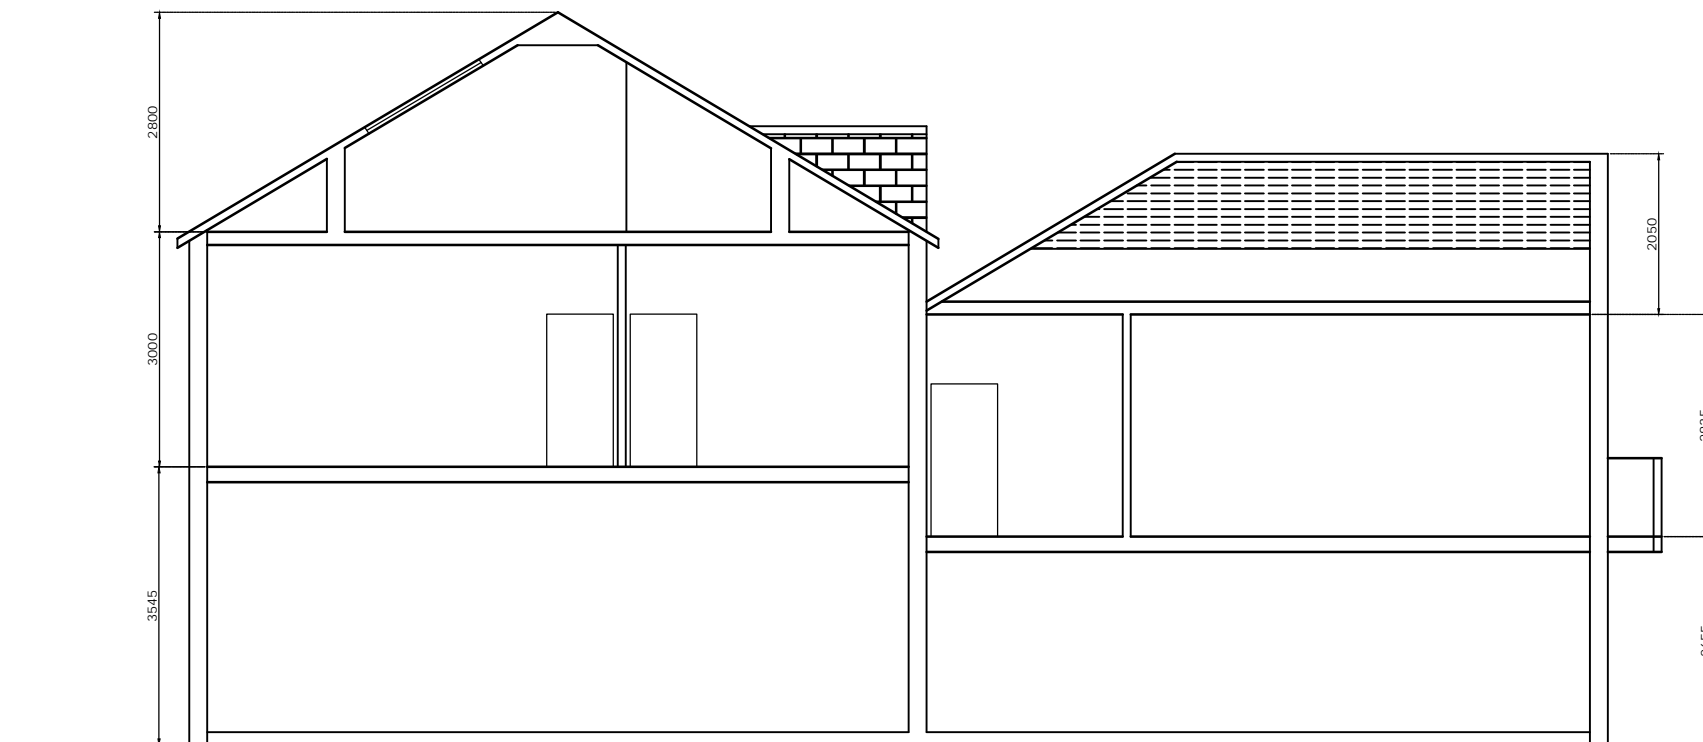

SECTION B-B

Client	MR MICHAEL
Project	24 EBBSFLEET ROAD, London, NW23 NA
Job Title	LOFT AS BUILT
Drawing Title	AS BUILD LOFT ELEVION
Date	December 2022
Drawing No.	INT/2022/12/01/06
Revision:	PLANNING/03
Date:	19/02/2022
Suitability	
Ref Archt. Dwg.	
INTELLECT C&C LIMITED 30 MOUNTSIDE STANMORE, HA7 2DP.	
1:50 Scale 1:50	
1:100 Scale 1:100	