


Schuco window: AWS70SC
 Frame Finish: RAL 7005 matt
 Glass spec.
 6mm Clear toughened
 20mm Argon cavity
 6mm Clear laminated (Low e.)
 All ironmongery: Black

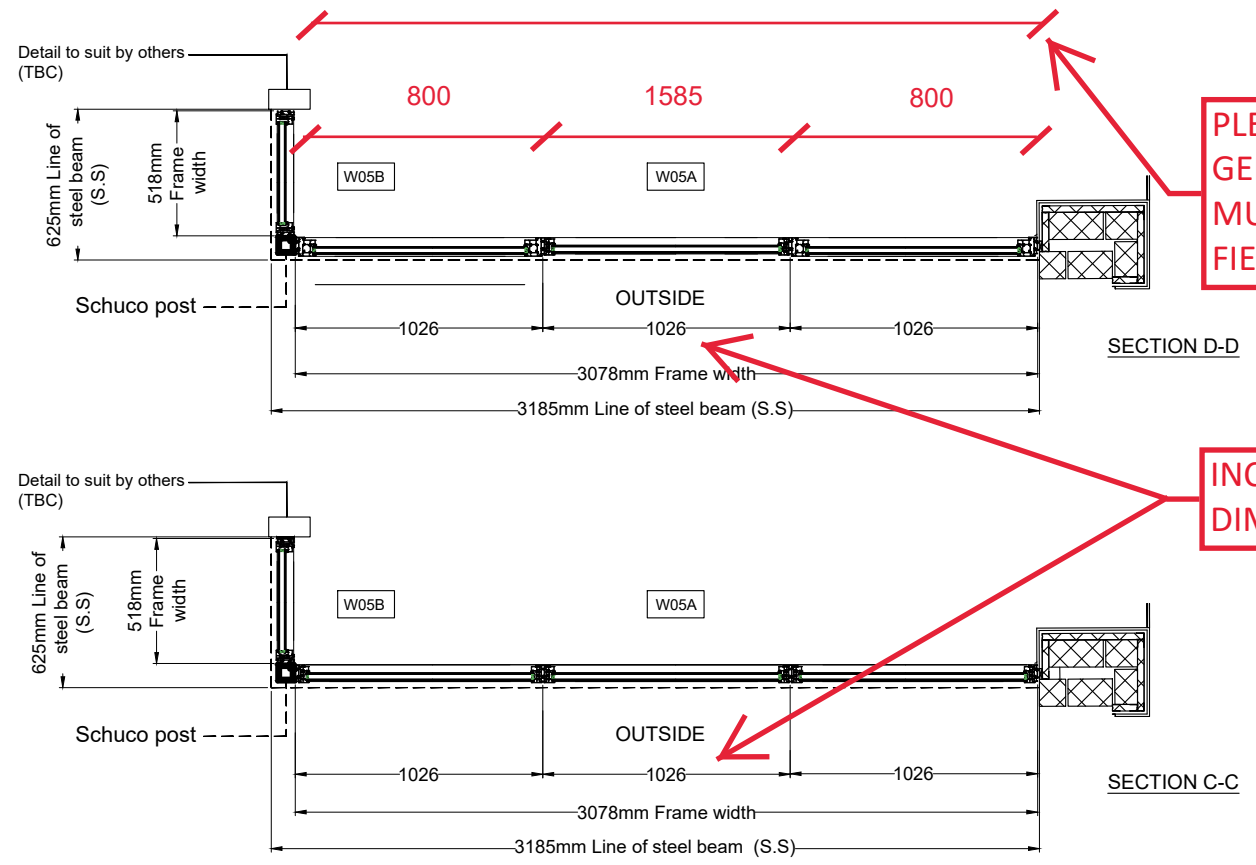

PLEASE NOTE ALL GENERAL DIMENSIONS MUST BE VERIFIED IN FIELD.

INCORRECT DIMENSION.

Glass Spec.: See elevation

Spacer bar colour: Black (TBC)

Client Checklist

- IRONMONGERY
- HANDLE FINISH: SEE ELEVATION
 - HINGE FINISH: SEE ELEVATION

- SYSTEM FINISH(ES)
- INTERNAL FINISH: SEE ELEVATION
 - EXTERNAL FINISH: SEE ELEVATION

- SIGNED APPROVAL
- STATUS A: APPROVED FOR CONSTRUCTION
 - STATUS B: APPROVED AS NOTED
 - STATUS C: RESUBMIT FOR APPROVAL

SIGNED: _____
 PRINT: _____
 DATED: _____

IN ORDER TO ENSURE THAT YOUR EXPECTATIONS ARE MET, WE WOULD ASK THAT YOU REVIEW THE DRAWINGS AND TICK AS APPROPRIATE ABOVE AND SIGN.

NOTE: MANUFACTURE CAN COMMENCE ONLY ONCE APPROVAL STATUS A OR B HAS BEEN RECEIVED.

© 2005 - 2017
 THIS DRAWING REMAINS THE PROPERTY OF ALCO GLASS SYSTEMS LTD AND MAY NOT BE UTILISED, DISSEMINATED, DISTRIBUTED OR REPRODUCED SAVE FOR THE PURPOSES FOR WHICH IT WAS ISSUED BY ALCO GLASS SYSTEMS LTD WITHOUT EXPRESS WRITTEN PERMISSION.

ISSUED FOR: APPROVAL

REV.	DATE	REVISION	BY
A	08-2-23	UPDATED TO COMMENTS AND SURVEY	BP

DO NOT COPY WITHOUT OUR WRITTEN CONSENT

PRODUCT SPEC.	Schuco
OPERATING SYSTEM	See elevation
GLAZING	See elevation
FURNITURE	N/A
PANEL FINISH	See elevation
No. OF PANELS	See elevation

alcoglass

Sycamore House, 1 Woodside Rd,
 Amersham, Bucks, HP6 6AA
 Tel: 01494 95 77 30
 www.alcoglass.co.uk

CLIENT PHILIAM CONSTRUCTION LTD

PROJECT 8 REGAL LANE, LONDON

TITLE W05 A & B

DATE	12-10-22	DRAWING NUMBER	AG-P22-47-10
DRAWN BY	BP	SCALE	NTS

Paper Size A3
 Projection