




AS-BUILT
FRONT ELEVATION

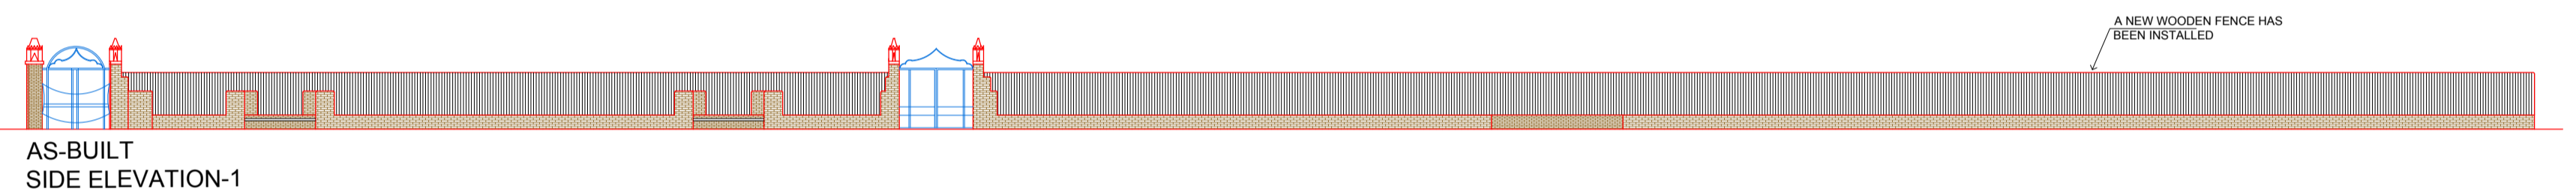

AS-BUILT
SIDE ELEVATION-1

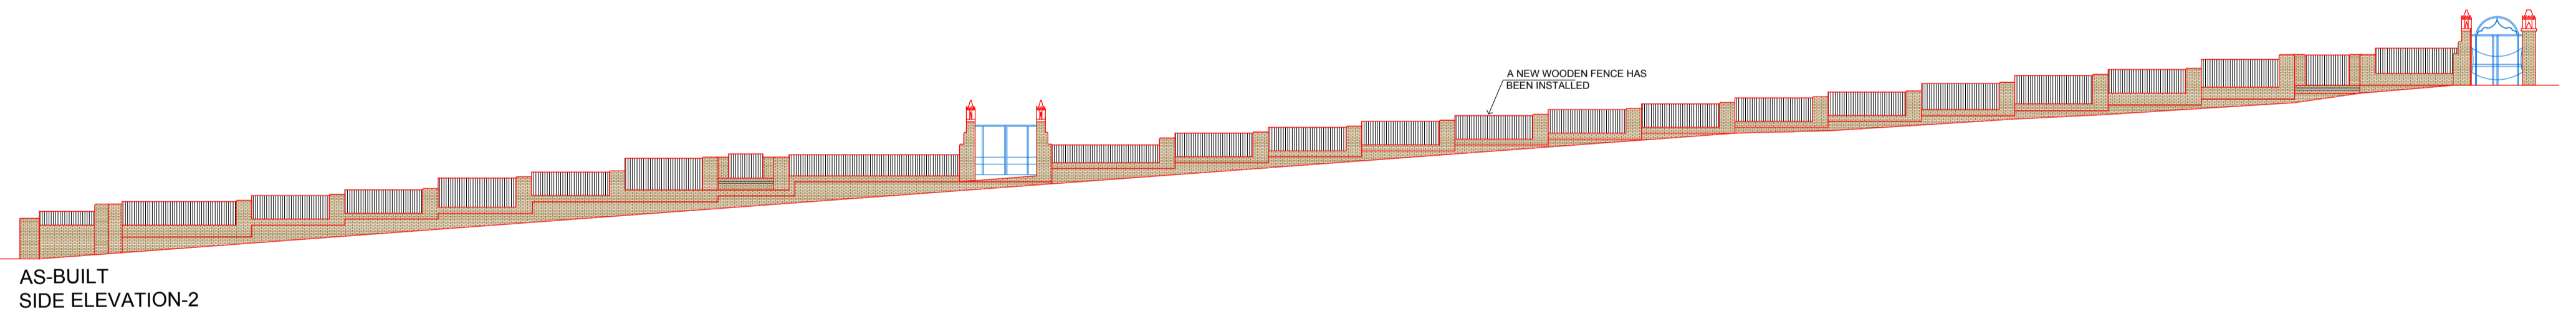

AS-BUILT
SIDE ELEVATION-2

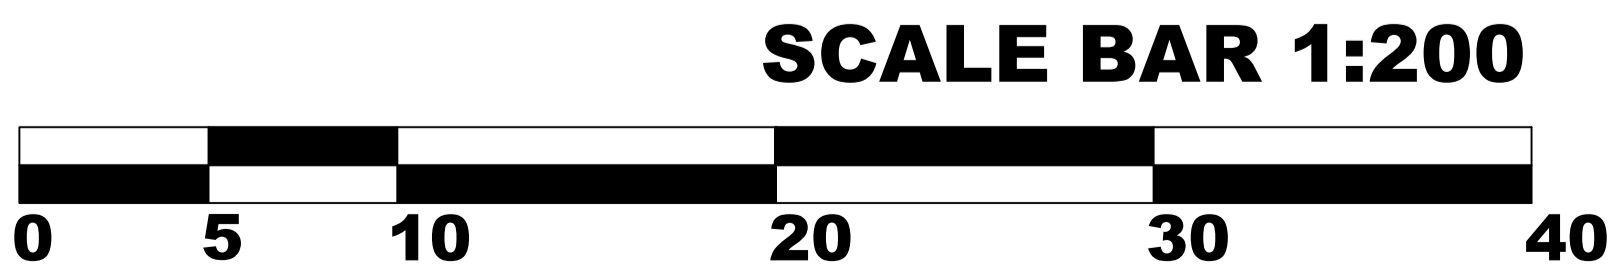

HB PLANNING SERVICES
 EMAIL INFO@HBPLANNINGSERVICES.CO.UK
 CONTACT 02038539648

Scale 1:200 @ A1

Project
 Hampsteadhill school, London
 NW3 2PP

Drawing:
 Proposed Elevations

Number:
 2023/02/03

Date:
 March 2023

