


As-built works already approved under the Planning and Listed Building Consent ref. 2022/3105/P, 2022/3599/L and 2022/5141/L

New works proposed in addition to those already approved under the Planning and Listed Building Consent ref. 2022/3105/P, 2022/3599/L and 2022/5141/L

- Key
- Existing
  - Existing demolished
  - Proposed

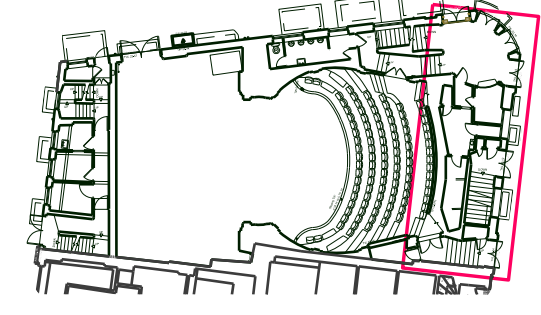


**Note:**  
Refer also to Structural Engineer's 5208\_MOM\_XX\_XX\_DN\_S\_11001\_P01 Structural design philosophy and details for the proposed structural remedial works design philosophy and MEP's services Philosophy Planning Statement 21\_02\_2023 for the redundant boilers and associated services removal in the existing Boiler Room

THE CONTRACTOR IS TO CHECK AND VERIFY ALL BUILDING AND SITE DIMENSIONS, LEVELS AND SEWER INVERT LEVELS AT CONNECTION POINTS BEFORE WORK STARTS

THIS DRAWING IS TO BE READ AND CHECKED IN CONJUNCTION WITH ENGINEERS AND OTHER SPECIALIST DRAWINGS

THE DRAWING AND THE WORKS DEPICTED ARE THE COPYRIGHT OF THIS PRACTICE AND MAY NOT BE REPRODUCED EXCEPT BY WRITTEN PERMISSION

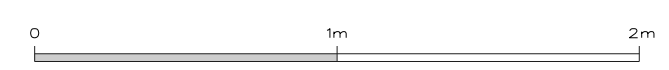

G	06/03/23	Planning
F	25/11/22	Planning - Additional works to 2022/3105/P and 2022/3599/L
E	15/11/22	Planning - Additional works to 2022/3105/P and 2022/3599/L
D	27/10/22	Planning
C	20/09/22	Planning
B	18/08/22	For BC Review
A	13/07/22	Planning
Rev:	Date:	Description

Job: 2201 Ambassadors Theatre  
Client: Ambassador Theatre Group

Drawing: West Street Passage Plan - LGF  
Drawing no: 2201-3-310  
Scale: 1:50@A3, 1:25@A1  
Rev: G  
Status: Planning  
Date: 06/03/23

**citizensdesignbureau**  
Ground Floor Units 101 & 103, 6 Westgate Street, London, E8 3JH  
t : 02030959732  
e : everyone@citizensdesignbureau.net