


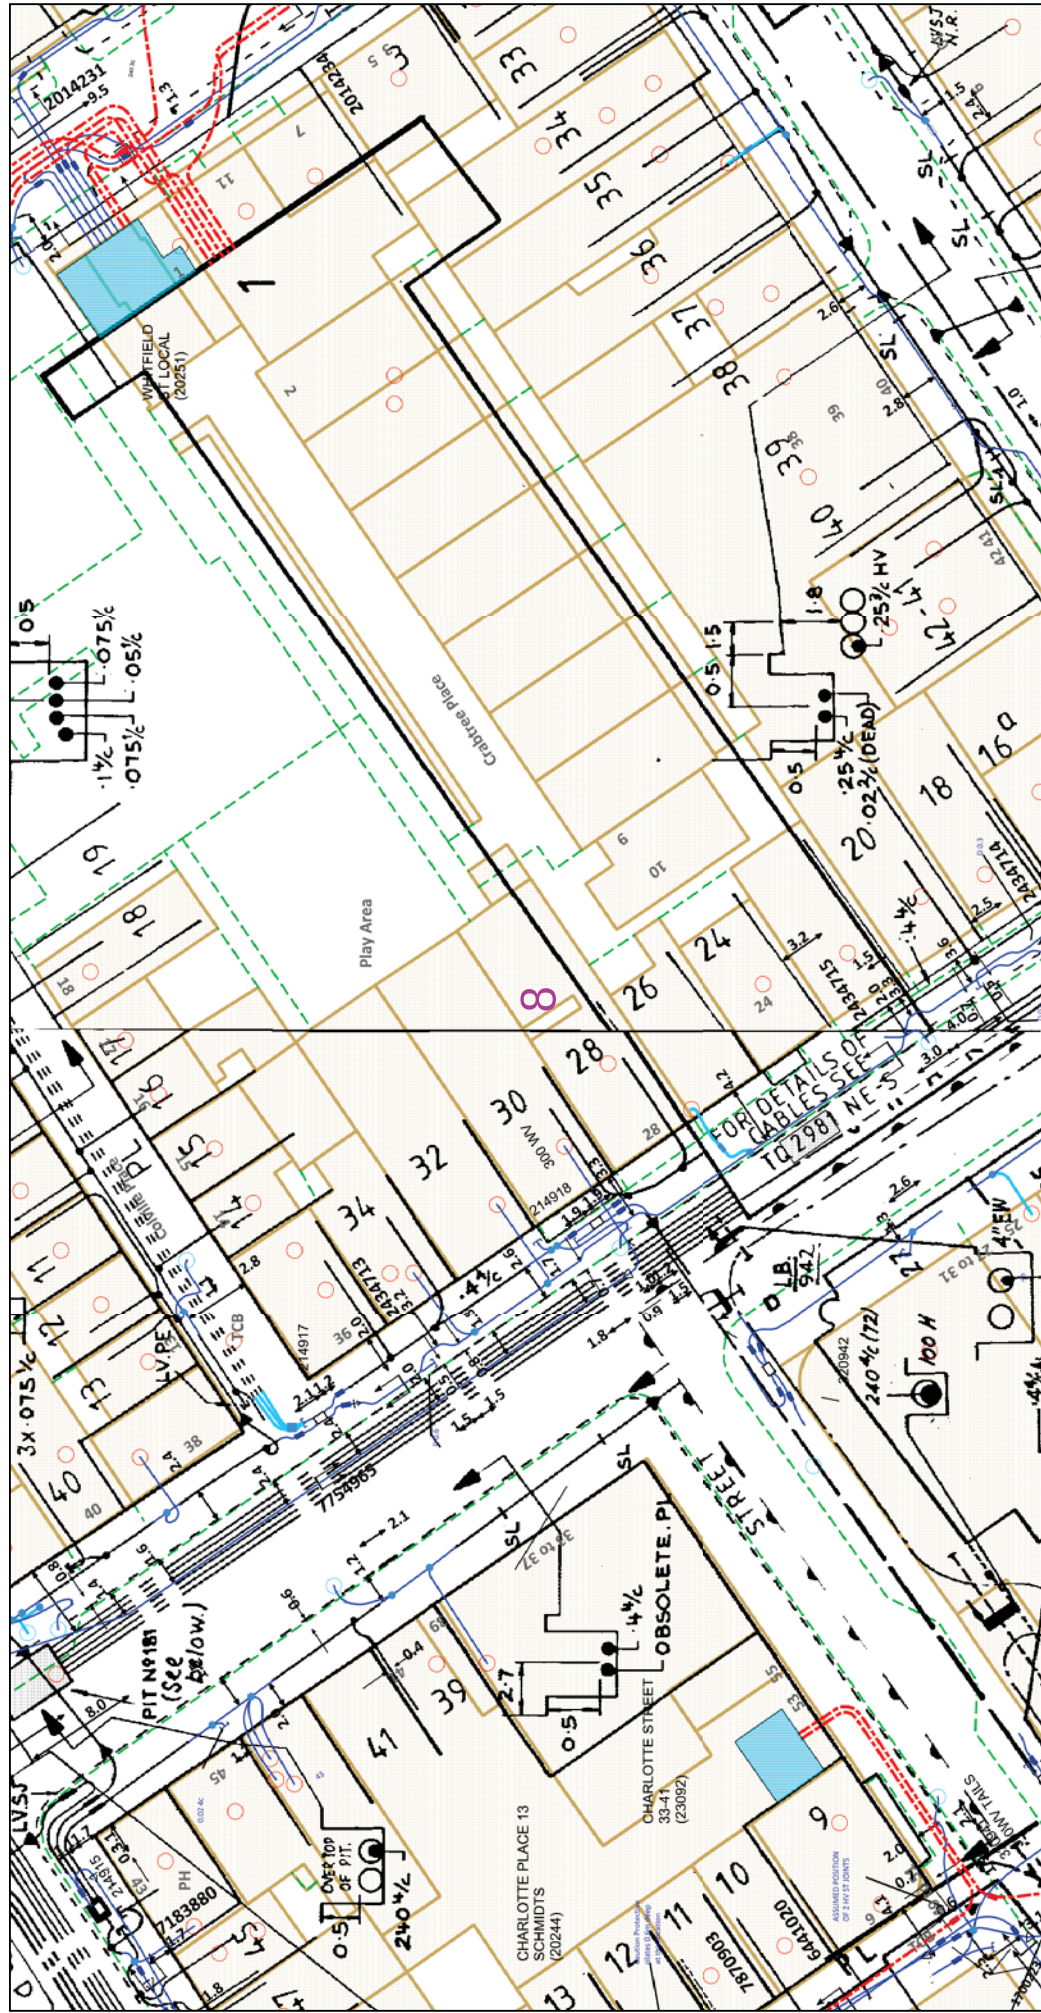

The quality and accuracy of any print will depend on your printer, your computer and its print settings. Measurements scaled from this plan may not match measurements between the same points on the ground.

Dig Sites Area: Line:

This plan must be used with the attached 'Symbols' document.

Date Requested: 14/06/2023

Job Reference: 29816993

Site Location: 529346 181501

Requested by: Mr Ben Evans

3

Your Scheme/Reference: LM
205728/KaV


Scale: 1:500 (When plotted at A4)

1. The position of the apparatus shown on this drawing is believed to be correct but the original drawings are not to scale. The drawings are not intended as cable avoidance tools prior to excavation.
2. The exact position of the apparatus should be verified using approved cable avoidance tools prior to excavation using suitable hand tools.
3. It is essential that trial holes are carefully made avoiding the use of mechanical tools or picks until the exact location of all the cables have been determined.
4. It must be assumed that there is a service cable into each property, lamp column and street sign.
5. All cables must be treated as being live unless proved otherwise by UK Power Networks.
6. The information provided must be given to all people working near UK Power Networks plant and equipment. Do not use plants more than 3 months after the issue date for excavation purposes.
7. Please be aware that electric cables/lines belonging to other owners of licensed electricity distribution systems may be present and it is your responsibility to identify their location.
8. Please be aware the Low Voltage Overhead power lines are not currently displayed for the Eastern Region. Please contact the Eastern Region for more information.
9. Please contact the Eastern Region for more information.

1. UK Power Networks does not warrant that the information provided to you is correct. You rely upon it at your own risk.
2. UK Power Networks does not exclude or limit its liability if it causes the death of any persons or causes personal injury to a person.
3. Subject to paragraph 2, UK Power Networks has no liability to you in contract, in tort (including negligence), for breach of duty, property damage or other loss, damages, costs or expenses of any kind or any part of any such loss, damages, costs or expenses, whether or not such loss, damages, costs or expenses are caused wholly or partly by the negligence of UK Power Networks.
4. This plan has been provided to you on the basis of the terms of use set out in the covering letter that must not be used in connection with this plan. The terms of use set out in the covering letter include, but are not limited to, the following: (a) use (including without limitation loss of profit, loss of opportunity, loss of savings, loss of goodwill, loss of business, loss of use) or any special or consequential loss or damage whatsoever.
5. You are responsible for the security of the information provided to you. It must not be given, sold or made available to any person other than the intended recipient of the information. If you are not the intended recipient, you must not use the information and must return it to the sender of the letter.
6. Please Note: The Overview map does not display UK Power Networks electricity network and should not be used for navigation purposes. For details of the electricity network please view the relevant pages highlighted in the Overview map.




IF IN DOUBT - ASK! PHONE
0800 056 5866
EMERGENCY - If you damage a
cable or line
Phone 0800 783 8838 (24hrs)
URGENTLY

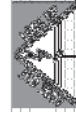

Maps produced at 1:2500 scale are Geo-Schematics which show LV mains cables and overhead lines (in some cases all voltages). Prior to carrying out excavations you must refer to the 1:500 records to determine the location of all known underground plant and equipment.

Reproduced by permission of Ordnance Survey on behalf of HMSO. All rights reserved. Ordnance Survey Licence number: 100019626. Data has been added to the Ordnance Survey base map. All proprietary rights in such additional data are and shall remain the exclusive property of the copyright owner. © Crown copyright and database rights: 2023. All rights reserved. Ordnance Survey Licence number: 100019626. Data has been added to the Ordnance Survey base map. All proprietary rights in such additional data are and shall remain the exclusive property of the copyright owner. © London Power Networks plc or South Eastern Power Networks plc. All rights in such data reserved.

Plans generated by DigSAFE Pro™ software provided by LinesearchbeforeUdig.
Distribution licensee under section 61(c) of the Electricity Act 1989 for the relevant

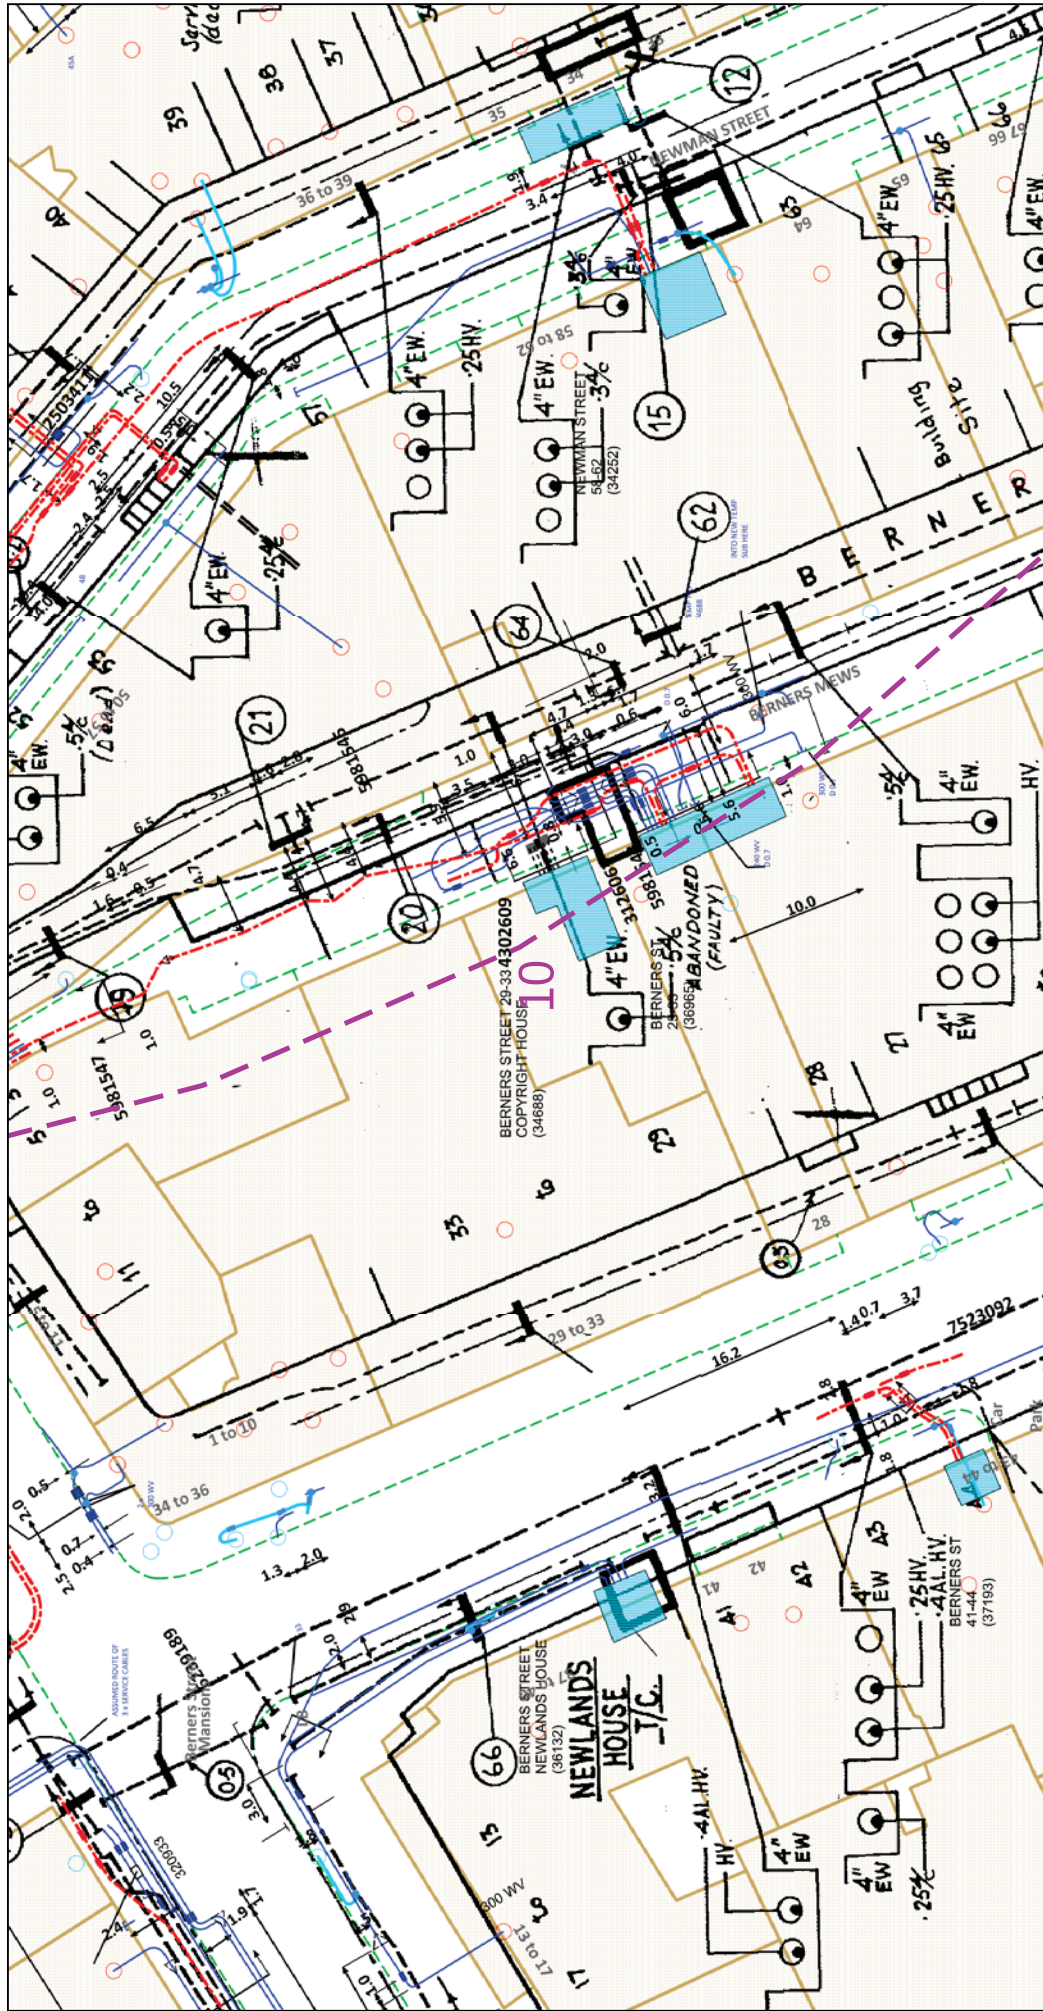



IF IN DOUBT - ASK! PHONE
0800 056 5866
EMERGENCY - If you damage a cable or line
Phone 0800 781 8638 (24hrs)
URGENTLY

ALWAYS LOOK UP BEFORE YOU START WORK
Refer to HSE Guidance note G56

Maps produced at 1:2500 scale are Geo-Schematics which show LV main cables and overheads. They are not intended to be used for design or construction purposes. They are to be used to determine the location of all known underground plant and equipment.

The quality and accuracy of any print will depend on your printer, your computer and its print settings. Measurements scaled from this plan may not match measurements between the same points on the ground.


1. UK Power Networks does not warrant that the information provided to you is correct. You rely upon it at your own risk.
2. UK Power Networks does not exclude or limit its liability if it causes the death of any persons or causes personal injury to a person.
3. Subject to paragraph 2 UK Power Networks has no liability to you in contract, in tort (including negligence), for breach of statutory duty or otherwise for any loss, damage, cost, claims, demands, or expenses that you or any third party may suffer or incur as a result of using the information provided whether for physical damage to property or for any economic loss, including special or consequential loss, opportunity, loss of savings, loss of goodwill, loss of business, loss of profit, loss of income, loss of reputation, or any other loss, damage, cost, claims, demands, or expenses that you or any third party may suffer or incur as a result of using the information provided.
4. This plan has been provided to you on the basis of the terms of use set out in the covering letter that accompanies this plan. If you do not accept and/or do not understand the terms of use set out in the covering letter you must not use the plan and must return it to the sender of the letter.
5. You are responsible for the security of the information provided to you. It must not be given, sold or made available to any third party without the prior written consent of UK Power Networks.
6. Please Note: The Overview map does not display UK Power Networks electricity network and should not be used for the location of UK Power Networks assets. For detail of the electricity network please view the relevant page as highlighted in the Overview map.

1. The position of the apparatus shown on this drawing is believed to be correct but the original landmarks may have been altered since the apparatus was installed.
2. The position of the apparatus shown on this drawing is believed to be correct but the original landmarks may have been altered since the apparatus was installed.
3. It is essential that trial holes are carefully made avoiding the use of mechanical tools or picks until the exact location of all the cables have been determined.
4. It must be assumed that there is a service cable into each property, lamp column and street sign.
5. All cables must be treated as being live unless proved otherwise by UK Power Networks.
6. The information provided must be given to all people working near UK Power Networks plant and equipment. Do not use plants more than 3 months after the issue date for excavation purposes.
7. Please be aware that electric cables/lines belonging to other owners of licensed electricity distribution systems may be present and it is your responsibility to identify their location.
8. The information provided is for the use of the Eastern Region via this service. If you require records on the location of these please contact our Plan Provision team directly via plans@ukpowernetworks.co.uk.

This plan must be used with the attached 'Symbols' document.

Date Requested: 14/06/2023
Job Reference: 29816993
Site Location: 529346 181501
Requested by: Mr Ben Evans
Your Scheme/Reference: LM 205728/KaY
Scale: 1:500 (When plotted at A4)

Reproduced by permission of Ordnance Survey on behalf of HM50. © Crown copyright and database rights 2023. All rights reserved. Ordnance Survey Licence numbers 100019626 and 100019450. Data has been added to the Ordnance Survey base map; all proprietary rights in such additional data are and shall remain the exclusive property of © London Power Networks Plc or Eastern Power Networks Plc each being a distribution licensee under the Electricity Act 1989. For further information on distribution services area as that term is defined in such licensee's distribution licence. All rights in such data reserved.
Plans generated by DigSAFE Pro - software provided by Lineascharterofordale.

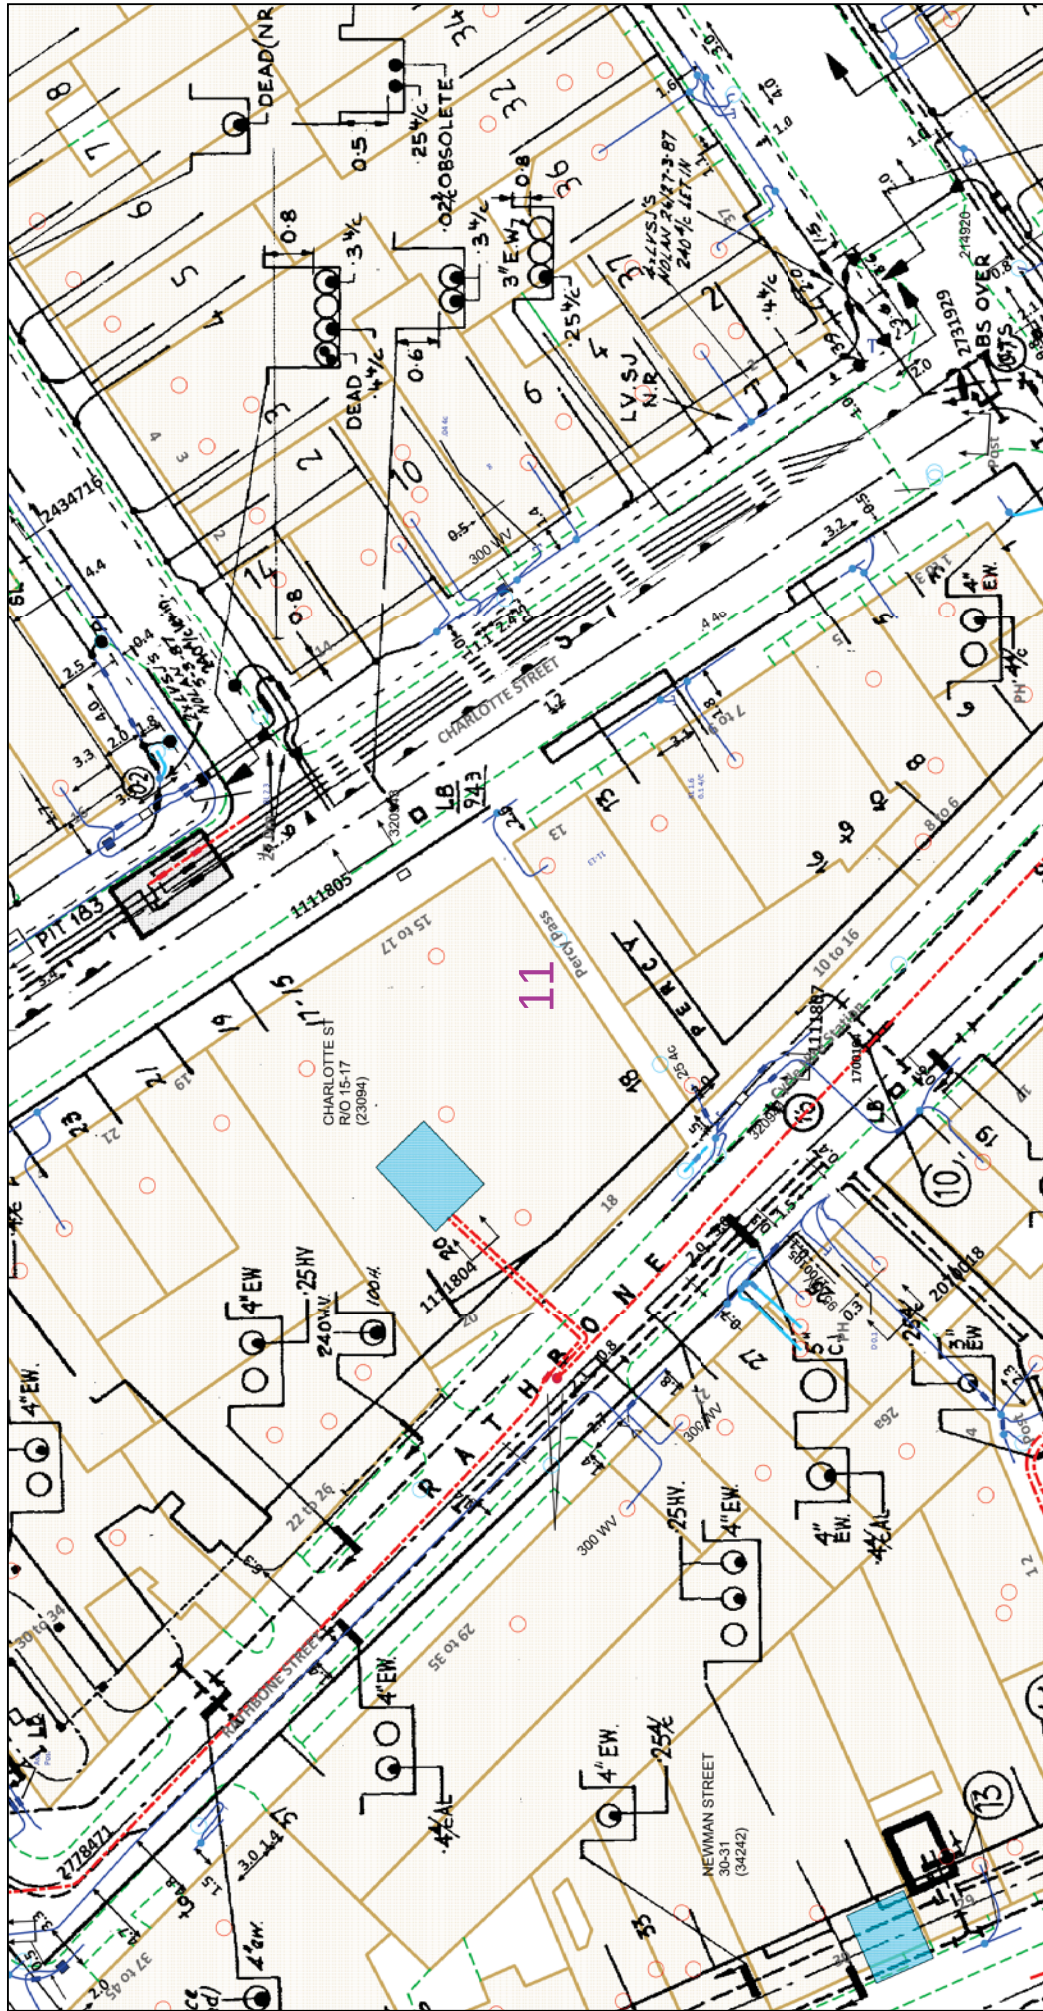



IF IN DOUBT - ASK! PHONE
0800 056 5866
EMERGENCY - If you damage a
cable or line
Phone 0800 781 8638 (24hrs)
URGENTLY

Maps produced at 1:2500 scale are Geo-Schematics which show LV main cables and overhead
cables and their connections to the 1500
records to determine the location of all known underground plant and equipment.

ALWAYS LOOK UP
BEFORE
YOU START WORK
Refer to HSE Guidance
note G56



The quality and accuracy of any print will depend on your printer, your computer and its print
settings. Measurements scaled from this plan may not match measurements between the same
points on the ground.

1. UK Power Networks does not warrant that the information provided to you is correct. You rely upon it at your own
risk. UK Power Networks does not exclude or limit its liability if it causes the death of any persons or causes personal injury
to a person.
2. Subject to paragraph 2 UK Power Networks has no liability to you in contract, in tort (including negligence), for breach
of statutory duty or otherwise for any loss, damage, cost, claims, demands, or expenses that you or any third party may
suffer or incur as a result of using the information provided whether for physical damage to property or for any economic
loss, including special or consequential loss, loss of opportunity, loss of savings, loss of goodwill, loss of business, loss
of profit, loss of income, loss of reputation, loss of data, loss of information, loss of time, or any other loss or damage.
3. This plan has been provided to you on the basis of the terms of use set out in the covering letter that accompanies
this plan. If you do not accept and/or do not understand the terms of use set out in the covering letter you must not use
the plan and must return it to the sender of the letter.
4. You are responsible for the security of the information provided to you. It must not be given, sold or made available
to any other person without the prior written consent of UK Power Networks.
5. Please Note: The Overview map does not display UK Power Networks electricity network and should not be used for
the location of UK Power Networks assets. For detail of the electricity network please view the relevant page as
highlighted in the Overview map.

1. The position of the apparatus shown on this drawing is believed to be correct but the original
drawings may have been altered since the apparatus was installed.
2. The position of the apparatus shown on this drawing is believed to be correct but the original
drawings may have been altered since the apparatus was installed.
3. It is essential that trial holes are carefully made avoiding the use of mechanical tools or picks
until the exact location of all the cables have been determined.
4. It must be assumed that there is a service cable into each property, lamp column and street sign,
etc. All cables must be treated as being live unless proved otherwise by UK Power Networks.
5. The information provided must be given to all people working near UK Power Networks plant and
equipment. Do not use plans more than 3 months after the issue date for excavation purposes.
6. Please be aware that electric cables/lines belonging to other owners of licensed electricity
distribution systems may be present and it is your responsibility to identify their location.
7. This plan is provided to you as a service to the Eastern Region via this service. If you require records on the location of these please contact our Plan
Provision team directly via plans@ukpowernetworks.co.uk.

This plan must be used with the
attached 'Symbols' document.

Date Requested: 14/06/2023
Job Reference: 29816993
Site Location: 520346 181501
Requested by: Mr Ben Evans
Your Scheme/Reference: LM
205728/KaY
Scale: 1:500 (When plotted at A4)

Reproduced by permission of Ordnance Survey on behalf of HM50. © Crown copyright and database rights 2023. All rights reserved. Ordnance Survey base map; all proprietary rights in such additional data are and shall remain the exclusive property
of © London Power Networks Plc or Eastern Power Networks Plc or South Eastern Power Networks Plc each being a distribution licensee under the Electricity Act 1989 or other relevant distribution services area as that term is defined in the Electricity Act 1989.
Plans generated by DigSAFE Pro - software provided by Linesearchforcode.

