




- Existing (Blue lines & hatches)
 - Demolition (Red lines & hatches)
 - New (Black Lines & hatches)
 - Client Supply Furniture
 - CHR demise
 - Outside of scope
- Demolish floor finishes
 - Demolish floor and slab
 - Skirting Board to be removed

- Wall Fire Resistance Performance
- * Fire Door Performance see door types drawing
- 120 Minutes
 - 90 Minutes
 - 60 Minutes
 - 30 Minutes


- NOTES
- For Floor Finishes refer to drawing no. 35001
- For partition and wall types refer to drawing no. 26001.
- Proposed rooftop above seating area
 - 1.4 ramp to gain 2m head height below beam.
 - Works to external moat should include. Cleaning of all wall & stonework. Repainting all render white & replacing any rusting elements of metalwork
 - Sika Cavity damproofing to full Keppel Street elevation within project scope

P3	Condensor tag added	12/10/23	TR
ST4_T2	Menu Screens	12/09/23	TR
ST4_T1	High tables made client supply & Room Numbers	12/09/23	TR
ST4_T	Tender	12/07/23	NV
ST4_F	STAGE 4 FINAL ISSUE	21/06/23	NV
ST4_F	STAGE 4 FINAL ISSUE	16/06/23	NV
ST4_A	STAGE 4 DRAFT	07/06/23	TR
ST4	STAGE 4 DRAFT PLANNING	23/05/23	OR
ST3	STAGE 3 ISSUE	10/03/23	OR
ST3	STAGE 3 DRAFT	24/02/23	OR
ST3	STAGE 3 DRAFT	22/02/23	OR
PR4	MD STAGE 3 PLAN	14/02/23	OR
PR3	UPDATED PLAN	09/02/23	OR
PR2	FIRE APP	13/11/22	OR
PR1	STAGE 2 ISSUE	04/11/22	TR
A	STAGE 2 DRAFT	26/10/22	TR
REVISIONS		DATE/DRAWN	

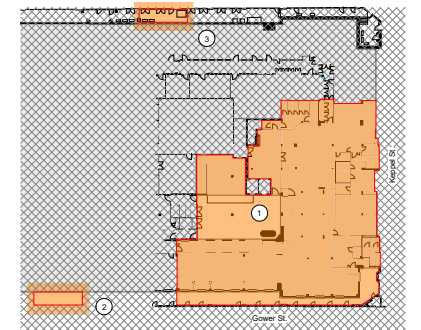


Key Plan

PROJECT	LSHTM Social Space KS3D
	Keppel Street, WC1E 7HT
DRAWING TITLE	Proposed GA Plan
	Lower Ground Floor
DATE	OCT 22
DRAWN	PP
SCALE	As indicated
	@ A1
CHECK	
STATUS	STAGE 4
RT JOB NO.	RT22042
REVISION	P3
DRAWING NO.	PH3D-RTA-XX-LG-DR-A-00405

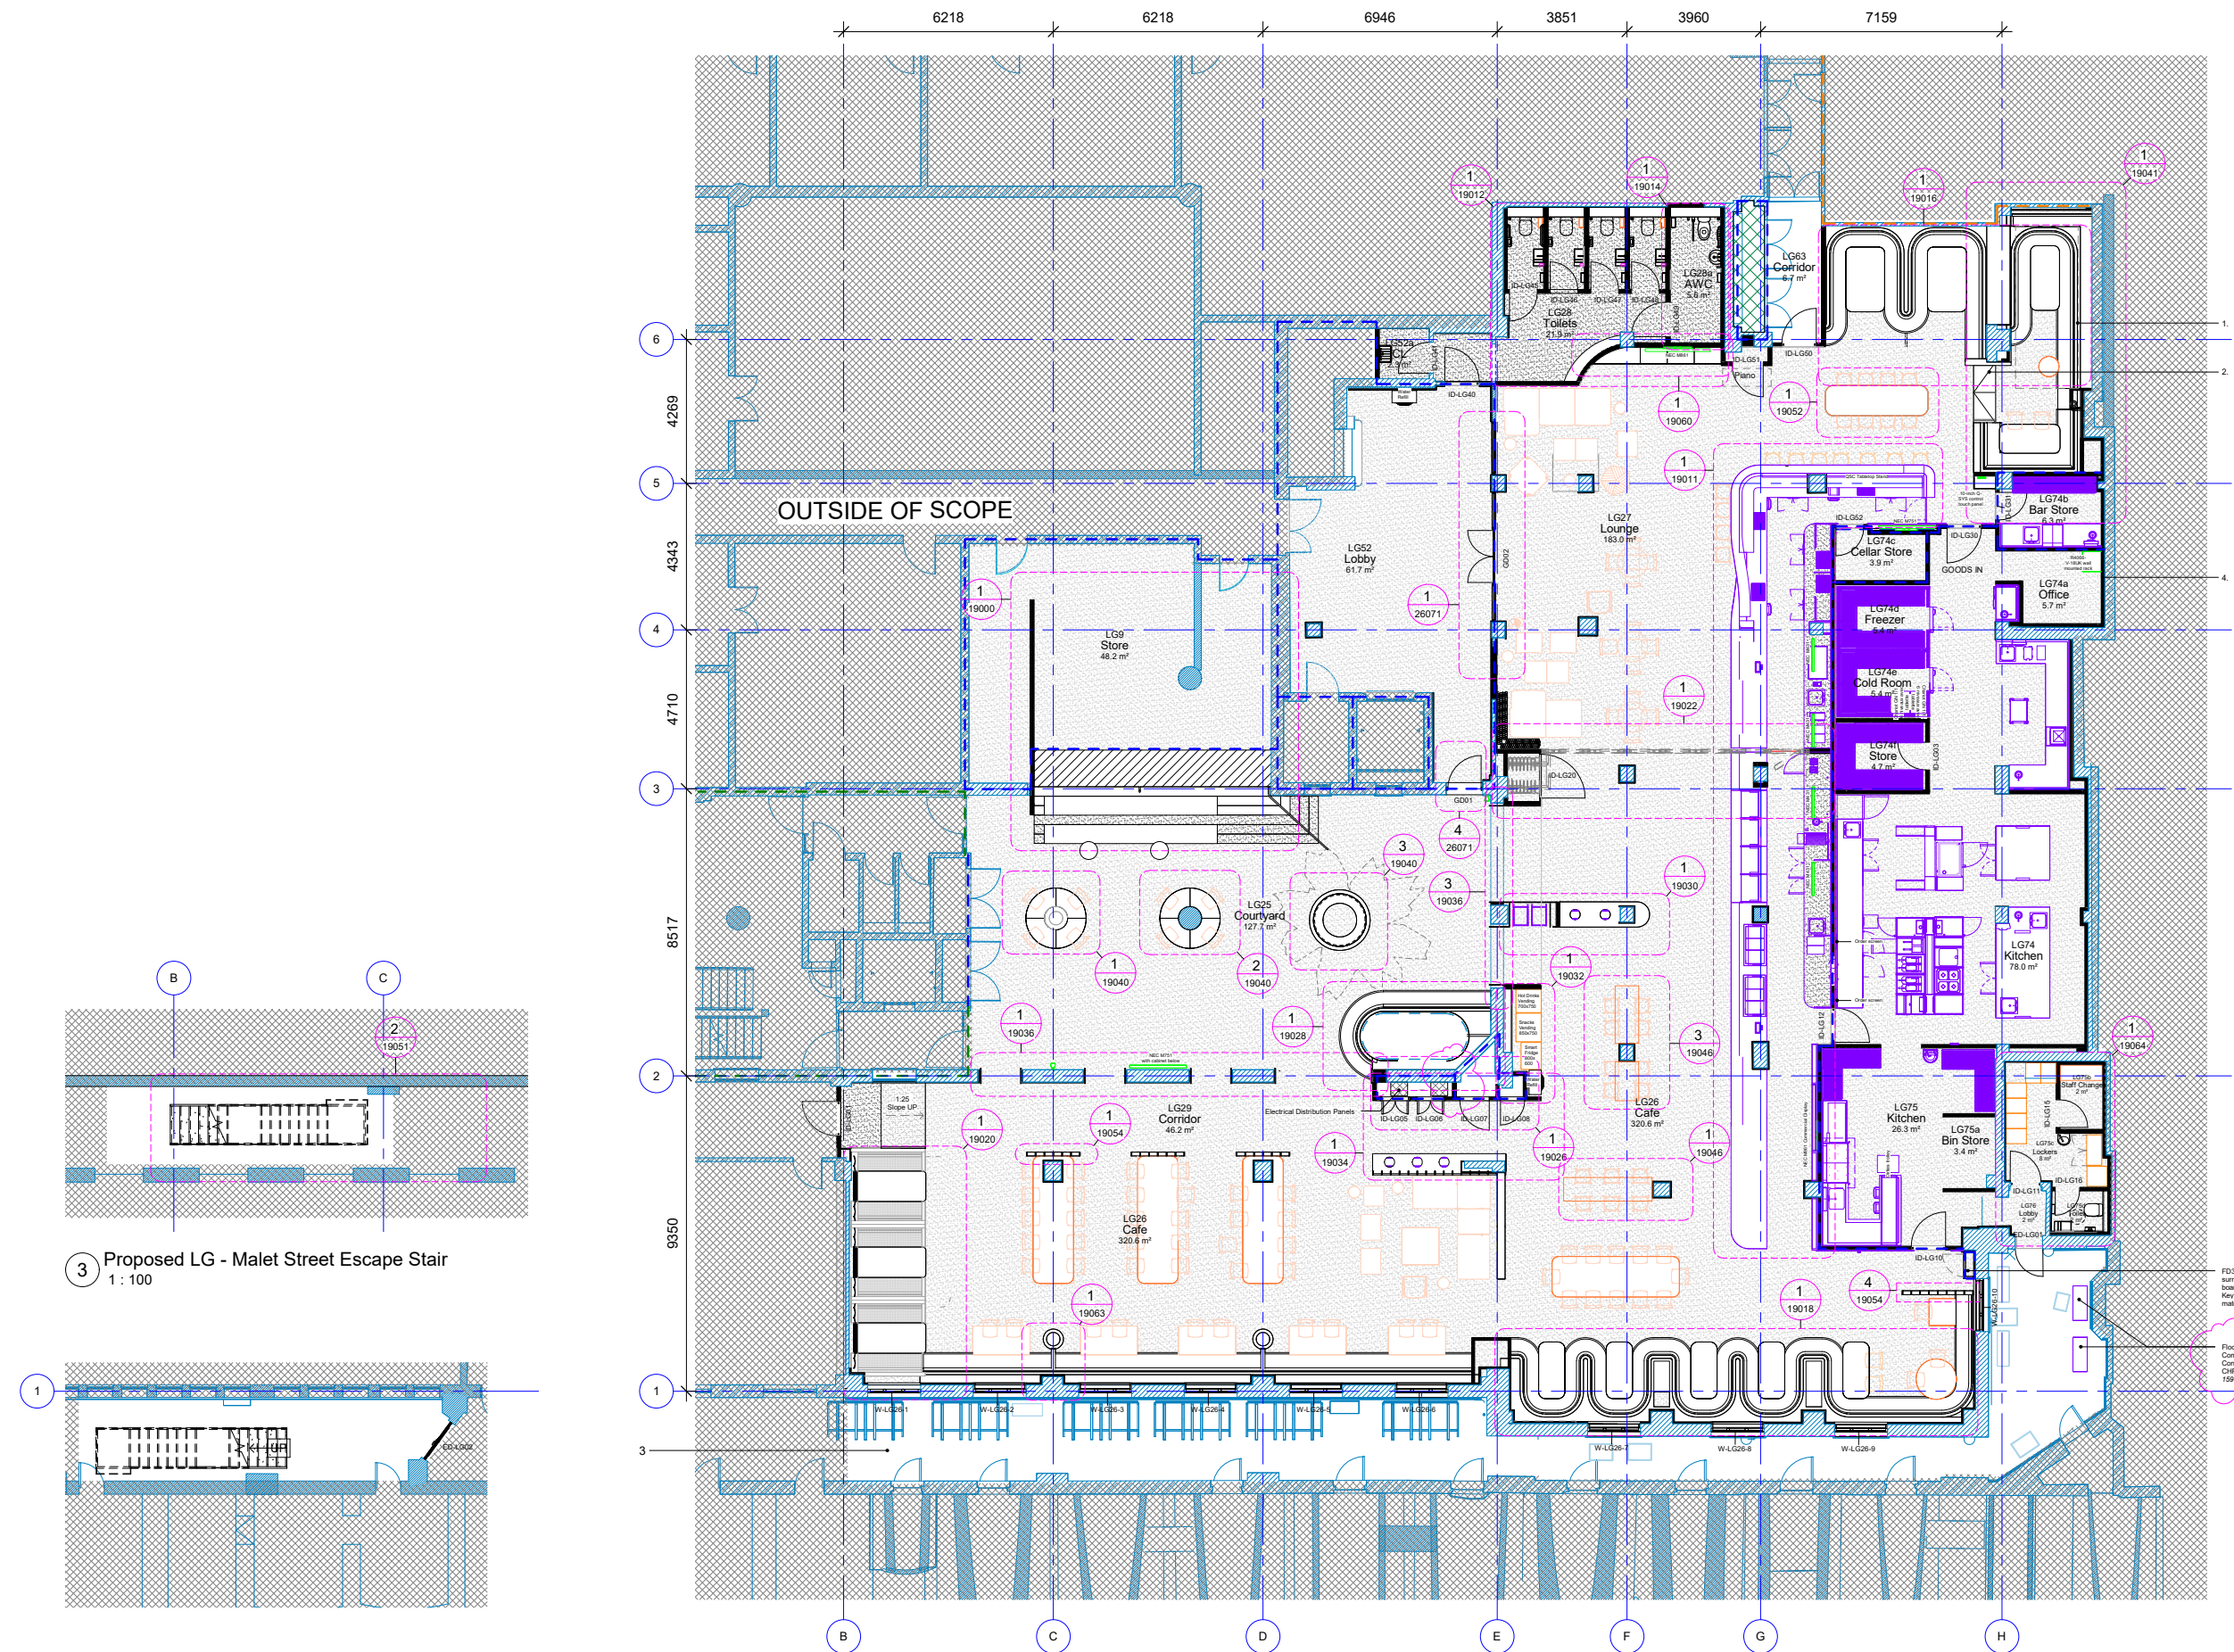

3 Proposed LG - Malet Street Escape Stair
1: 100

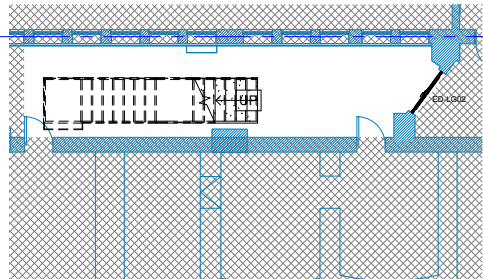

2 Proposed LG - Gower Street Escape Stair
1: 100

1 Proposed GA - Lower Ground
1: 100