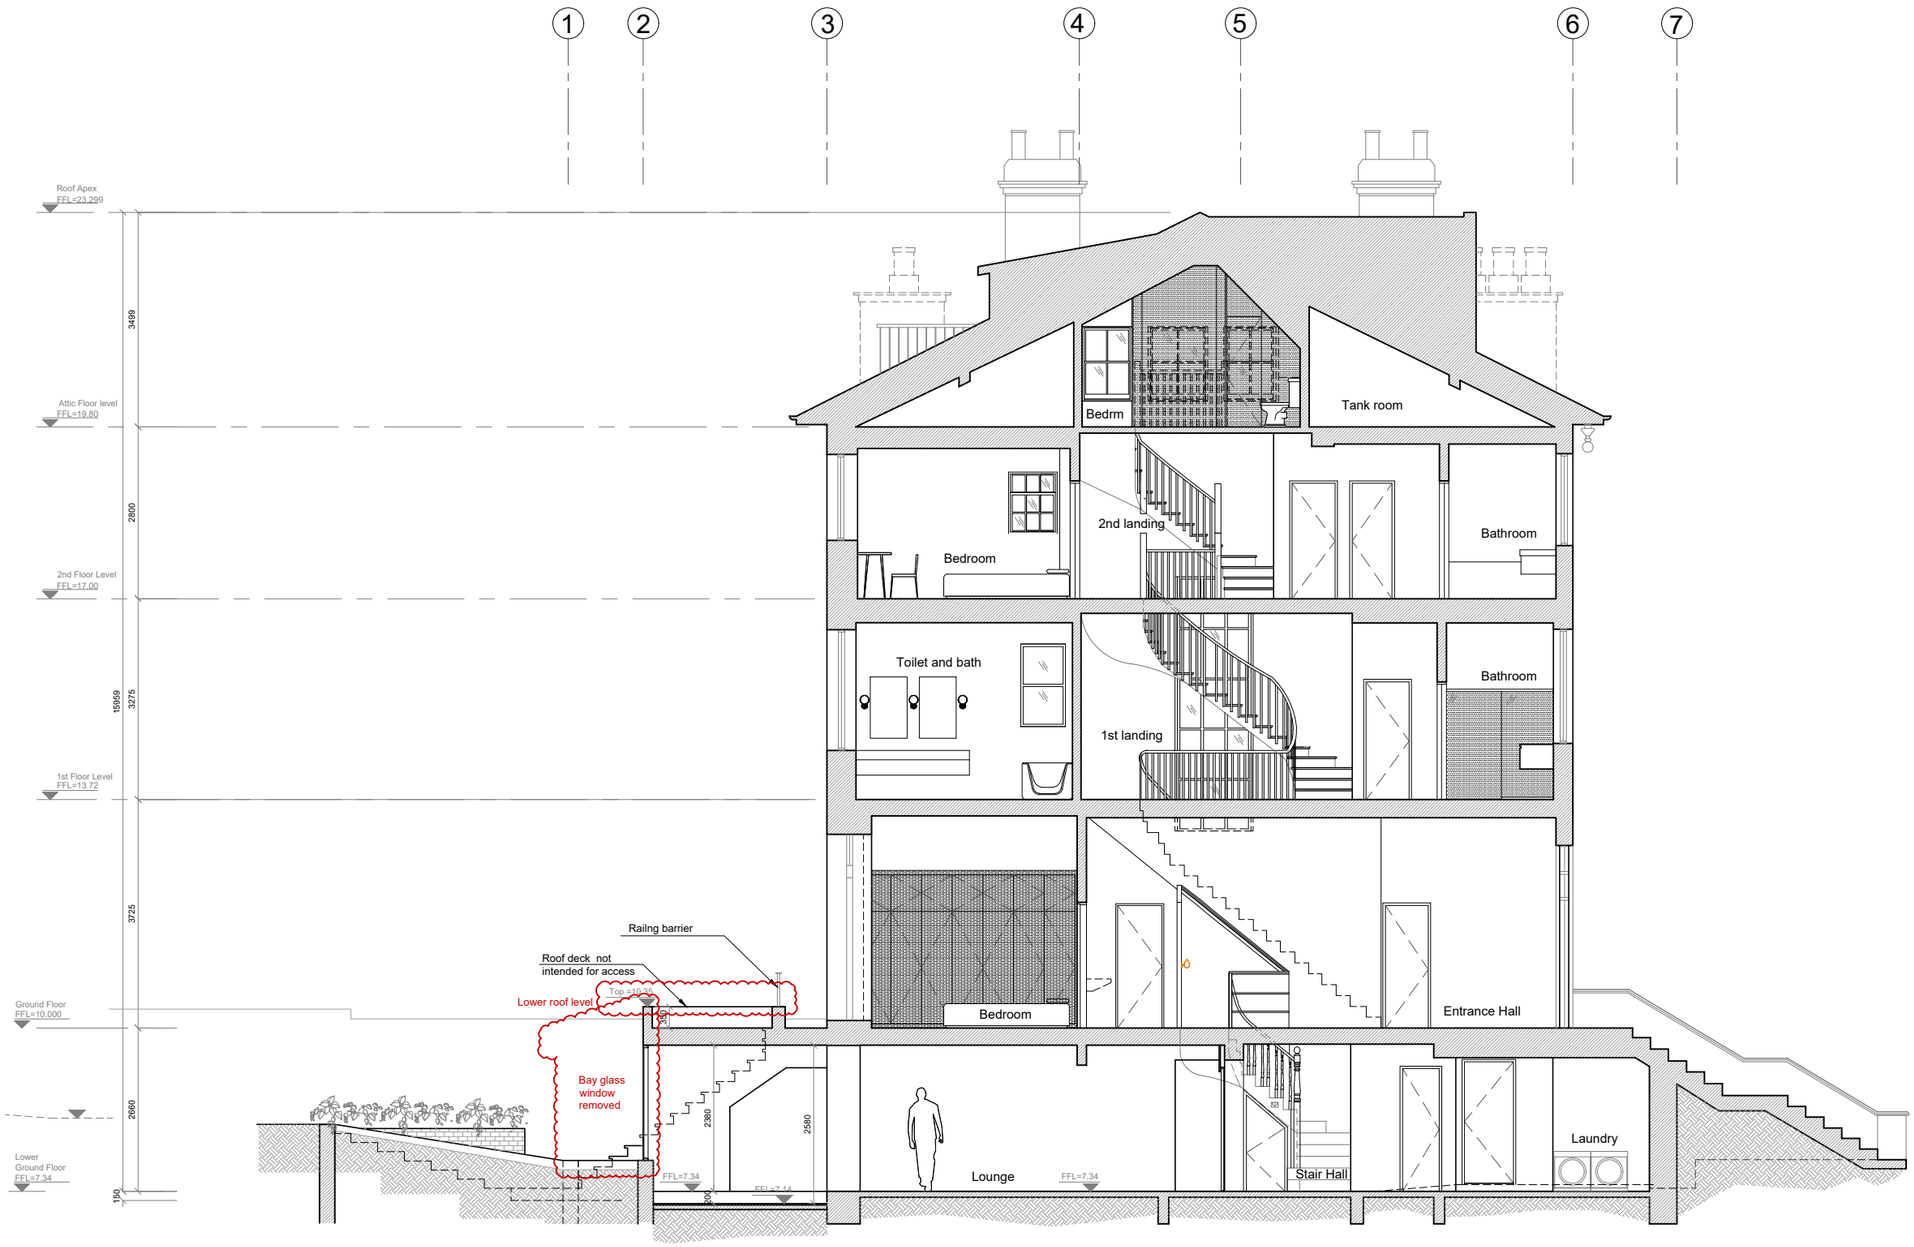


PROPOSED

# SECTION THROUGH - A

SCALE: 1:100 on A3

CONCEPTUAL


1. All designs, drawings, plans, sketches, 3d drawings and suggested materials, etc. are the intellectual property of the Architect / Interior designer, and are not to be totally nor partially in any manner reproduced or copied by the client or his subordinates or subcontractors.
2. All documents and conceptions mentioned in this contract can be used solely for the realization of this specific project. The copyright of all documents referred to in this contract shall remain solely with the Architect / interior designer.
3. The dimensions given in this drawing should be checked on site. The Architect / interior designer is not held responsible for any inaccuracy in the dimensions.


| Rev | Date | Revision |
|---|---|---|


Architectural Design By

ANNAKA FZCO

ANNAKA fzco
A Office no 632 6th floor
Block 6 B East Wing 6
DAFZA Dubai UAE

www.annabelkassar.com
T + 971 4 299 3 288
F + 971 4 299 3 289
p.o.box 293664 dubai uae


Owner

Project
PRIVATE RESIDENCE

Project Location
FLAT 11 , ELSWORTHY ROAD, PRIMROSE HILL , NW3 , LONDON

Drawing Title
PROPOSED SECTION A - A

Purpose of issue
*Information* ○ *Preliminary* ○ *Approval* ○ *Tender* ○ *Construction* ○ *Record Copy* ○

| Date | Drawn | Scale | Checked |
|---|---|---|---|
| 21.09.2023 | | As Shown | |

Drawing no.
**A-400**

Rev
**F**