FLOORING LEGEND

- FLOOR TYPE A - raised floor new polished metal pan
- FLOOR TYPE B - raised floor with ditramat and porcelain tiles.
- FLOOR TYPE D - Power floated concrete with UFH.
- FLOOR TYPE J -Altro vinyl
- FLOOR TYPE E - Balon tiles on existing prepared concrete.
- FLOOR TYPE F - Joinery timber steps.

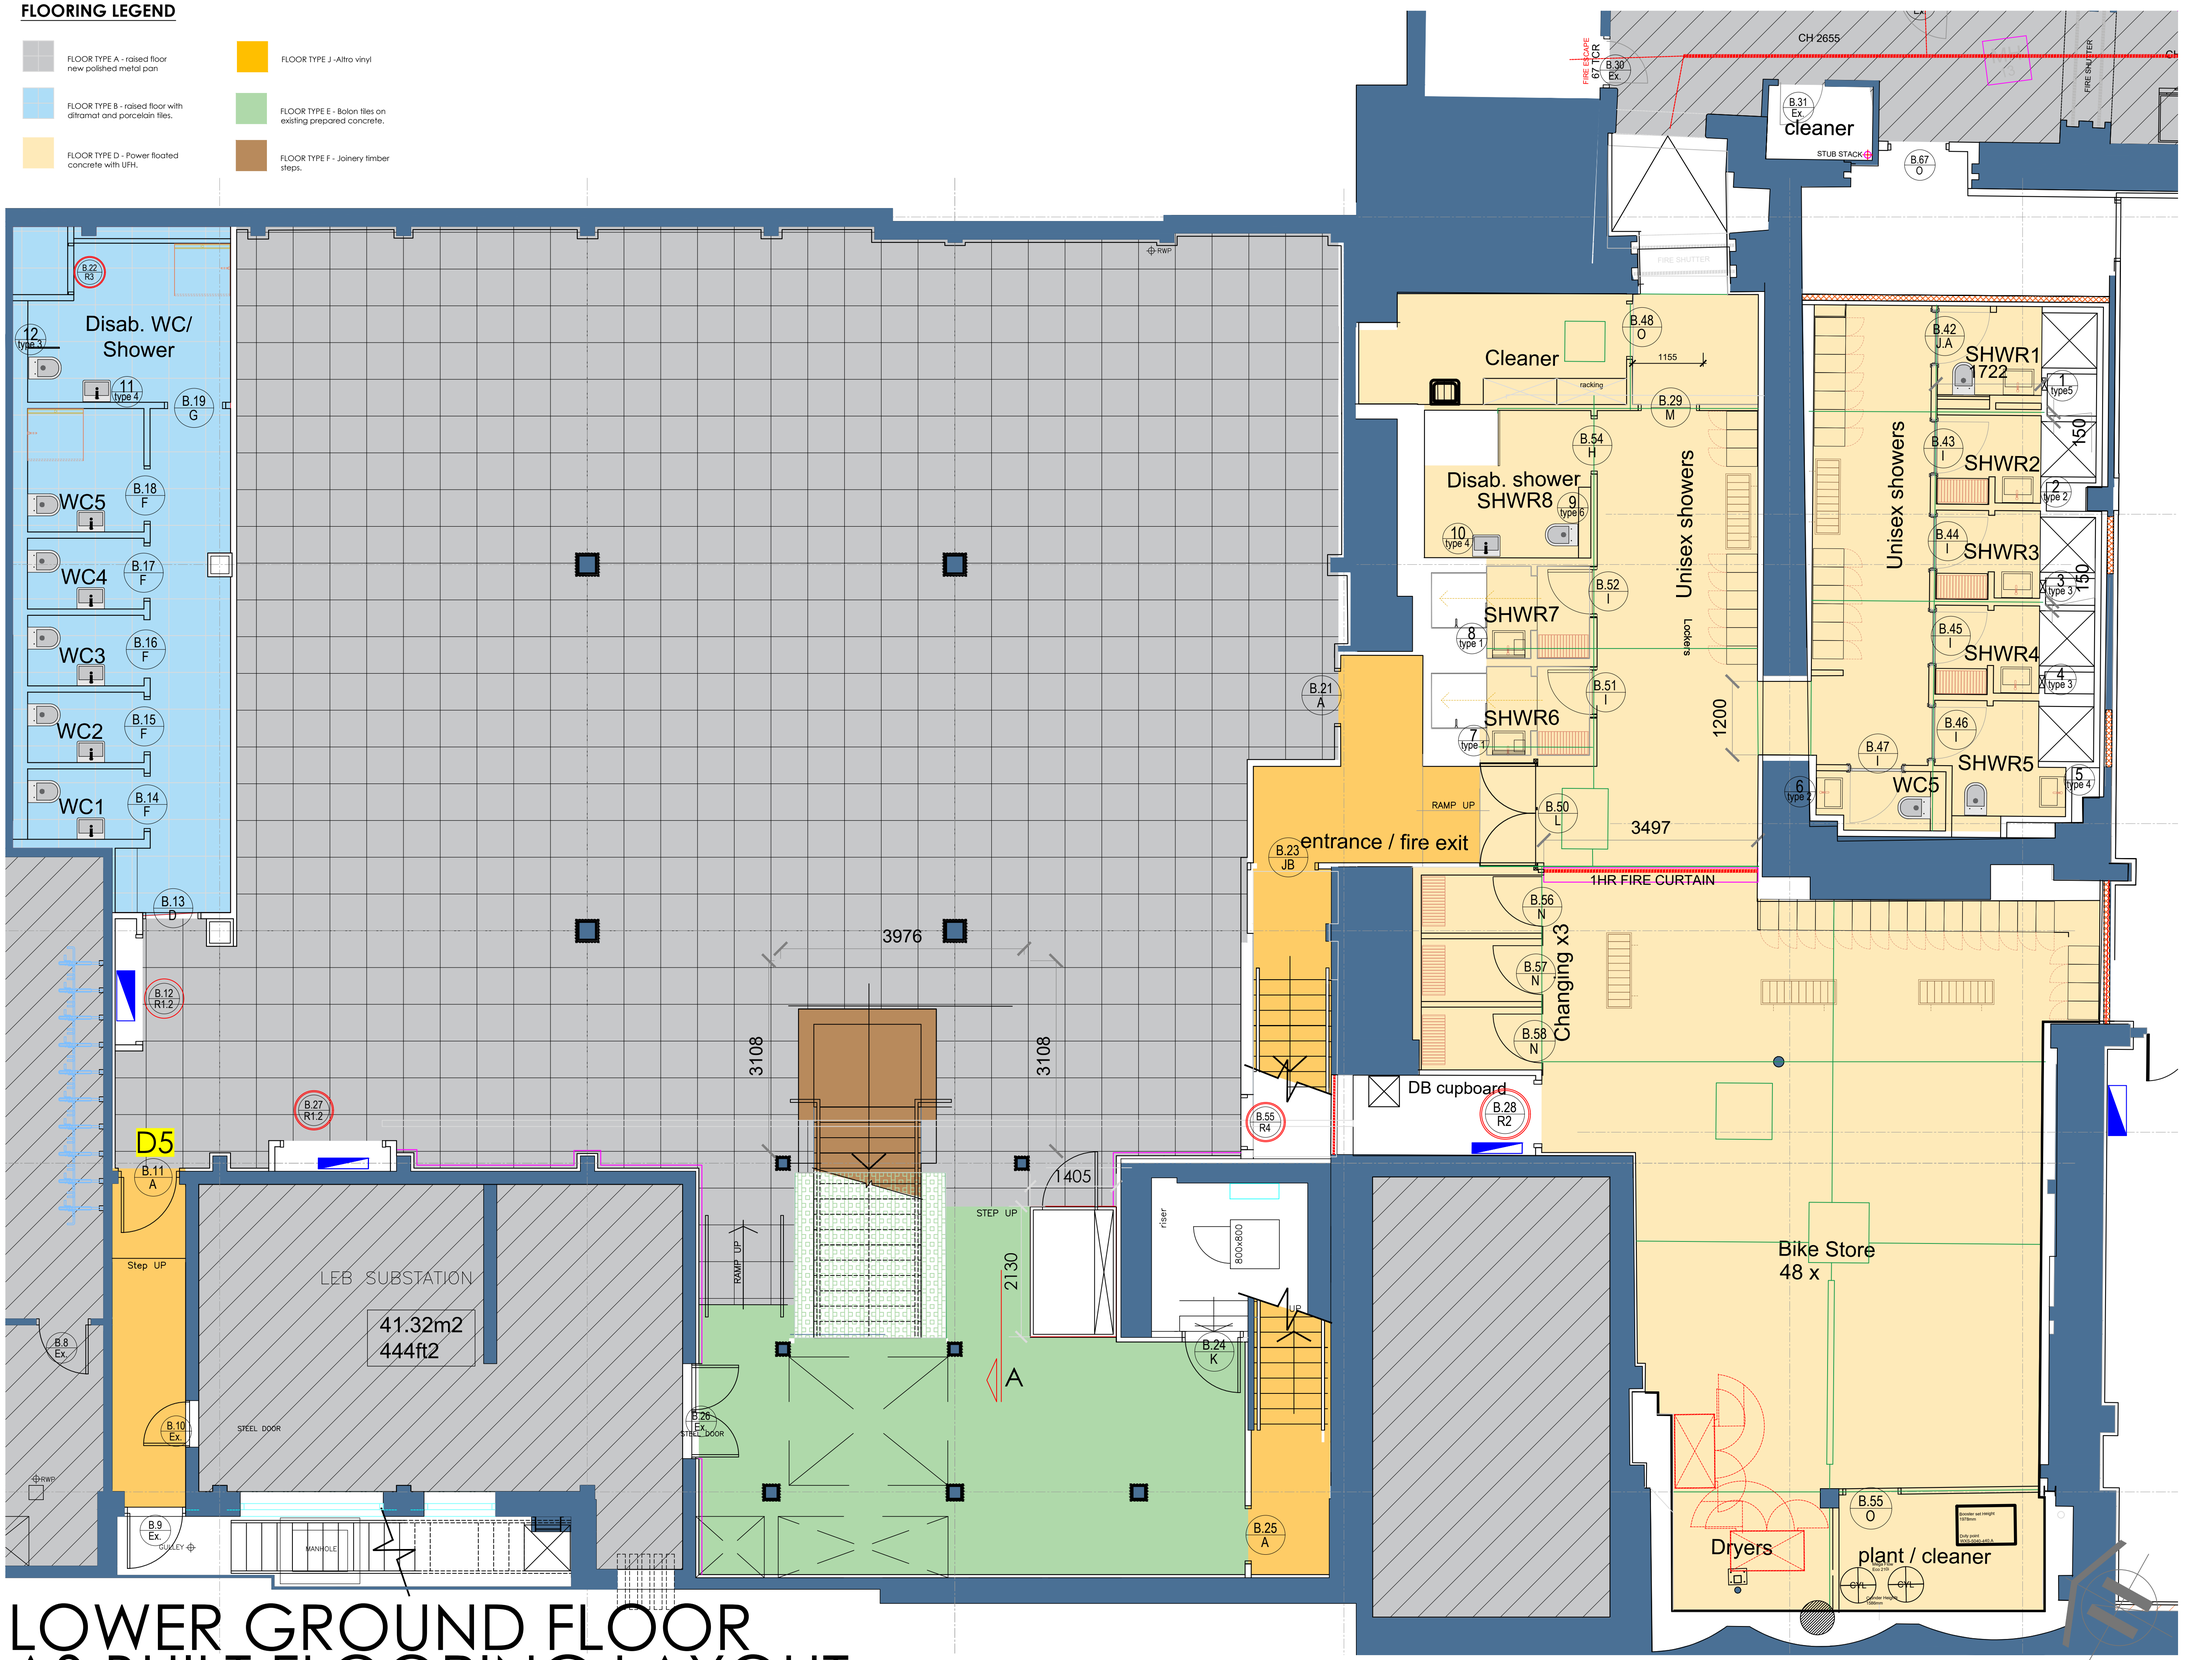

LOWER GROUND FLOOR AS BUILT FLOORING LAYOUT

THIS DRAWING REMAINS THE PROPERTY OF **BASE INTERIORS LTD.** IT MAY NOT BE COPIED OR REPRODUCED WITHOUT EXPRESS WRITTEN CONSENT. FIGURED DIMENSIONS SHOULD BE USED WHERE GIVEN. DO NOT SCALE.

Estates & Agency
CLIENT

38 Whitfield Street
London W1T 2RH
SITE ADDRESS

AS BUILT
LOWER GROUND FLOOR
DRAWING TITLE

EAA 516	LG 005
PROJECT NO.	DRAWING NO
1:50 on A1	Floor finishes
SCALE	DESCRIPTION
AV	16.01.2020
DRAWN	DATE

T. 020 7487 3222
F. 020 7487 3555
BASEINTERIORS
BASE
15 BERKELEY MEWS LONDON W1H 7AX