All Souls Church

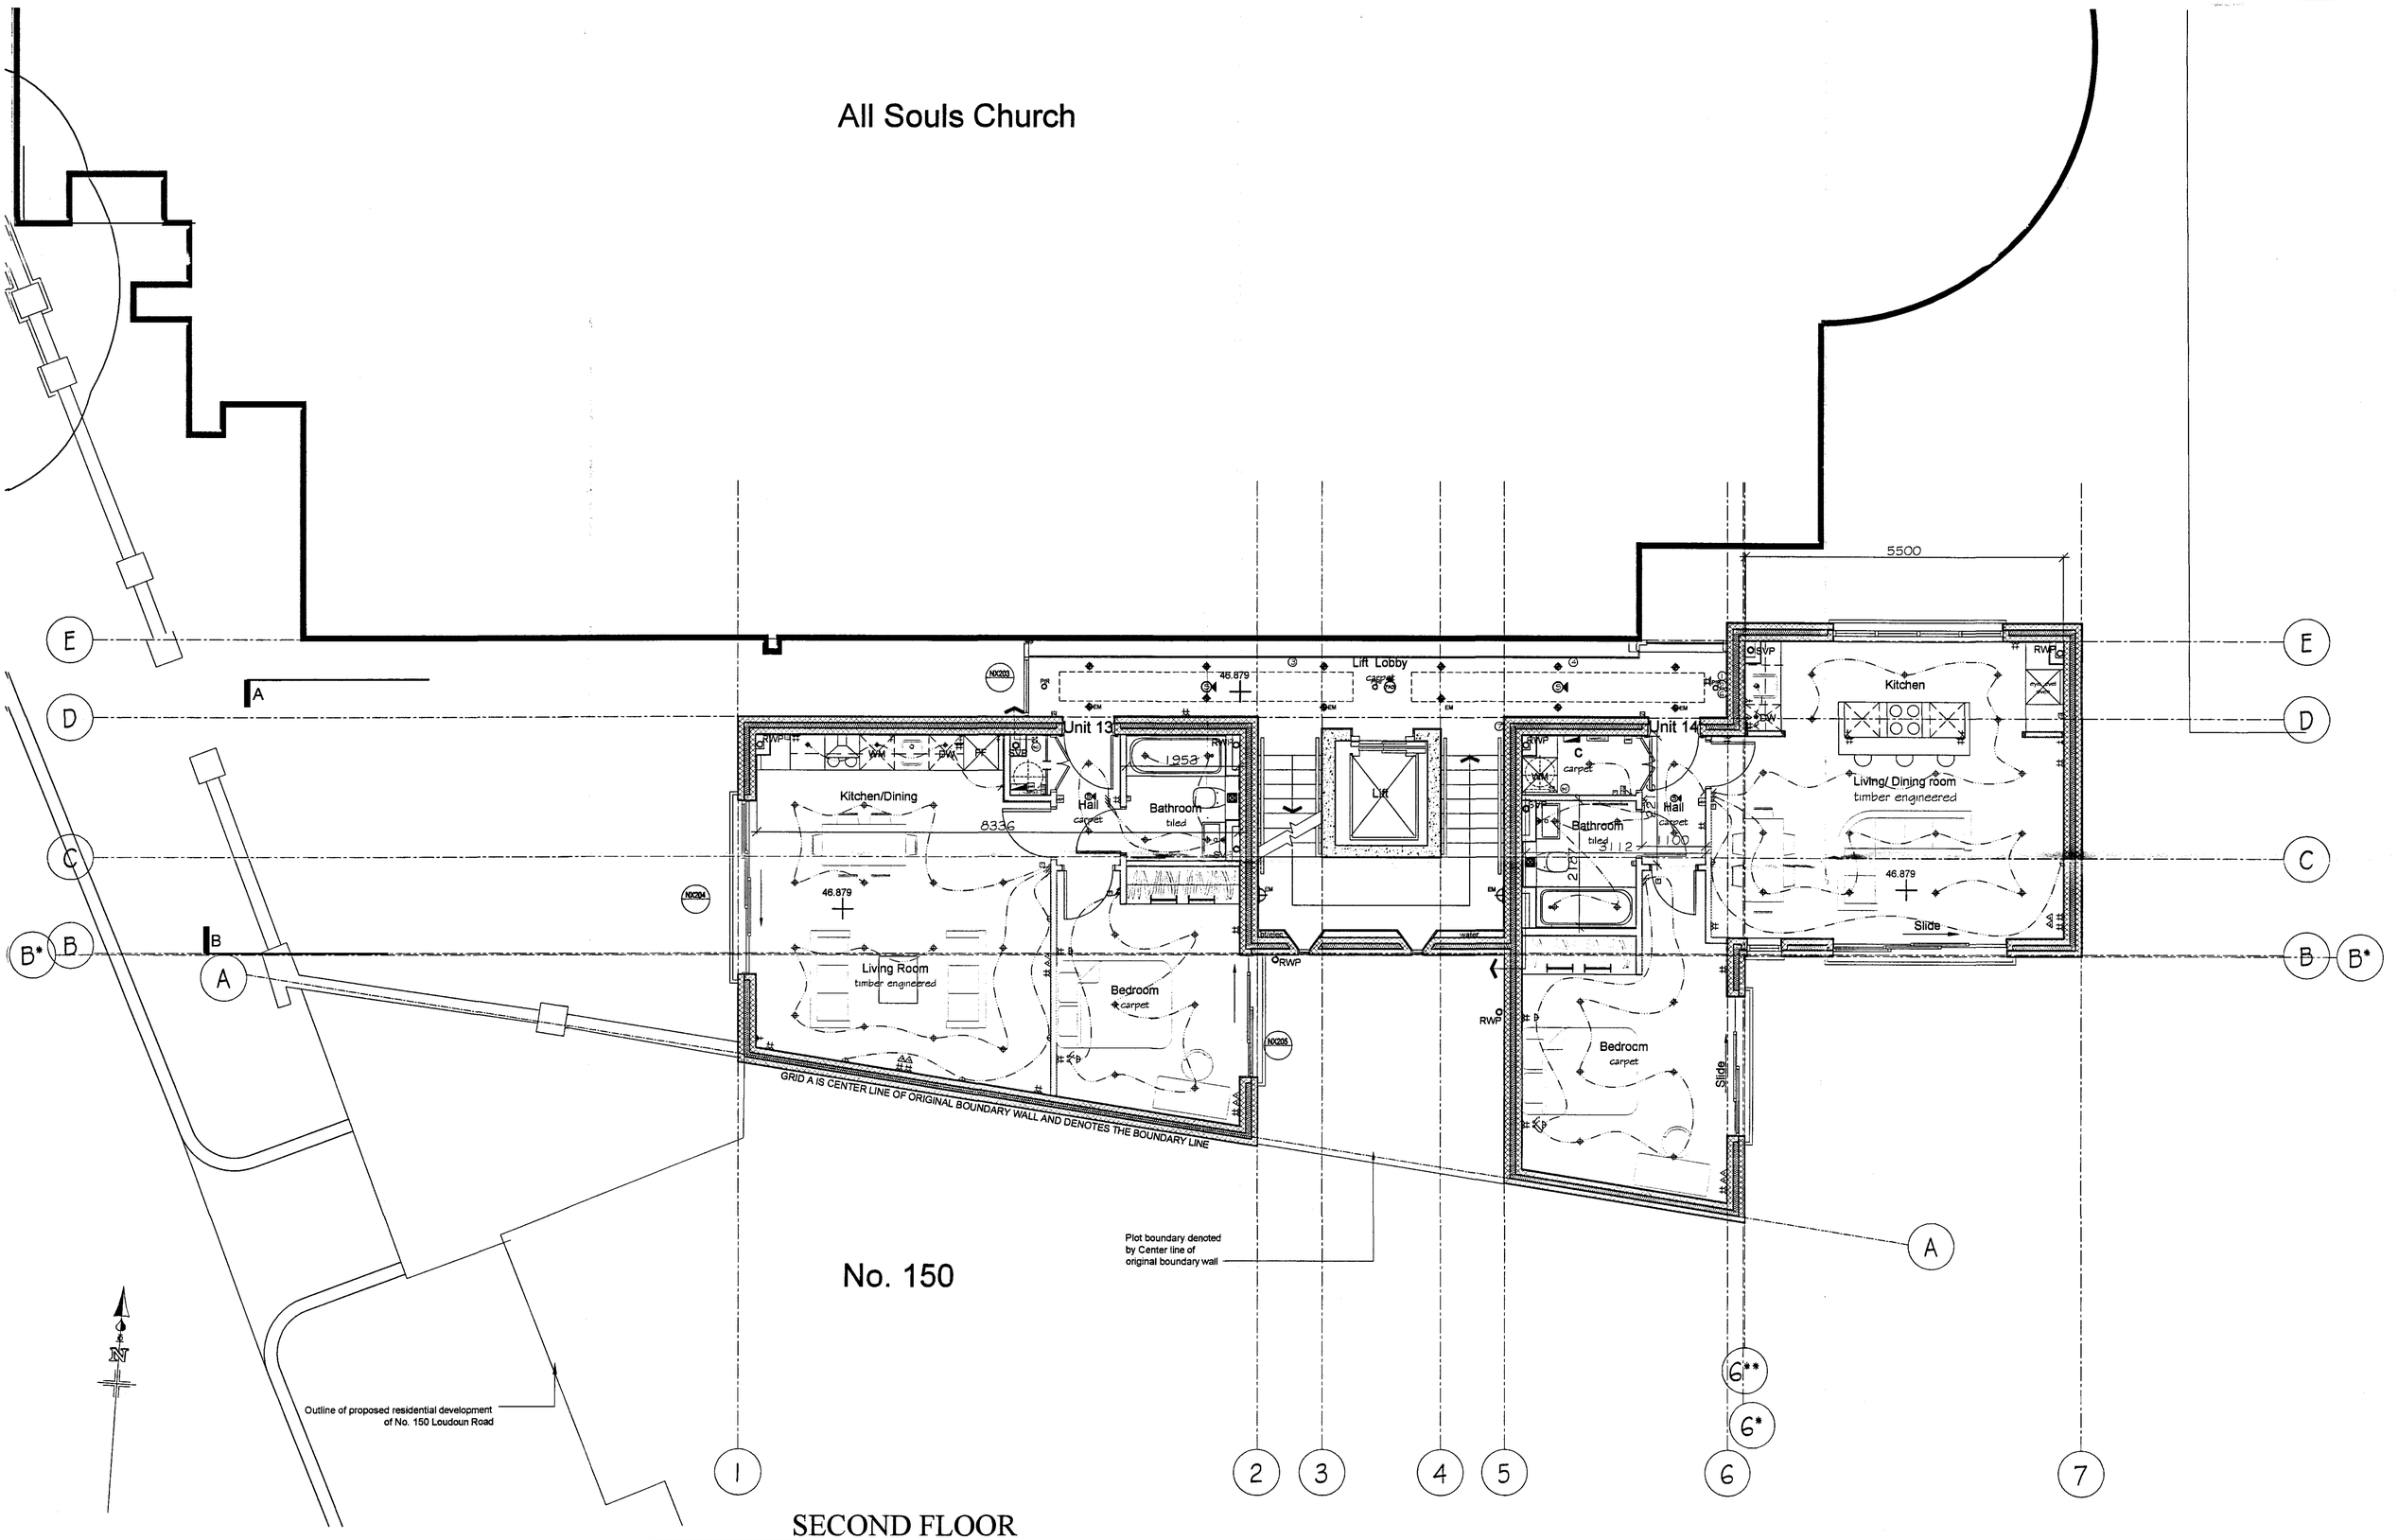

SECOND FLOOR

Notes No scaled dimensions to be taken from this drawing. All dimensions to be site checked.

Rev	Date	Revision	Initials	Rev	Date	Revision	Initials

project
ALL SOULS CHURCH
Loudoun Road
London
NW8

client

drawing
AS BUILT
SECOND FLOOR PLAN

date	scale	drawn	checked
10.09	1:50	LB	JE

job no	drawing no	rev
6761	233	

METROPOLITAN DEVELOPMENT CONSULTANCY
66 Bickenhall Mansions,
Bickenhall Street.London. W1U 6BX
Telephone: 020 7486 6675
Fax: 020 7486 7206
Email: surveyors@mdclondon.com