


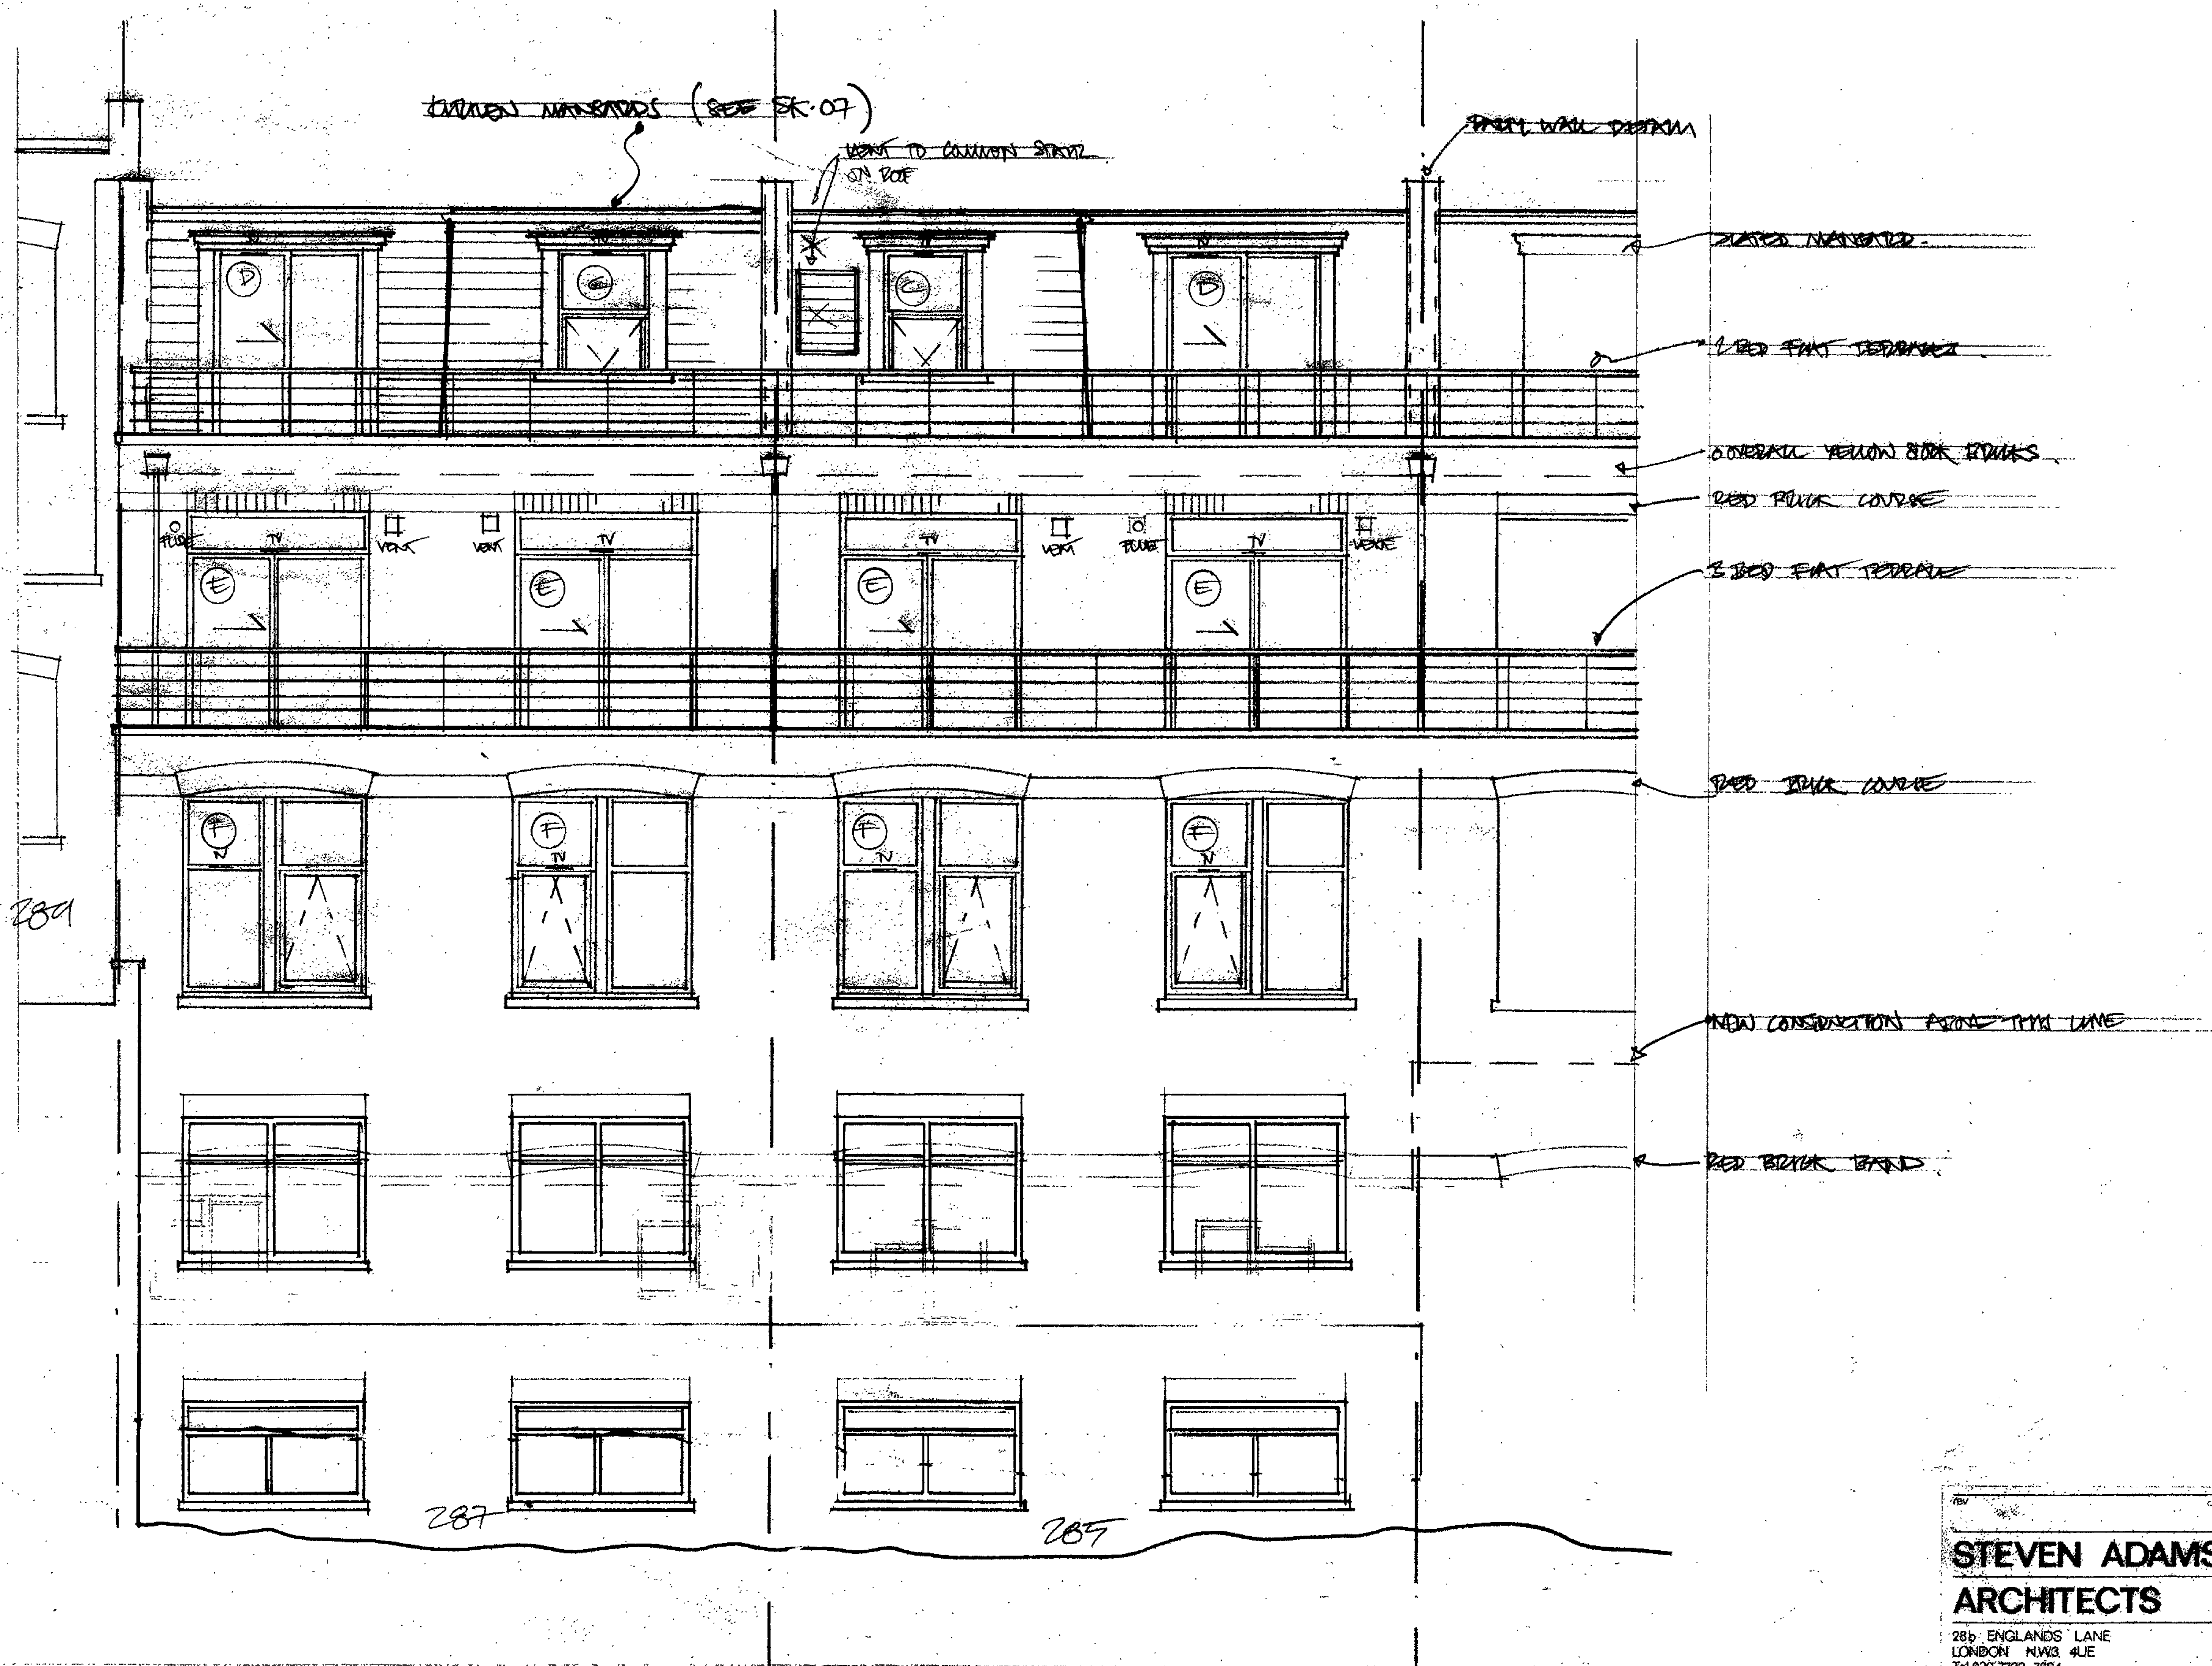

STEVEN ADAMS RIBA ARCHITECTS

28b ENGLANDS LANE
LONDON NW3 4UE
Tel: 020 7722 7664
Fax: 7722 7652

287 + 287 FARMER ROAD NO 339
LONDON NW3

REAR ELEVATION
AS BUILT

SK. 09

scale 1:75 date 10.11.07