


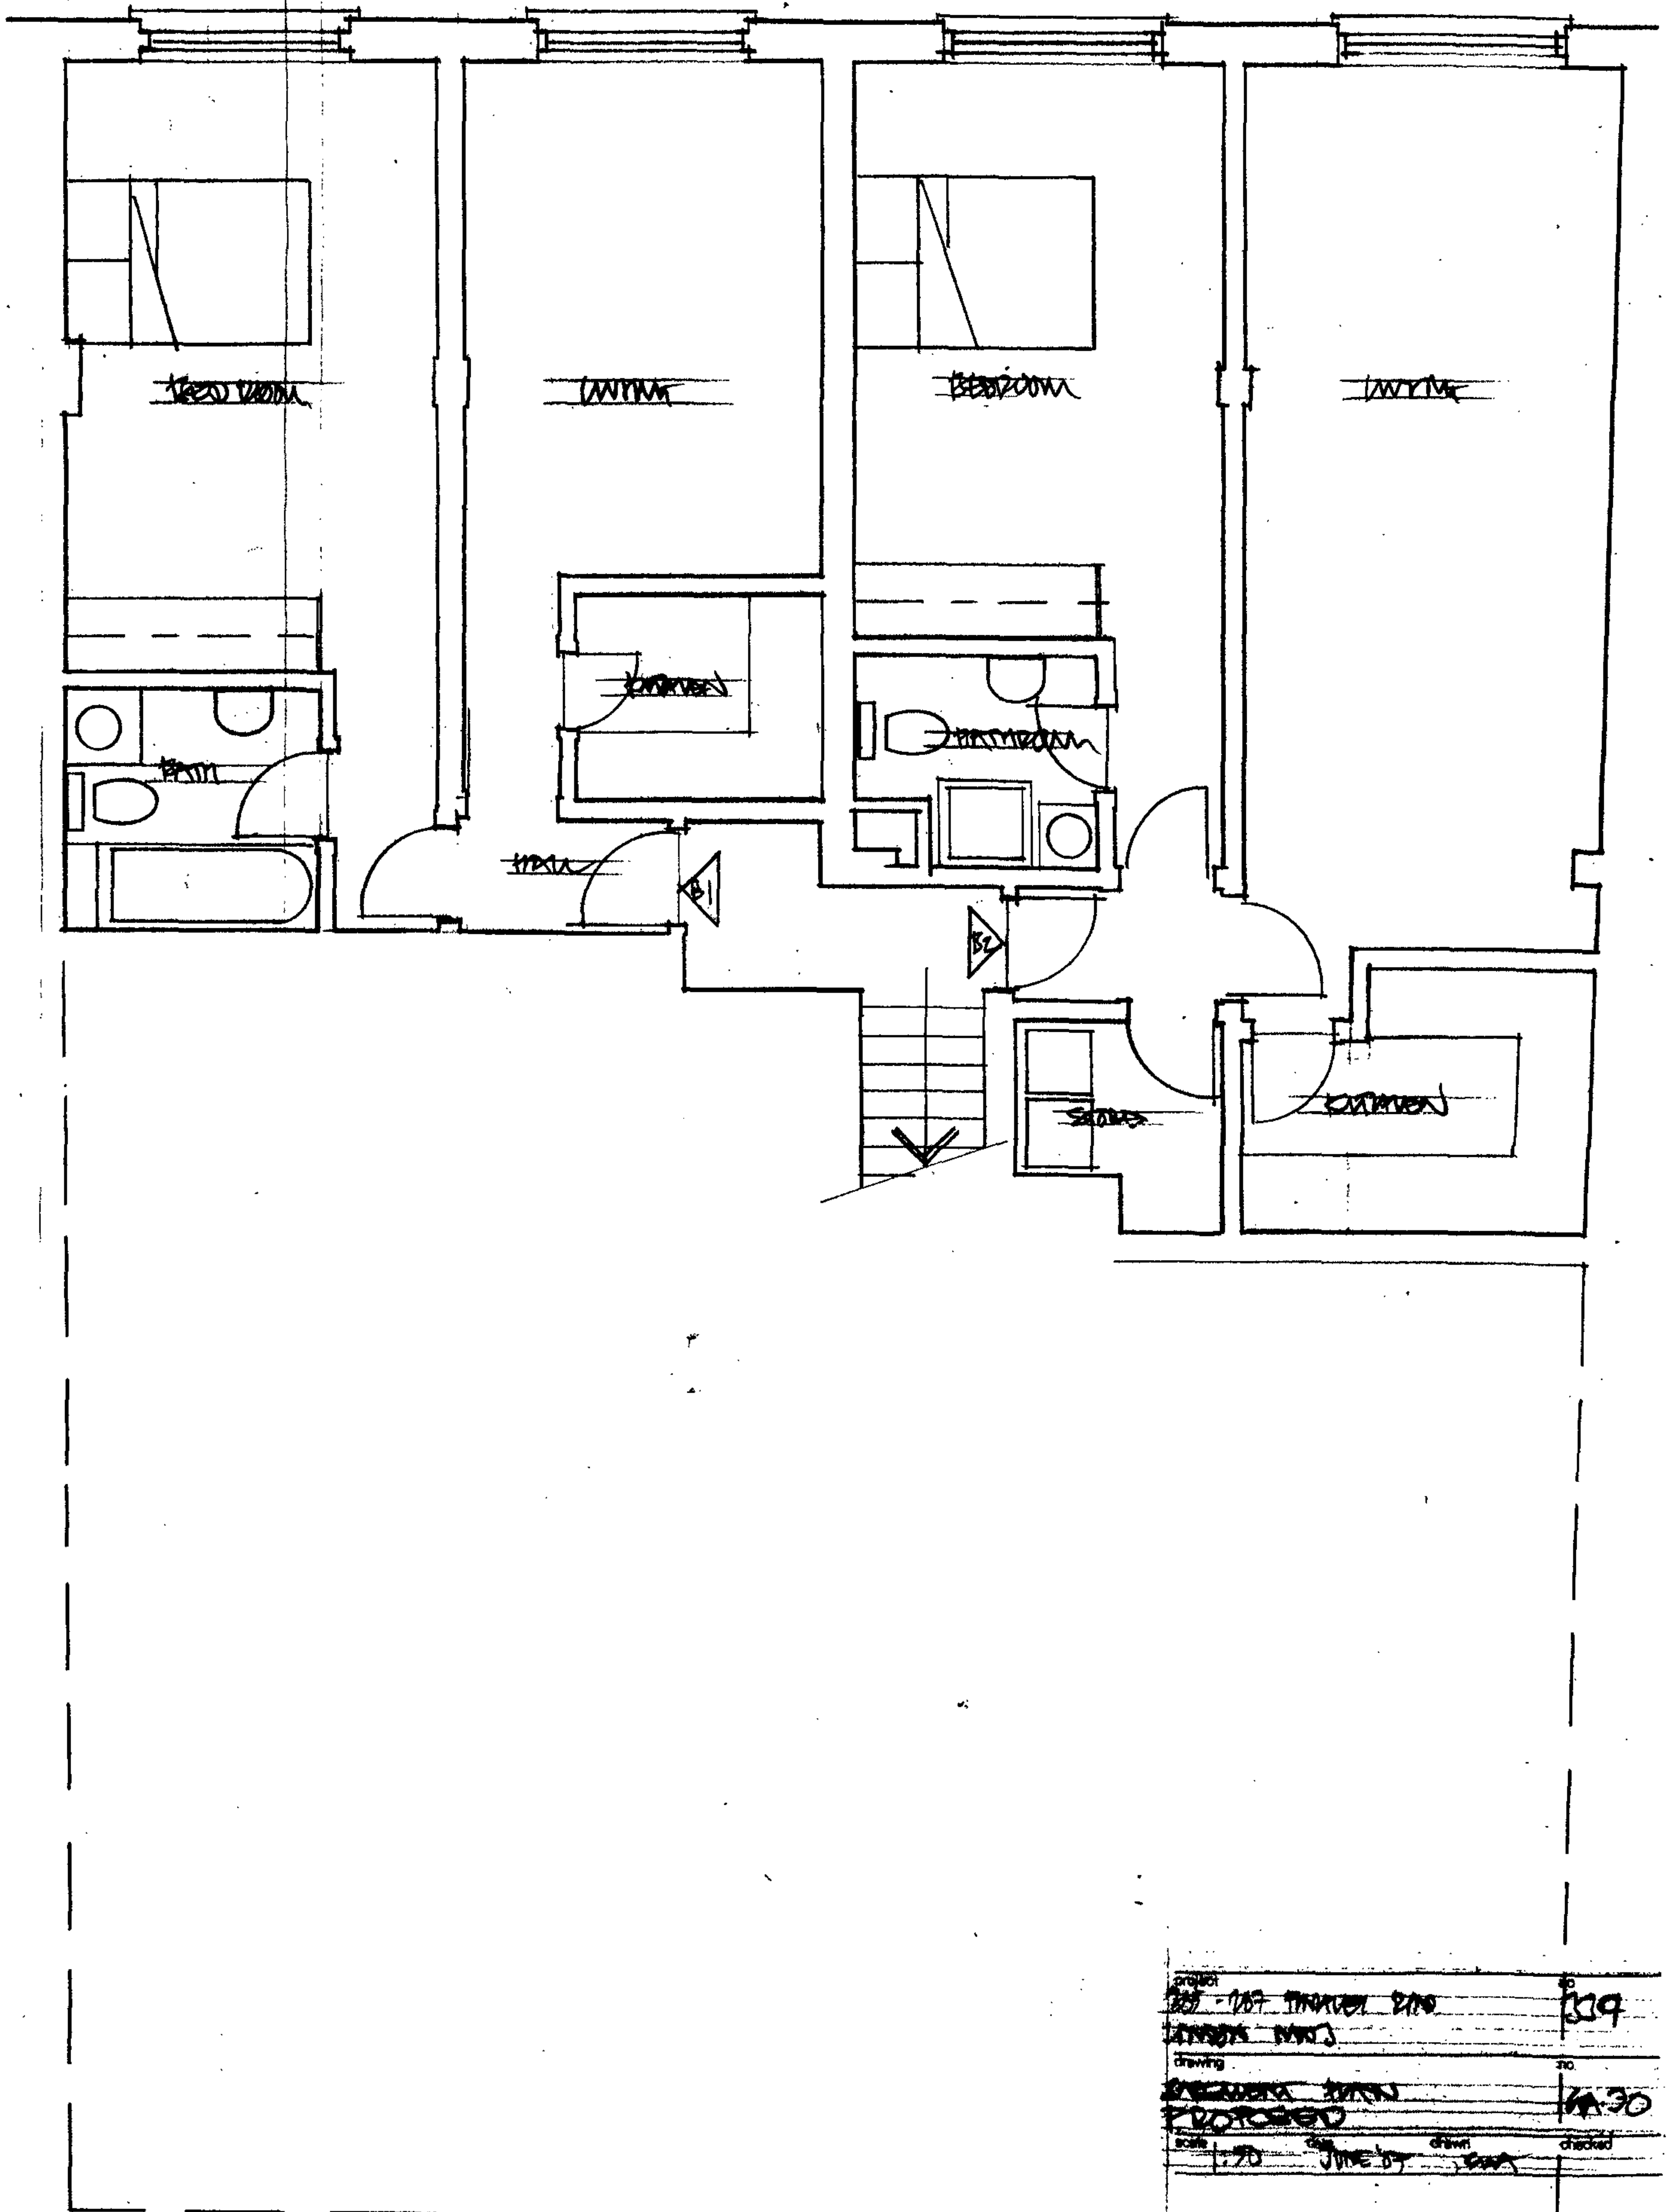








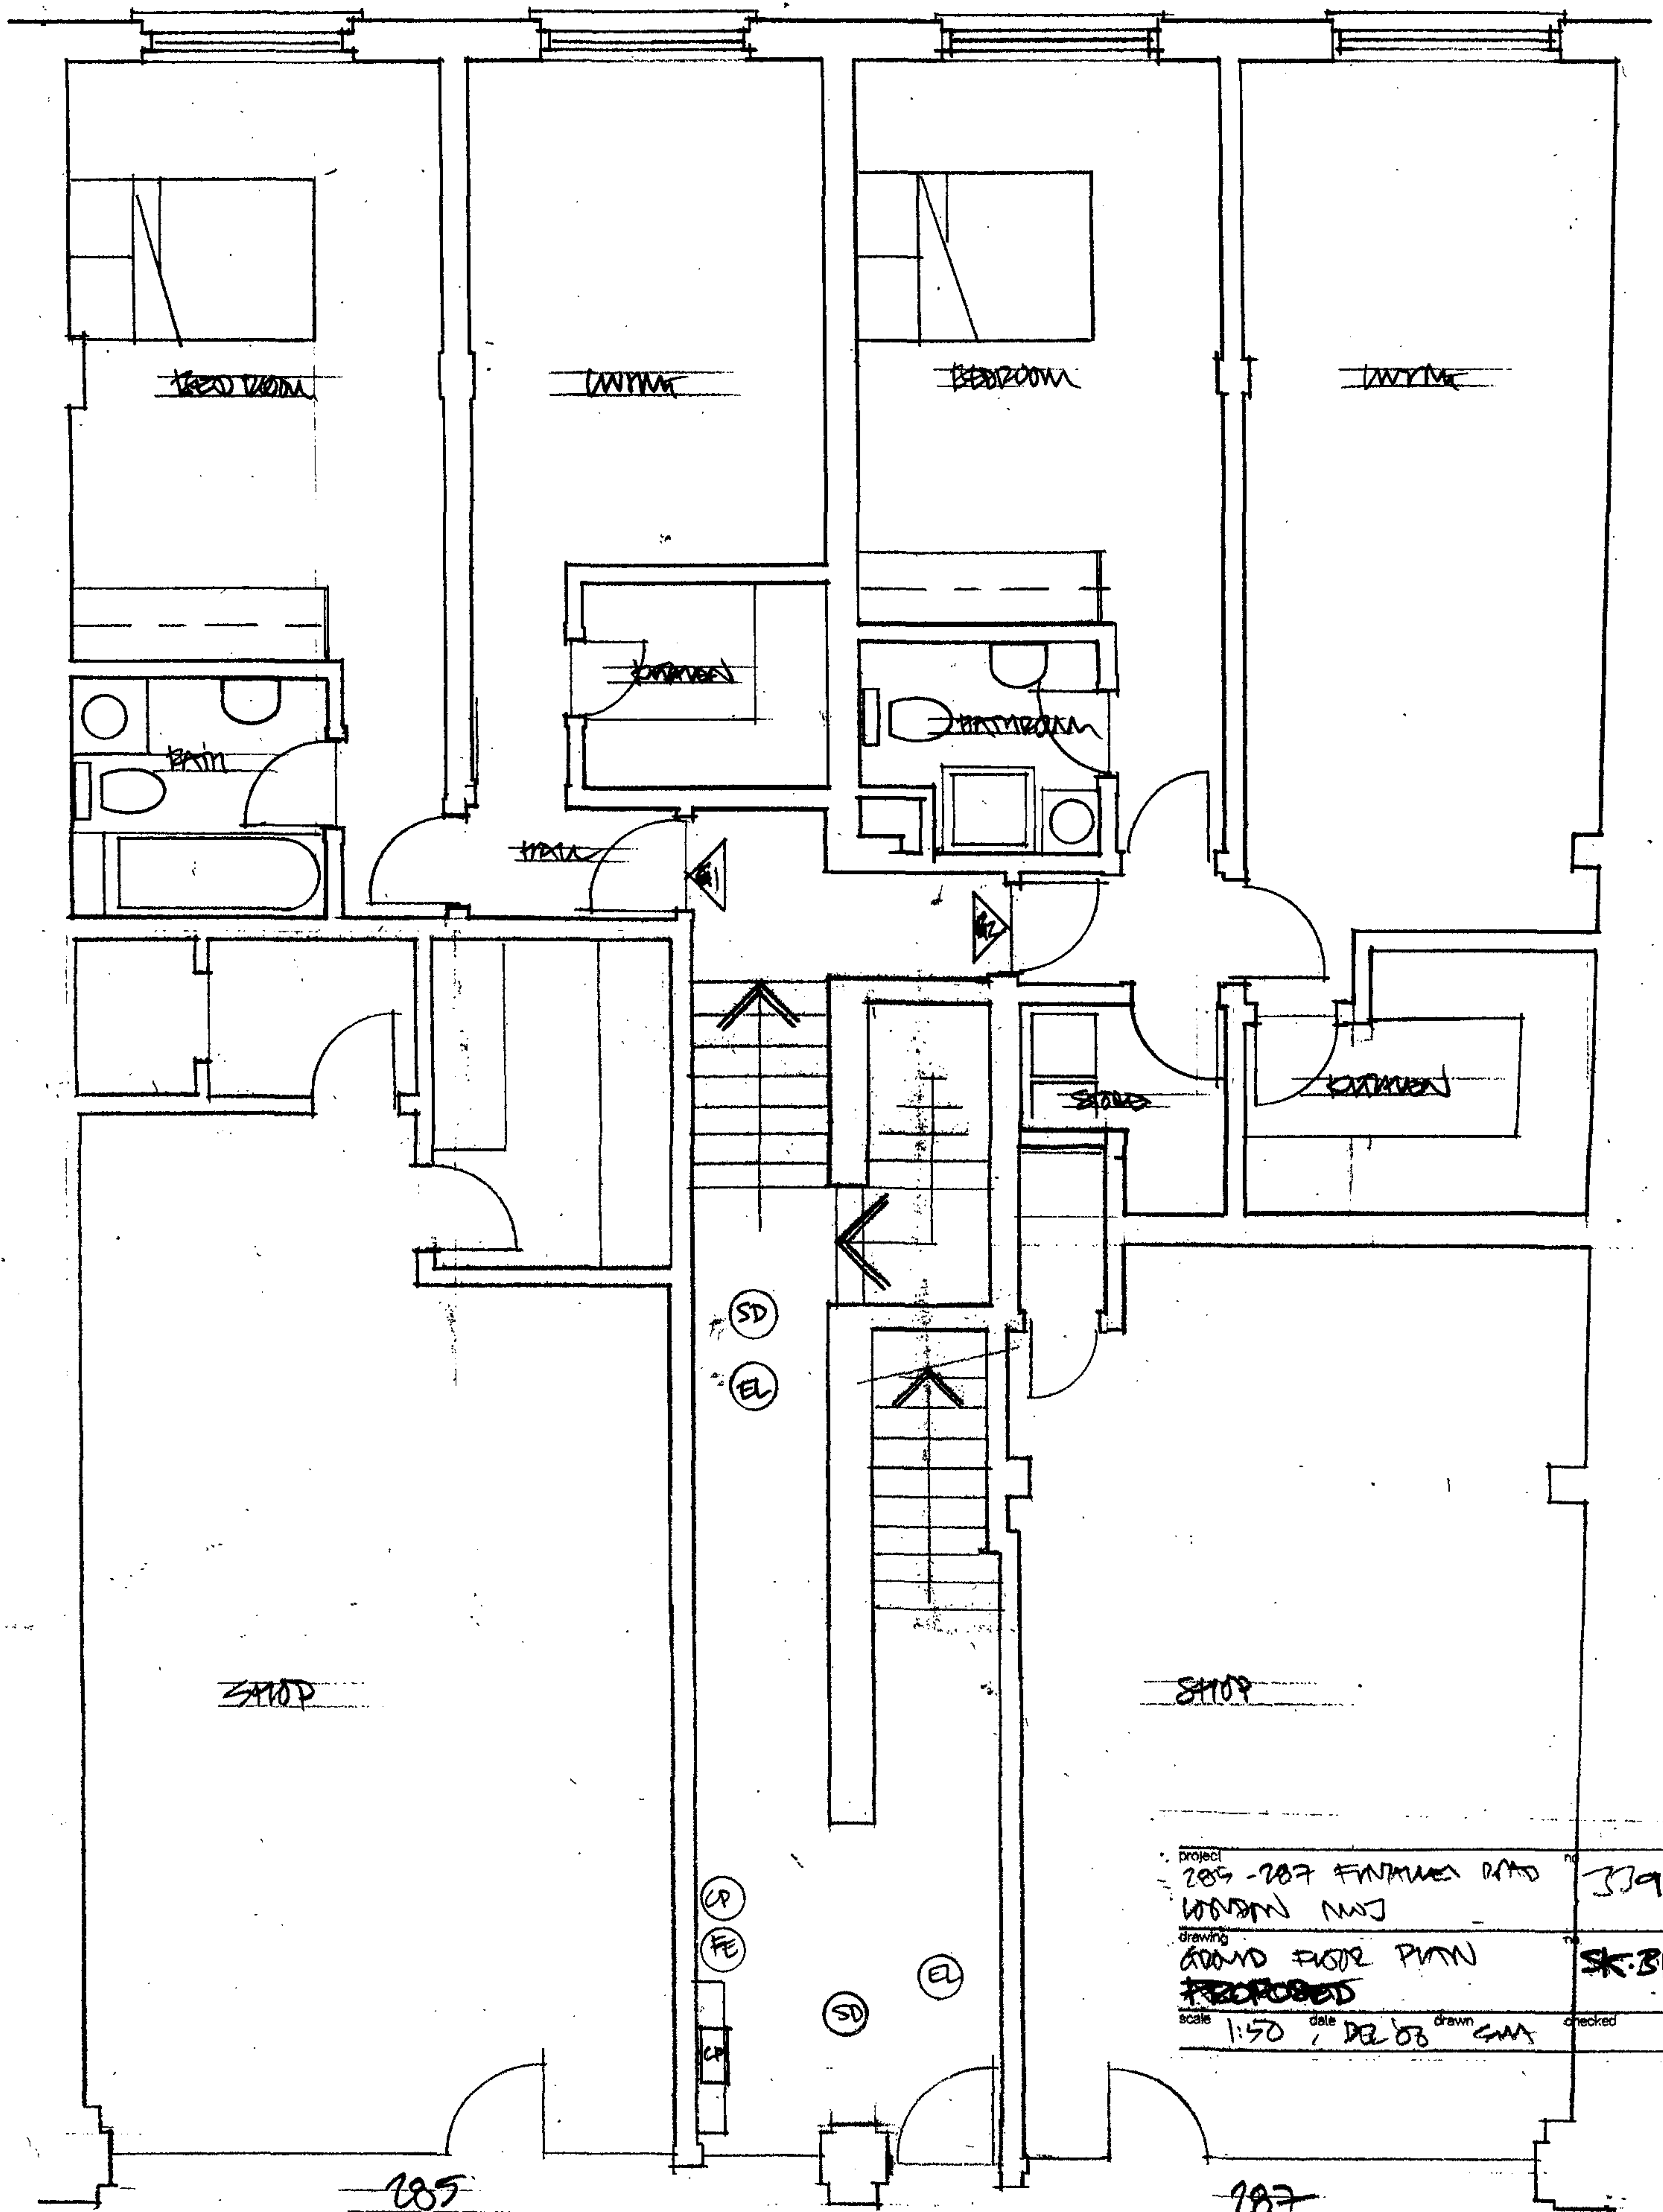


Project	285-287 FINCHLEY ROAD NW3	No	339
Drawing	GROUND FLOOR PLAN	No	SK-BH
Scale	1:50	Date	DE 08
Drawn	GMA	Checked	

285 & 287 FINCHLEY ROAD NW3

GROUND FLOOR PLAN 1:50

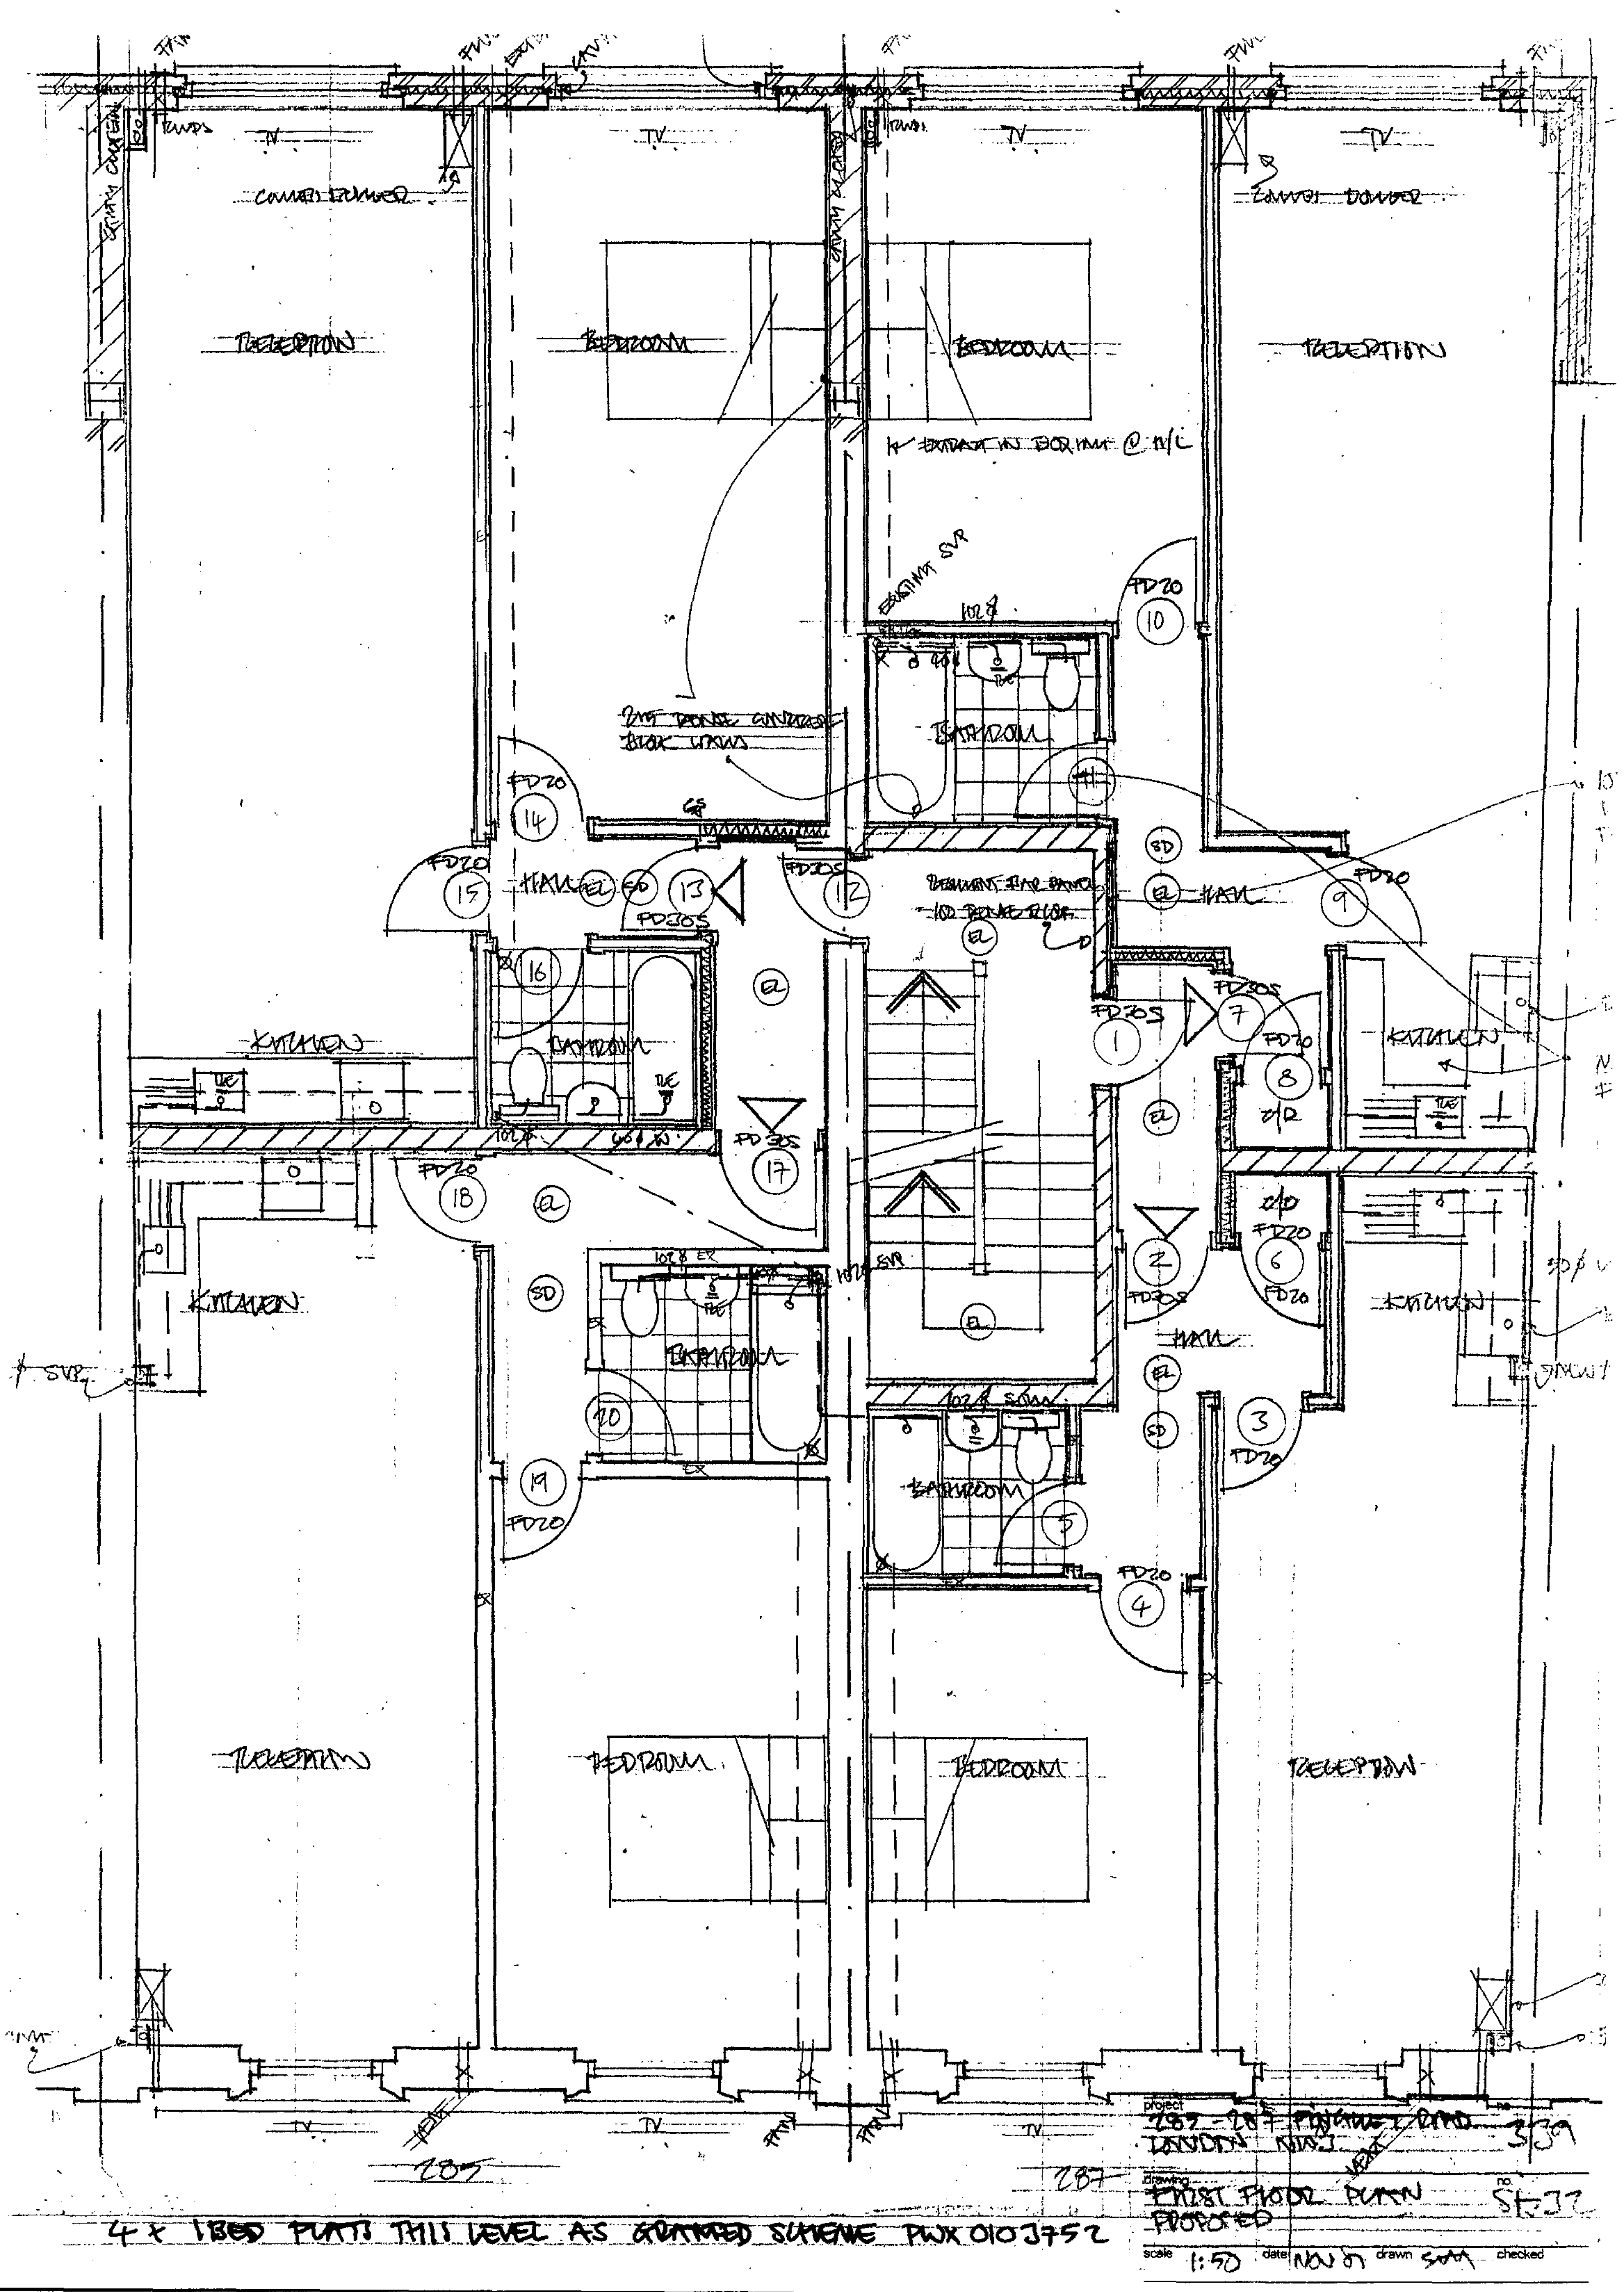


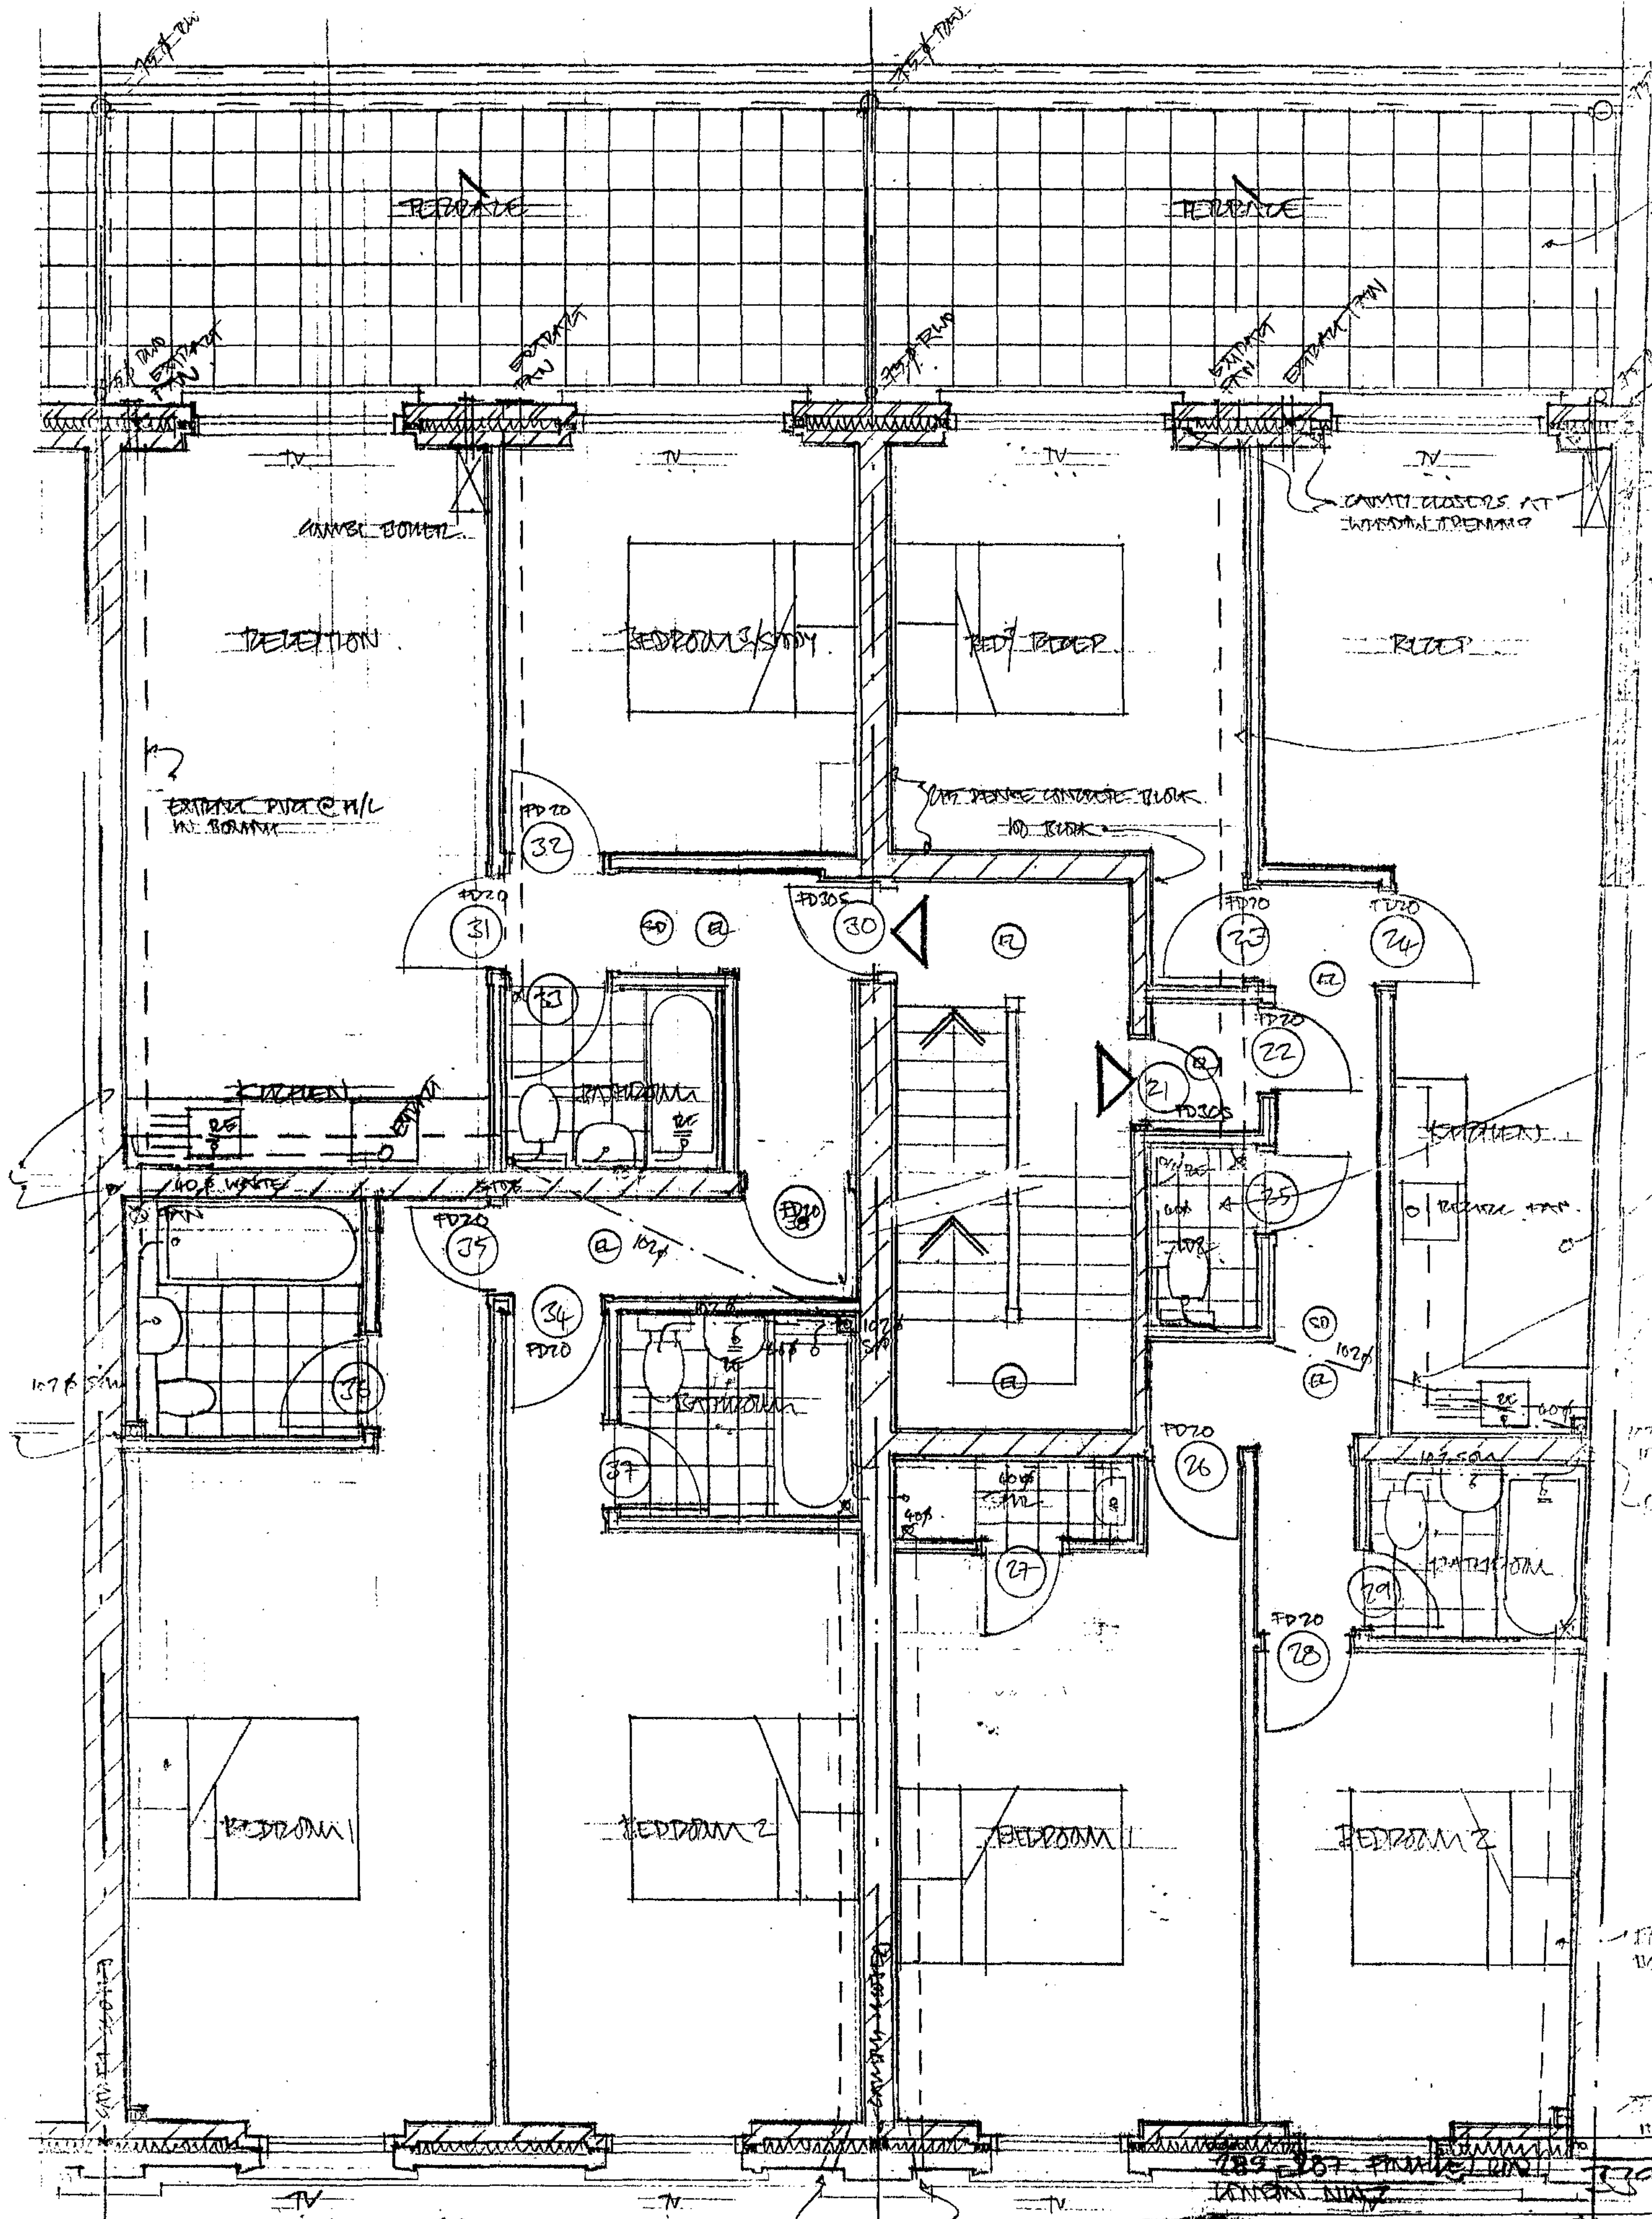

2x3 BED FLATS THIS LEVEL AT GRANTED SCHEME PAX 0103452

SECOND FLOOR PLAN
PROPOSED
scale 1:50 date NOV 01 drawn CM checked

SK 33

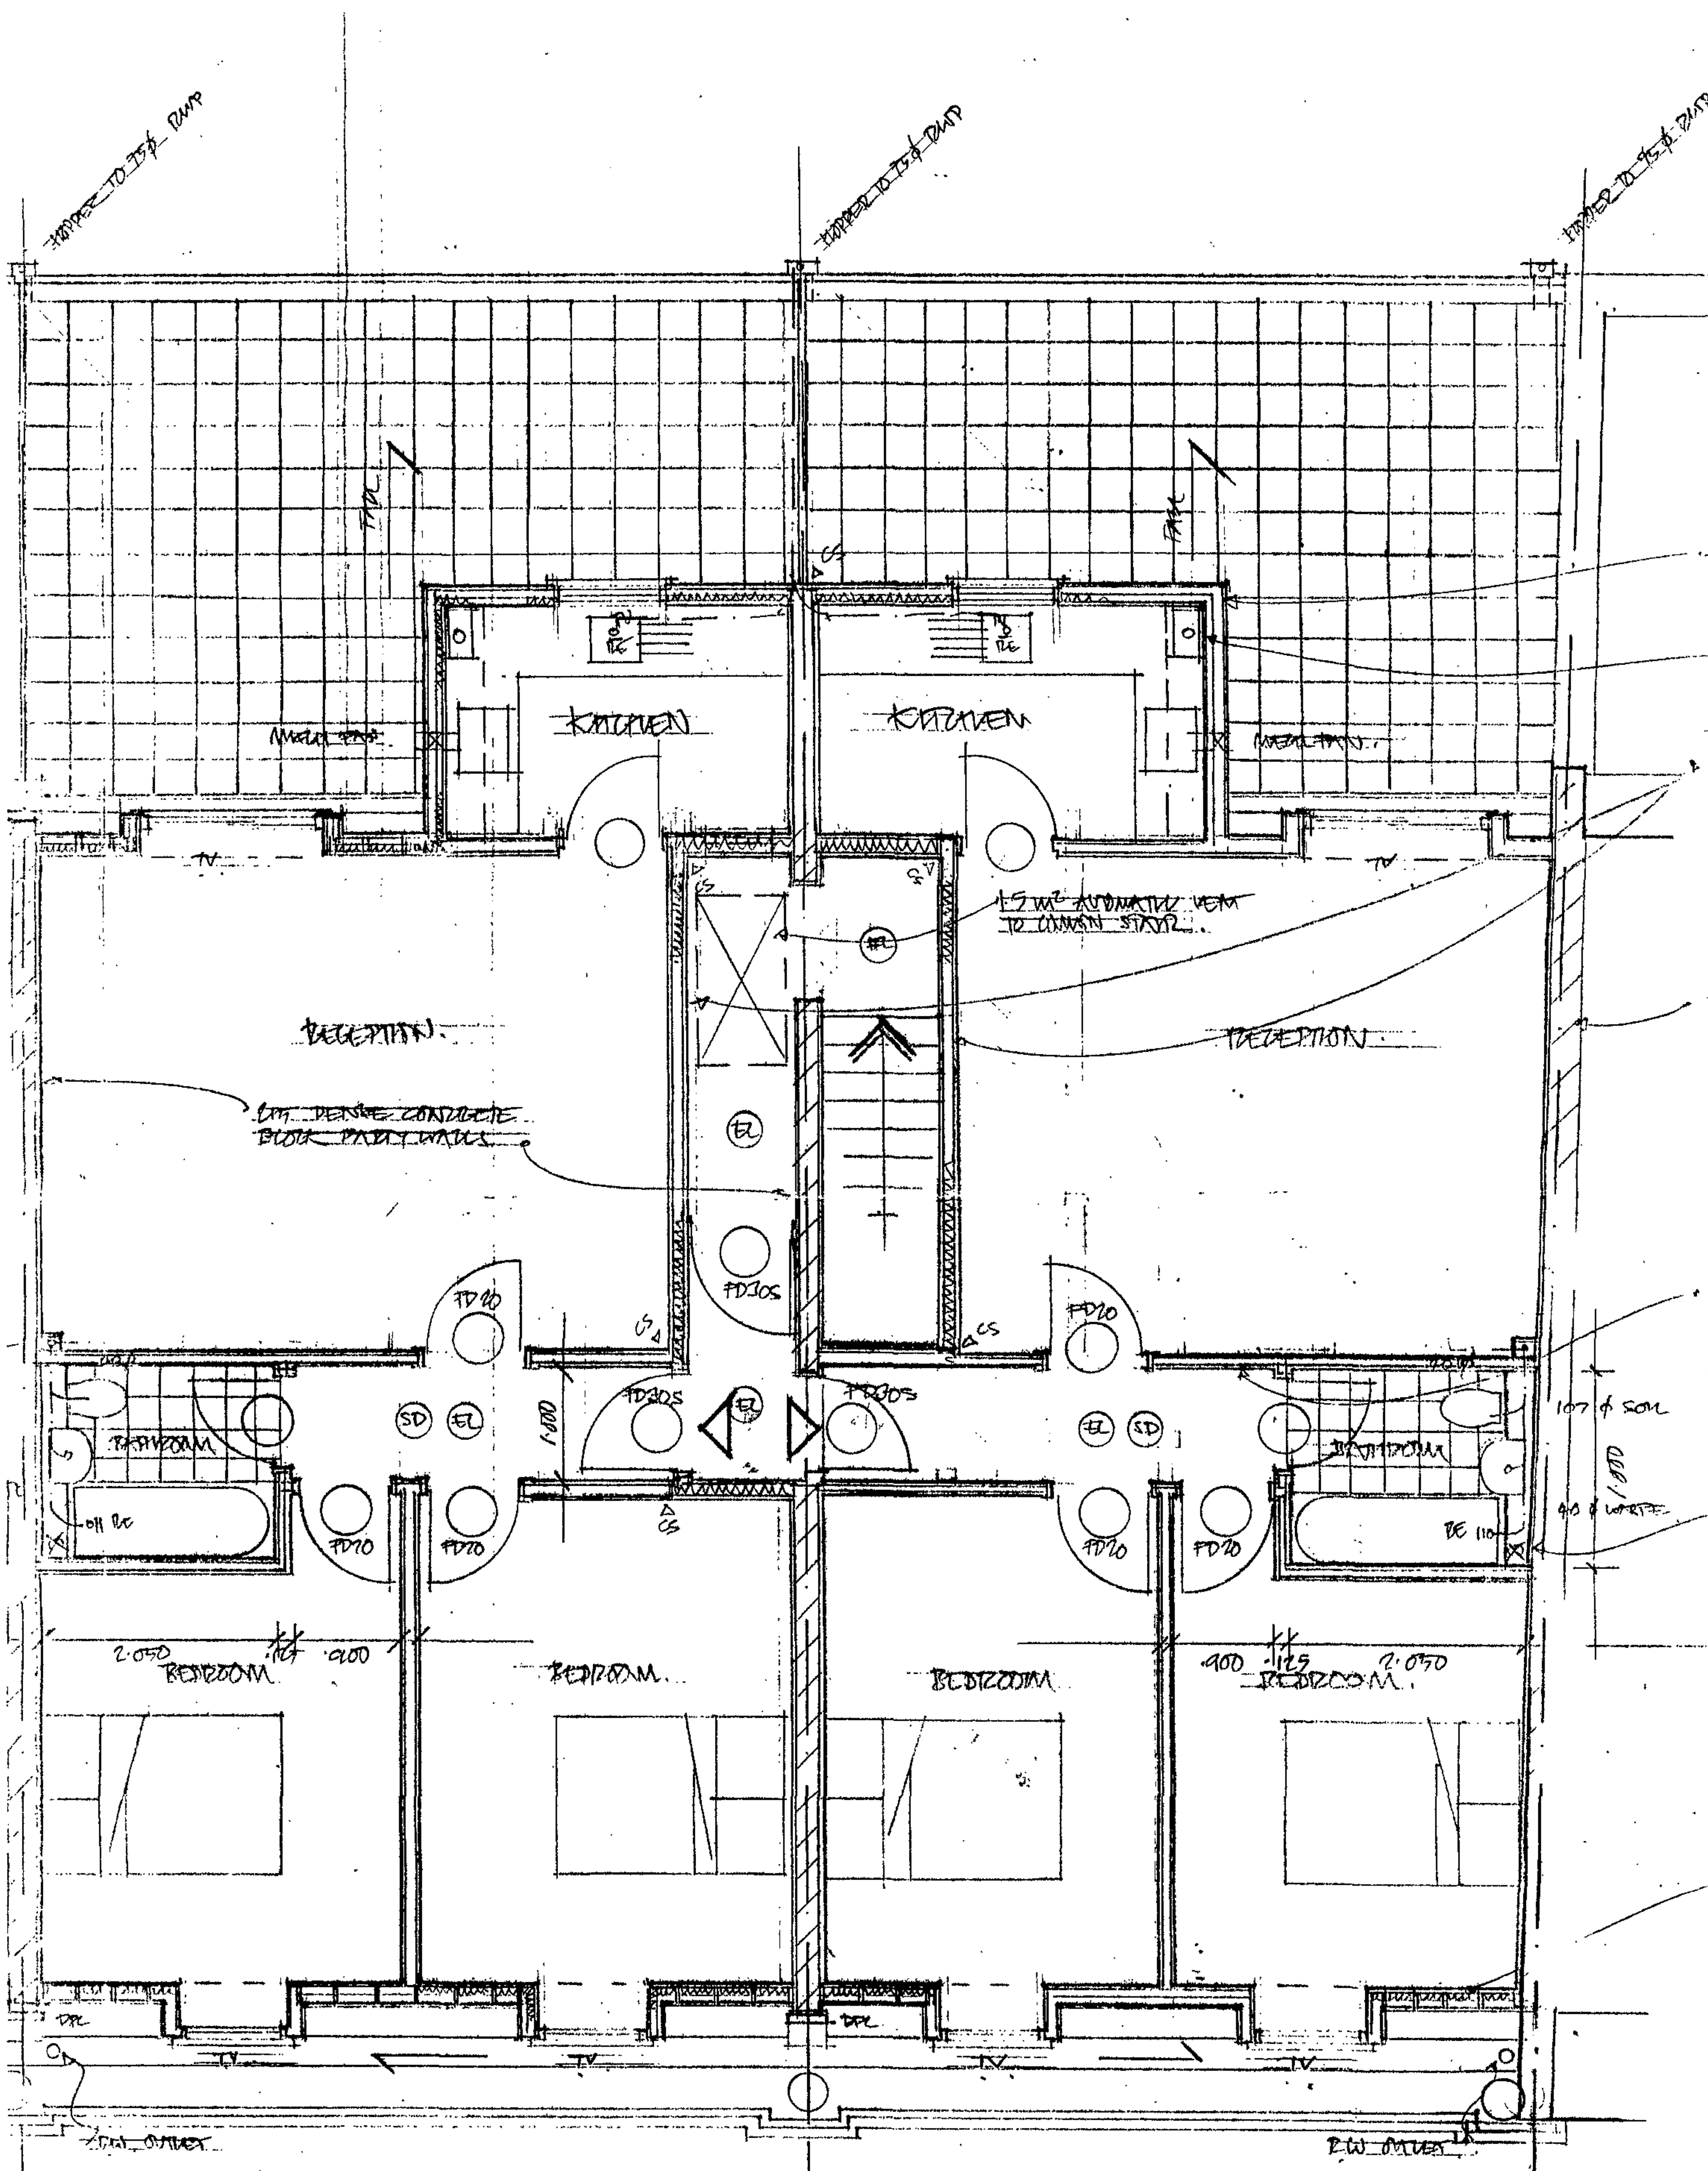

2x2 BED FLATS THIS LEVEL AS ADAPTED SCHEME PWX 0103752
 BUT WITH SMALL KITCHEN EXTENSIONS TO REAR AS BUILT

Project
 CBS-207 FINEWAY ROAD NO 339
 LONDON NW3
 DRAWN BY: PWN
 PROPOSED
 Scale 1:50 Date NOV 01 drawn: SAA checked: