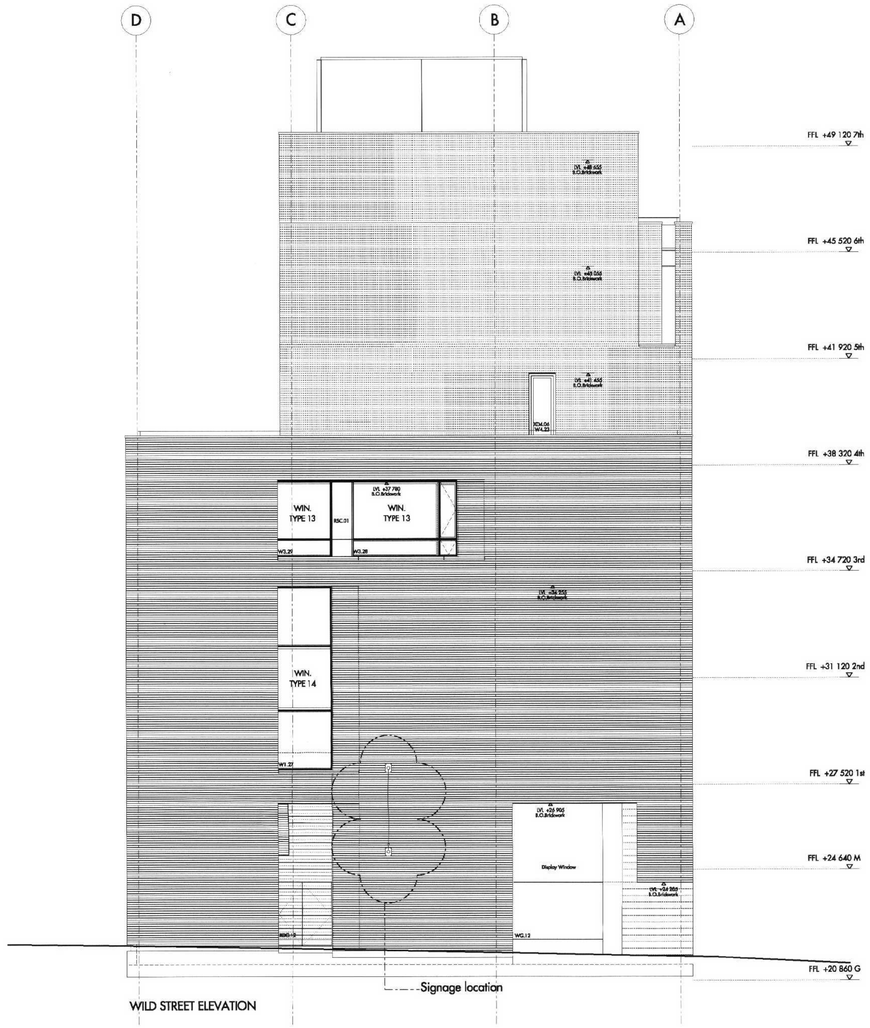

WILD STREET ELEVATION

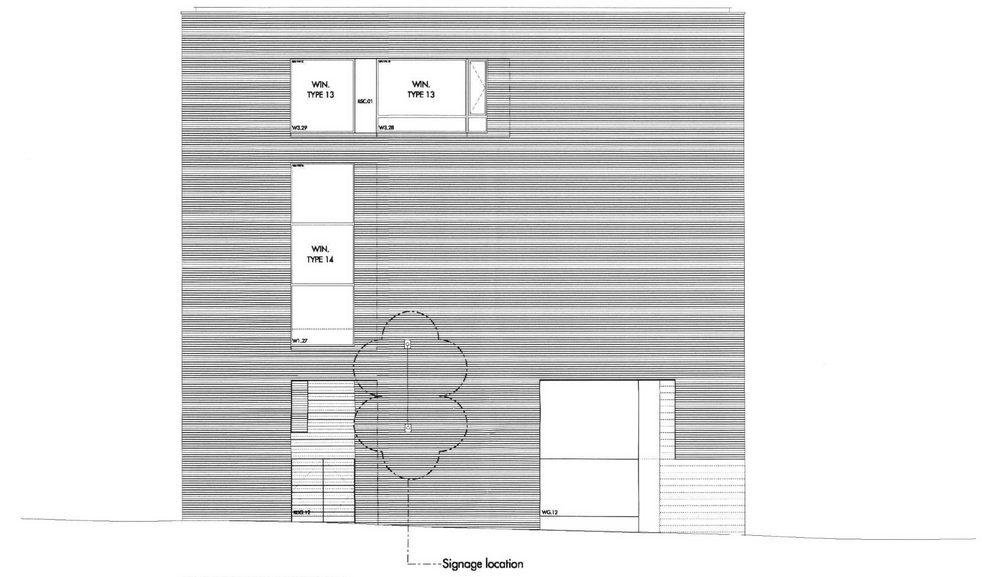

TRUE ELEVATION OF WINDOWS

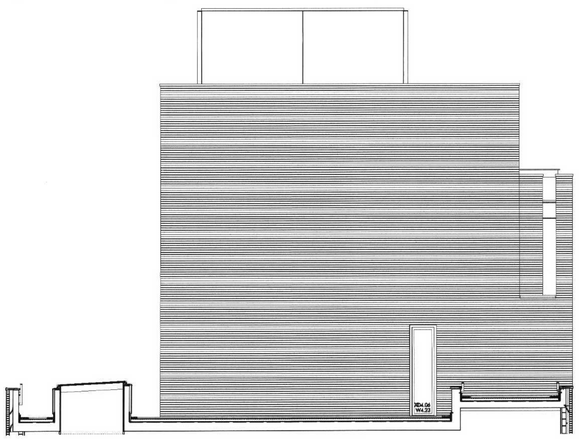

WILD STREET UPPER ELEVATION

GENERAL NOTES

Dimensions shall govern. Do not scale off this drawing.
Use figured dimensions only. All levels are nominal.
Detailed site survey to be carried out to establish tolerances.
Figured dimensions are in millimetres.
All dimensions shall be varified on site before proceeding with the work. The architect shall be notified of any discrepancies.

REVISIONS

REV.	DATE:	DESCRIPTION:	CKD.
01	14.11.03	ISSUED FOR TENDER	
02	26.11.03	ISSUED FOR TENDER WITH PRE-TENDER REVISIONS	
03	28.11.03	BRICKWORK MOVEMENT JOINTS ADDED	
04	14.01.04	BRICKWORK MOVEMENT JOINTS ADJUSTED	JS
05	30.04.04	BRICKWORK MOVEMENT JOINT LEVELS SHOWN, ISSUED FOR CONSTRUCTION FOR MASONRY PACKAGE	JS
06	24.03.05	AS BUILT ISSUE	JS
07	APR 07	PLANNING APPLICATION FOR SIGNAGE	JS

Allies and Morrison Architects
85 Southwark Street
London SE1 0HX
telephone 020 7921 0100
facsimile 020 7921 0101
email info@alliesandmorrison.co.uk

The City Literary Institute, Keeley Street, London

ELEVATION
Wild St. / Wild St. Upper / Wild St. True

175-WD-021

SCALE: 1:100 @A1 JOB NO: 175

Revision 07