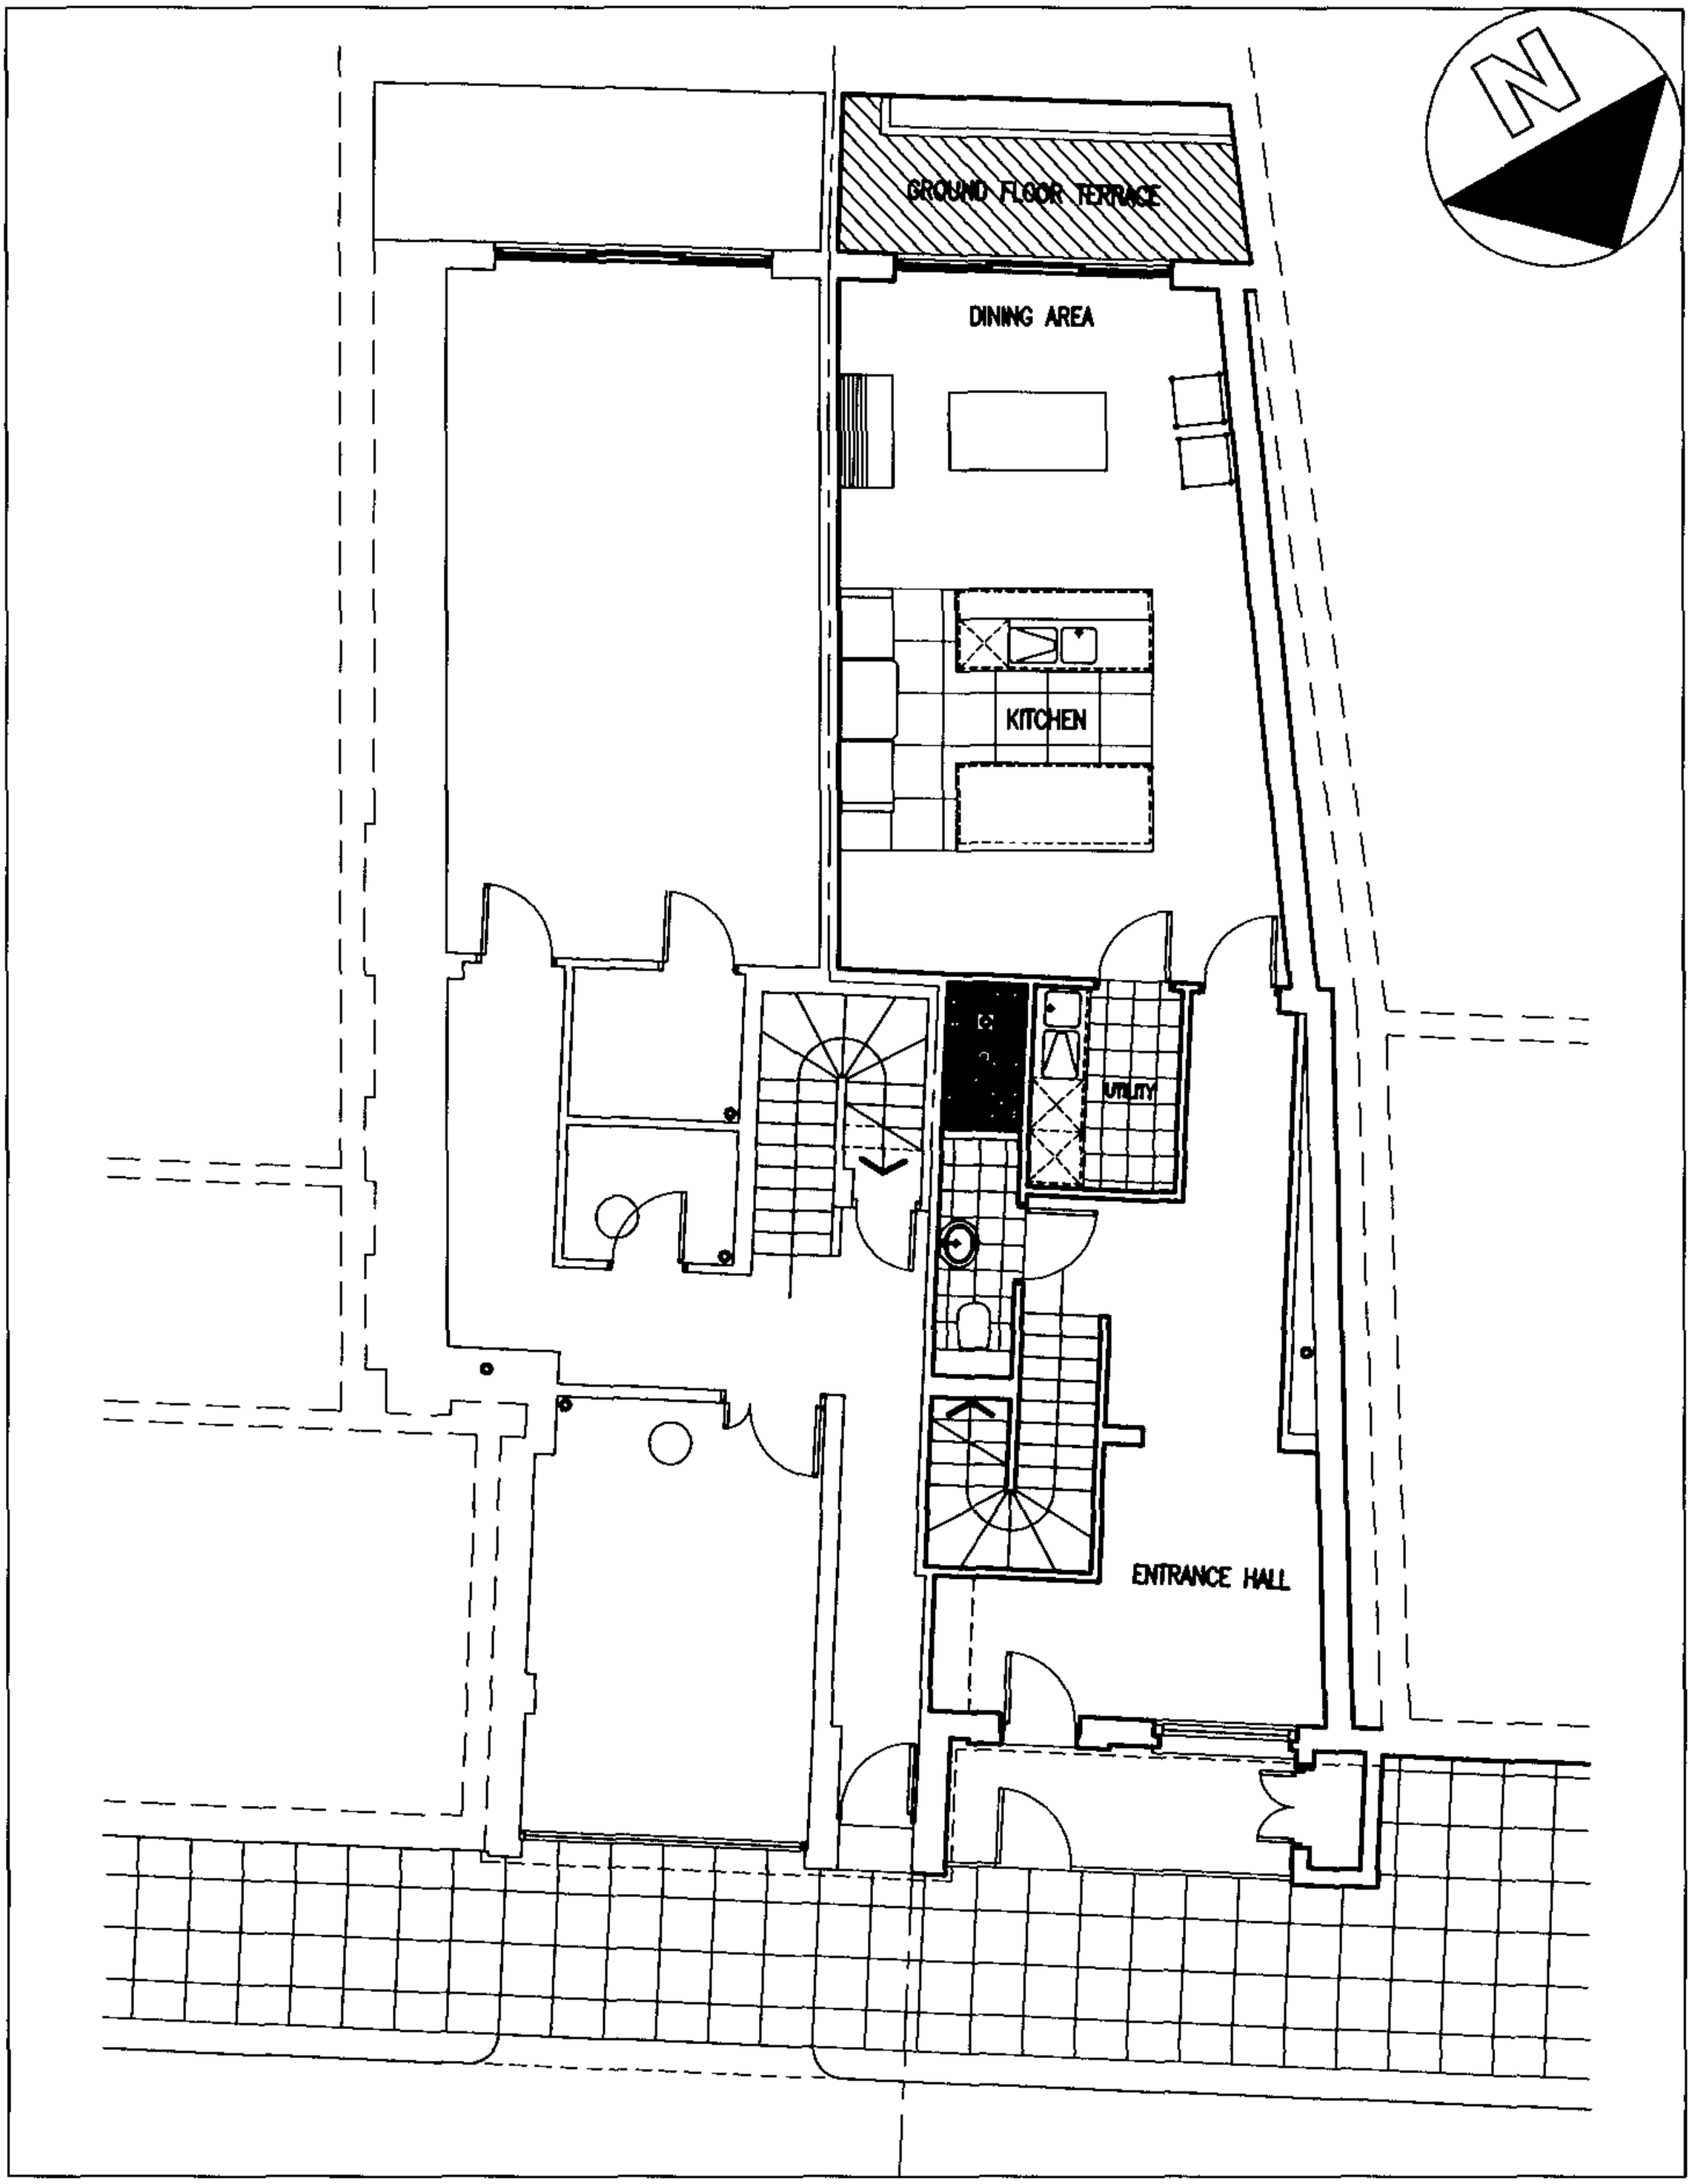

SUBJECT TO SITE SURVEY AND ALL RELEVANT STATUTORY AUTHORITY APPROVALS.

AS-BUILT DRAWING

Project: 89C REGENT'S PARK ROAD – LONDON NW1			Job No: 784
Drawing: EXISTING GROUND FLOOR PLAN			Drg.No: 02
Scale: 1:100 @ A4	Date: 24:07:2006	Drawn: DKC	CAD Ref: 784/02.dwg

Derek Copeman
Architect.

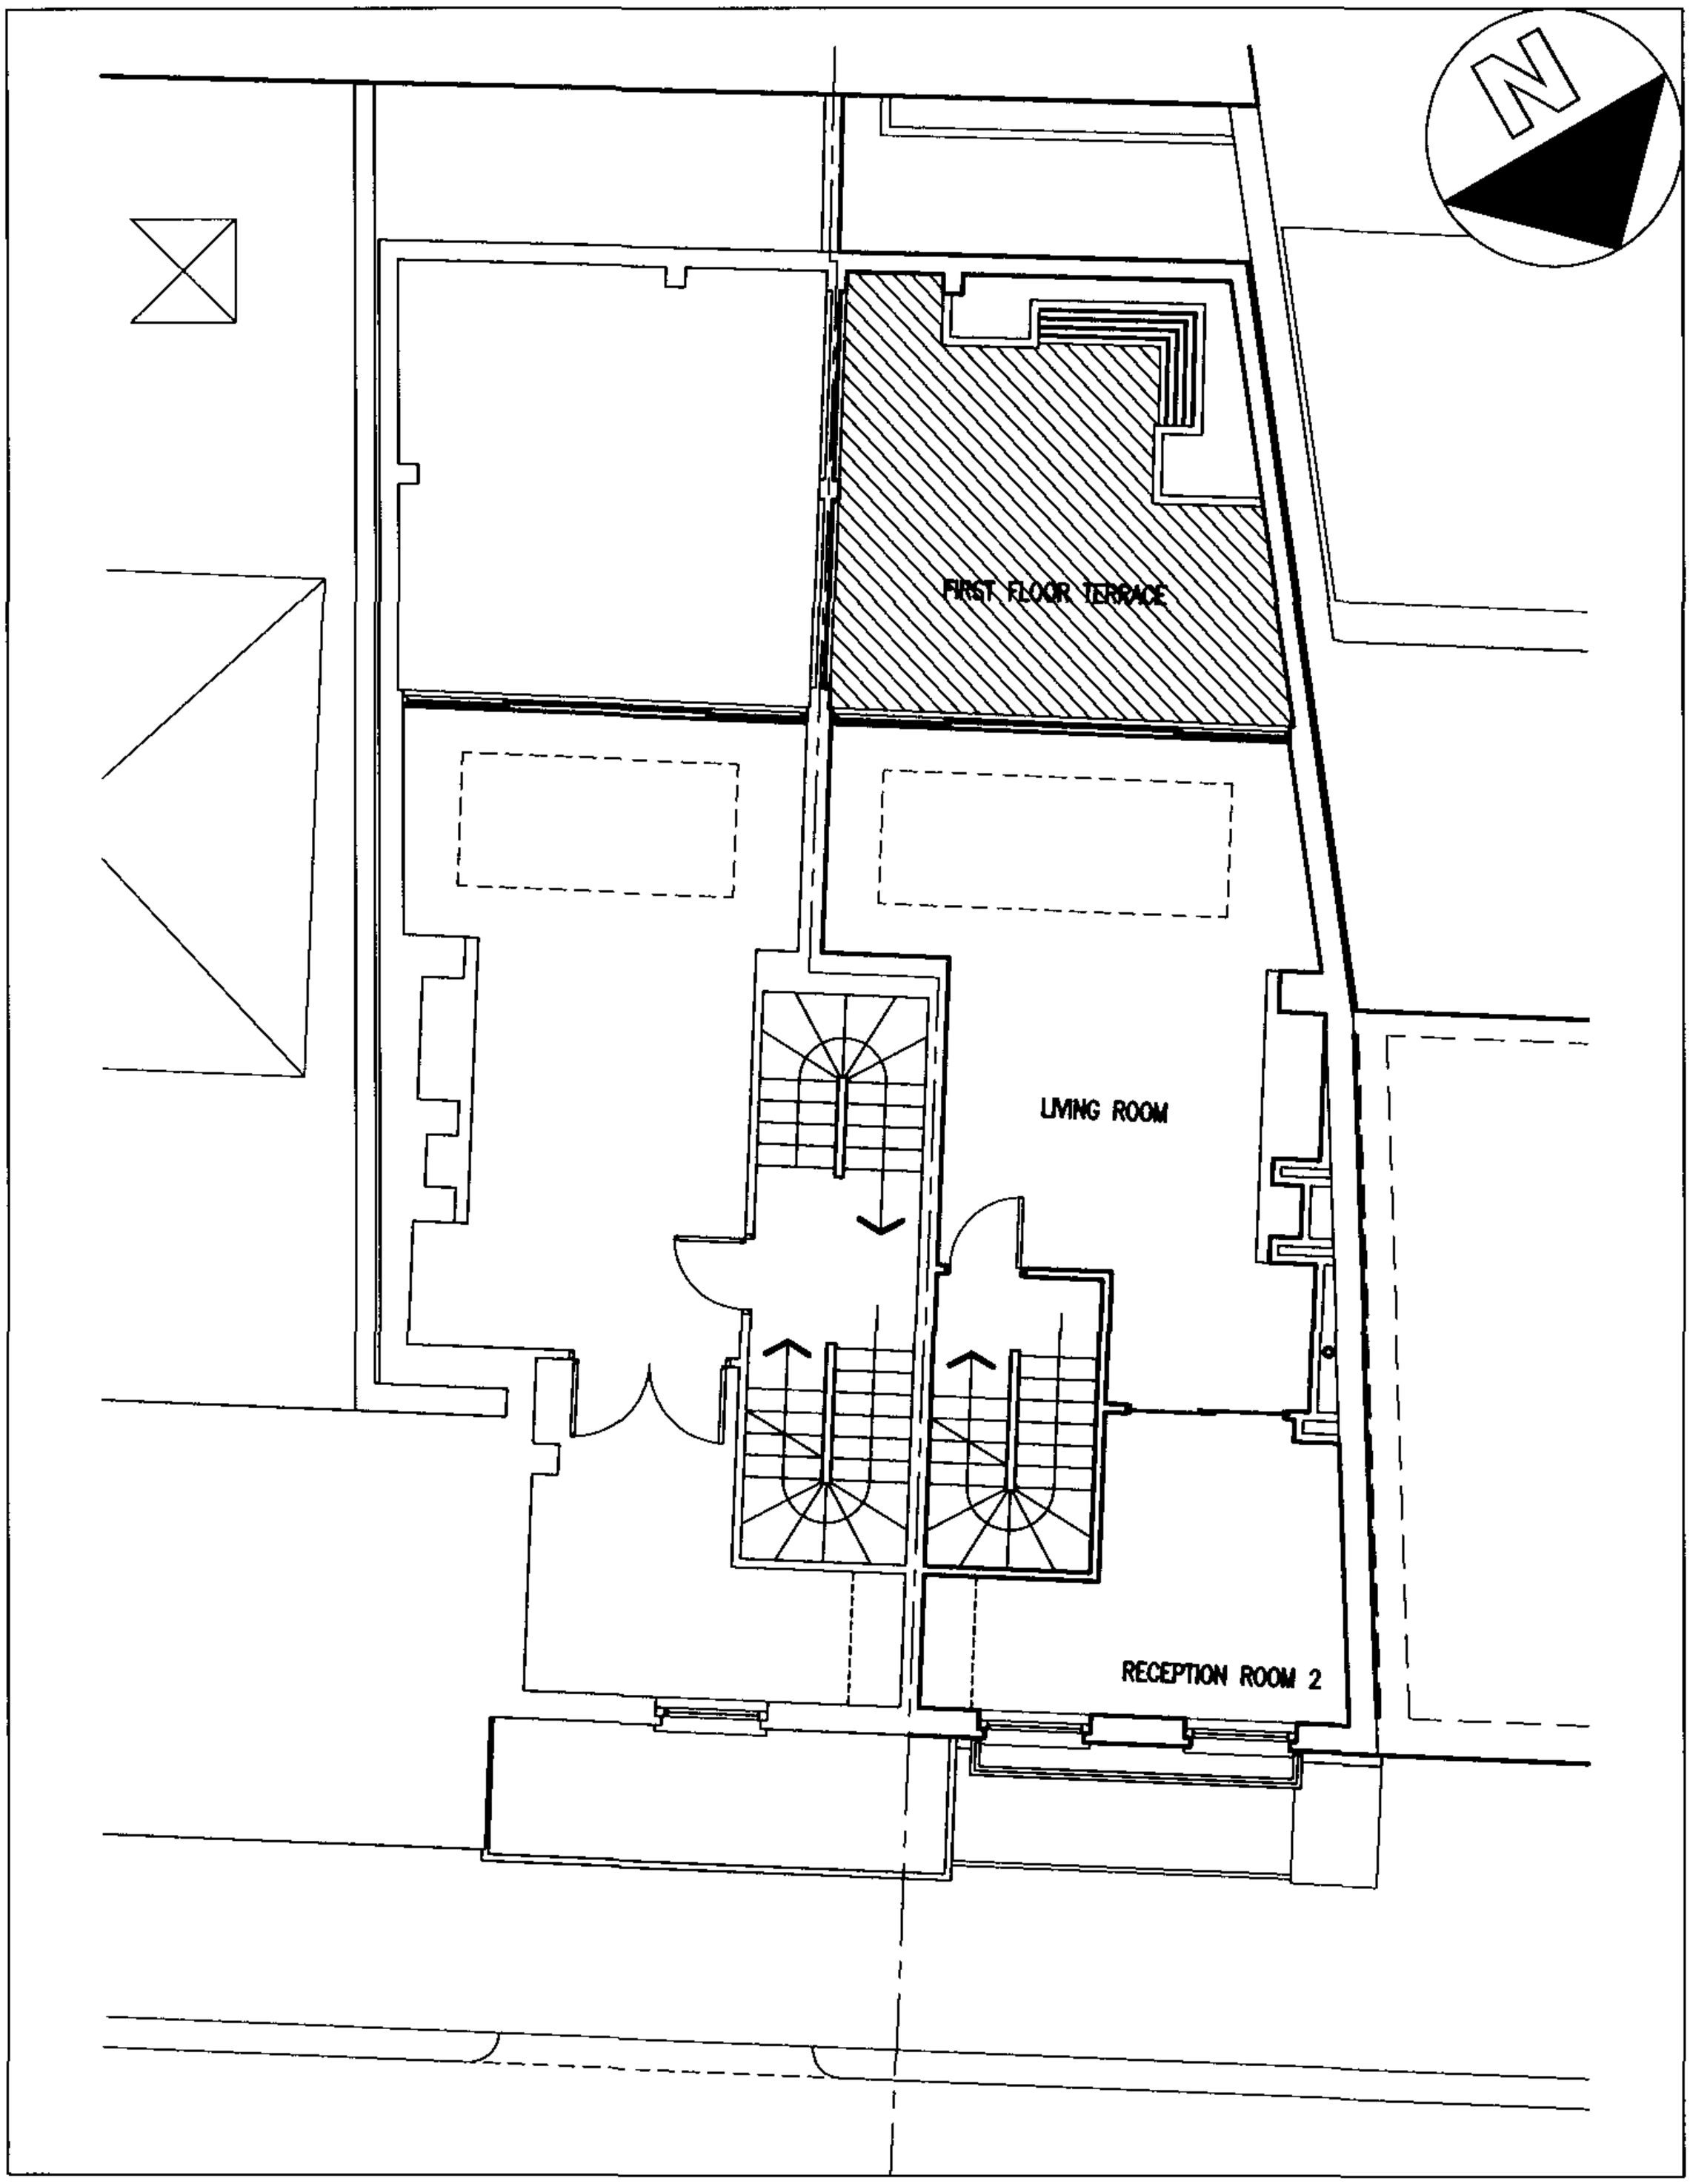

SUBJECT TO SITE SURVEY AND ALL RELEVANT STATUTORY AUTHORITY APPROVALS.

AS-BUILT DRAWING

Project: 89C REGENT'S PARK ROAD – LONDON NW1			Job No: 784
Drawing: EXISTING FIRST FLOOR PLAN			Drg.No: 03
Scale: 1:100 @ A4	Date: 24:07:2006	Drawn: DKC	CAD Ref: 784/03.dwg

Derek Copeman Architect.

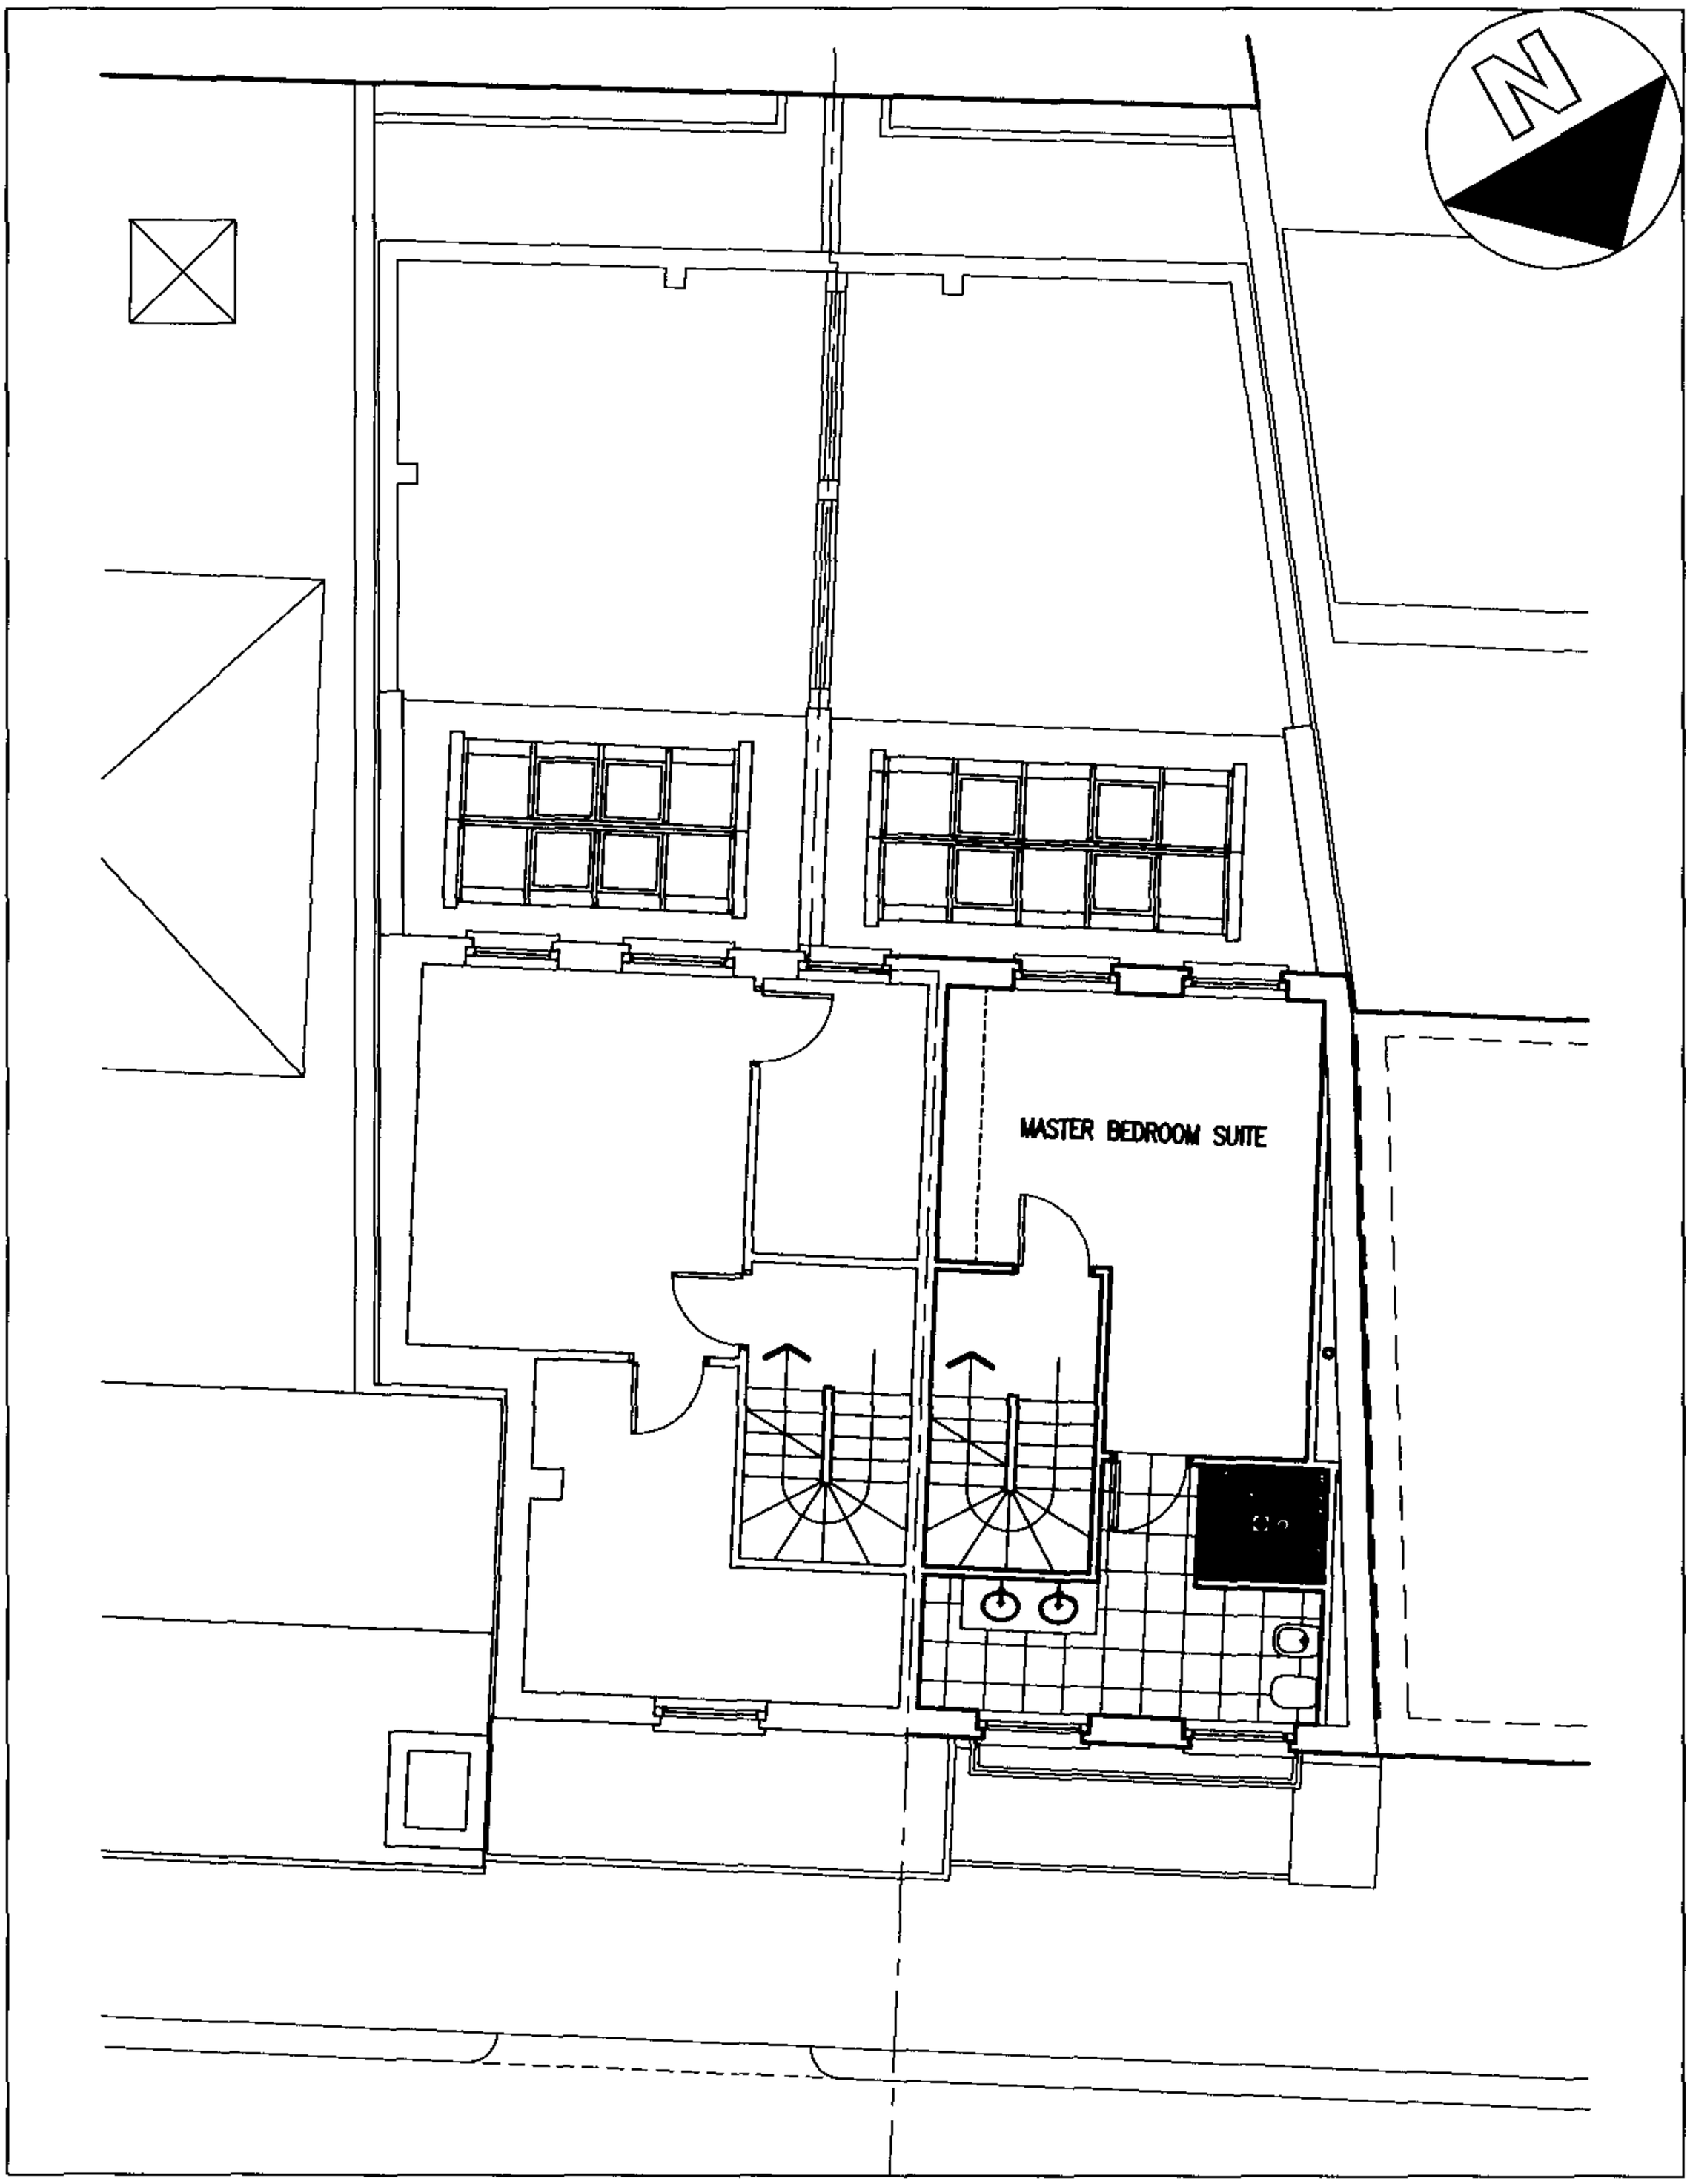

SUBJECT TO SITE SURVEY AND ALL RELEVANT STATUTORY AUTHORITY APPROVALS.

AS-BUILT DRAWING

Project: 89C REGENT'S PARK ROAD – LONDON NW1			Job No: 784
Drawing: EXISTING SECOND FLOOR PLAN			Drg.No: 04
Scale: 1:100 @ A4	Date: 24:07:2006	Drawn: DKC	CAD Ref: 784/04.dwg

Derek Copeman
Architect.

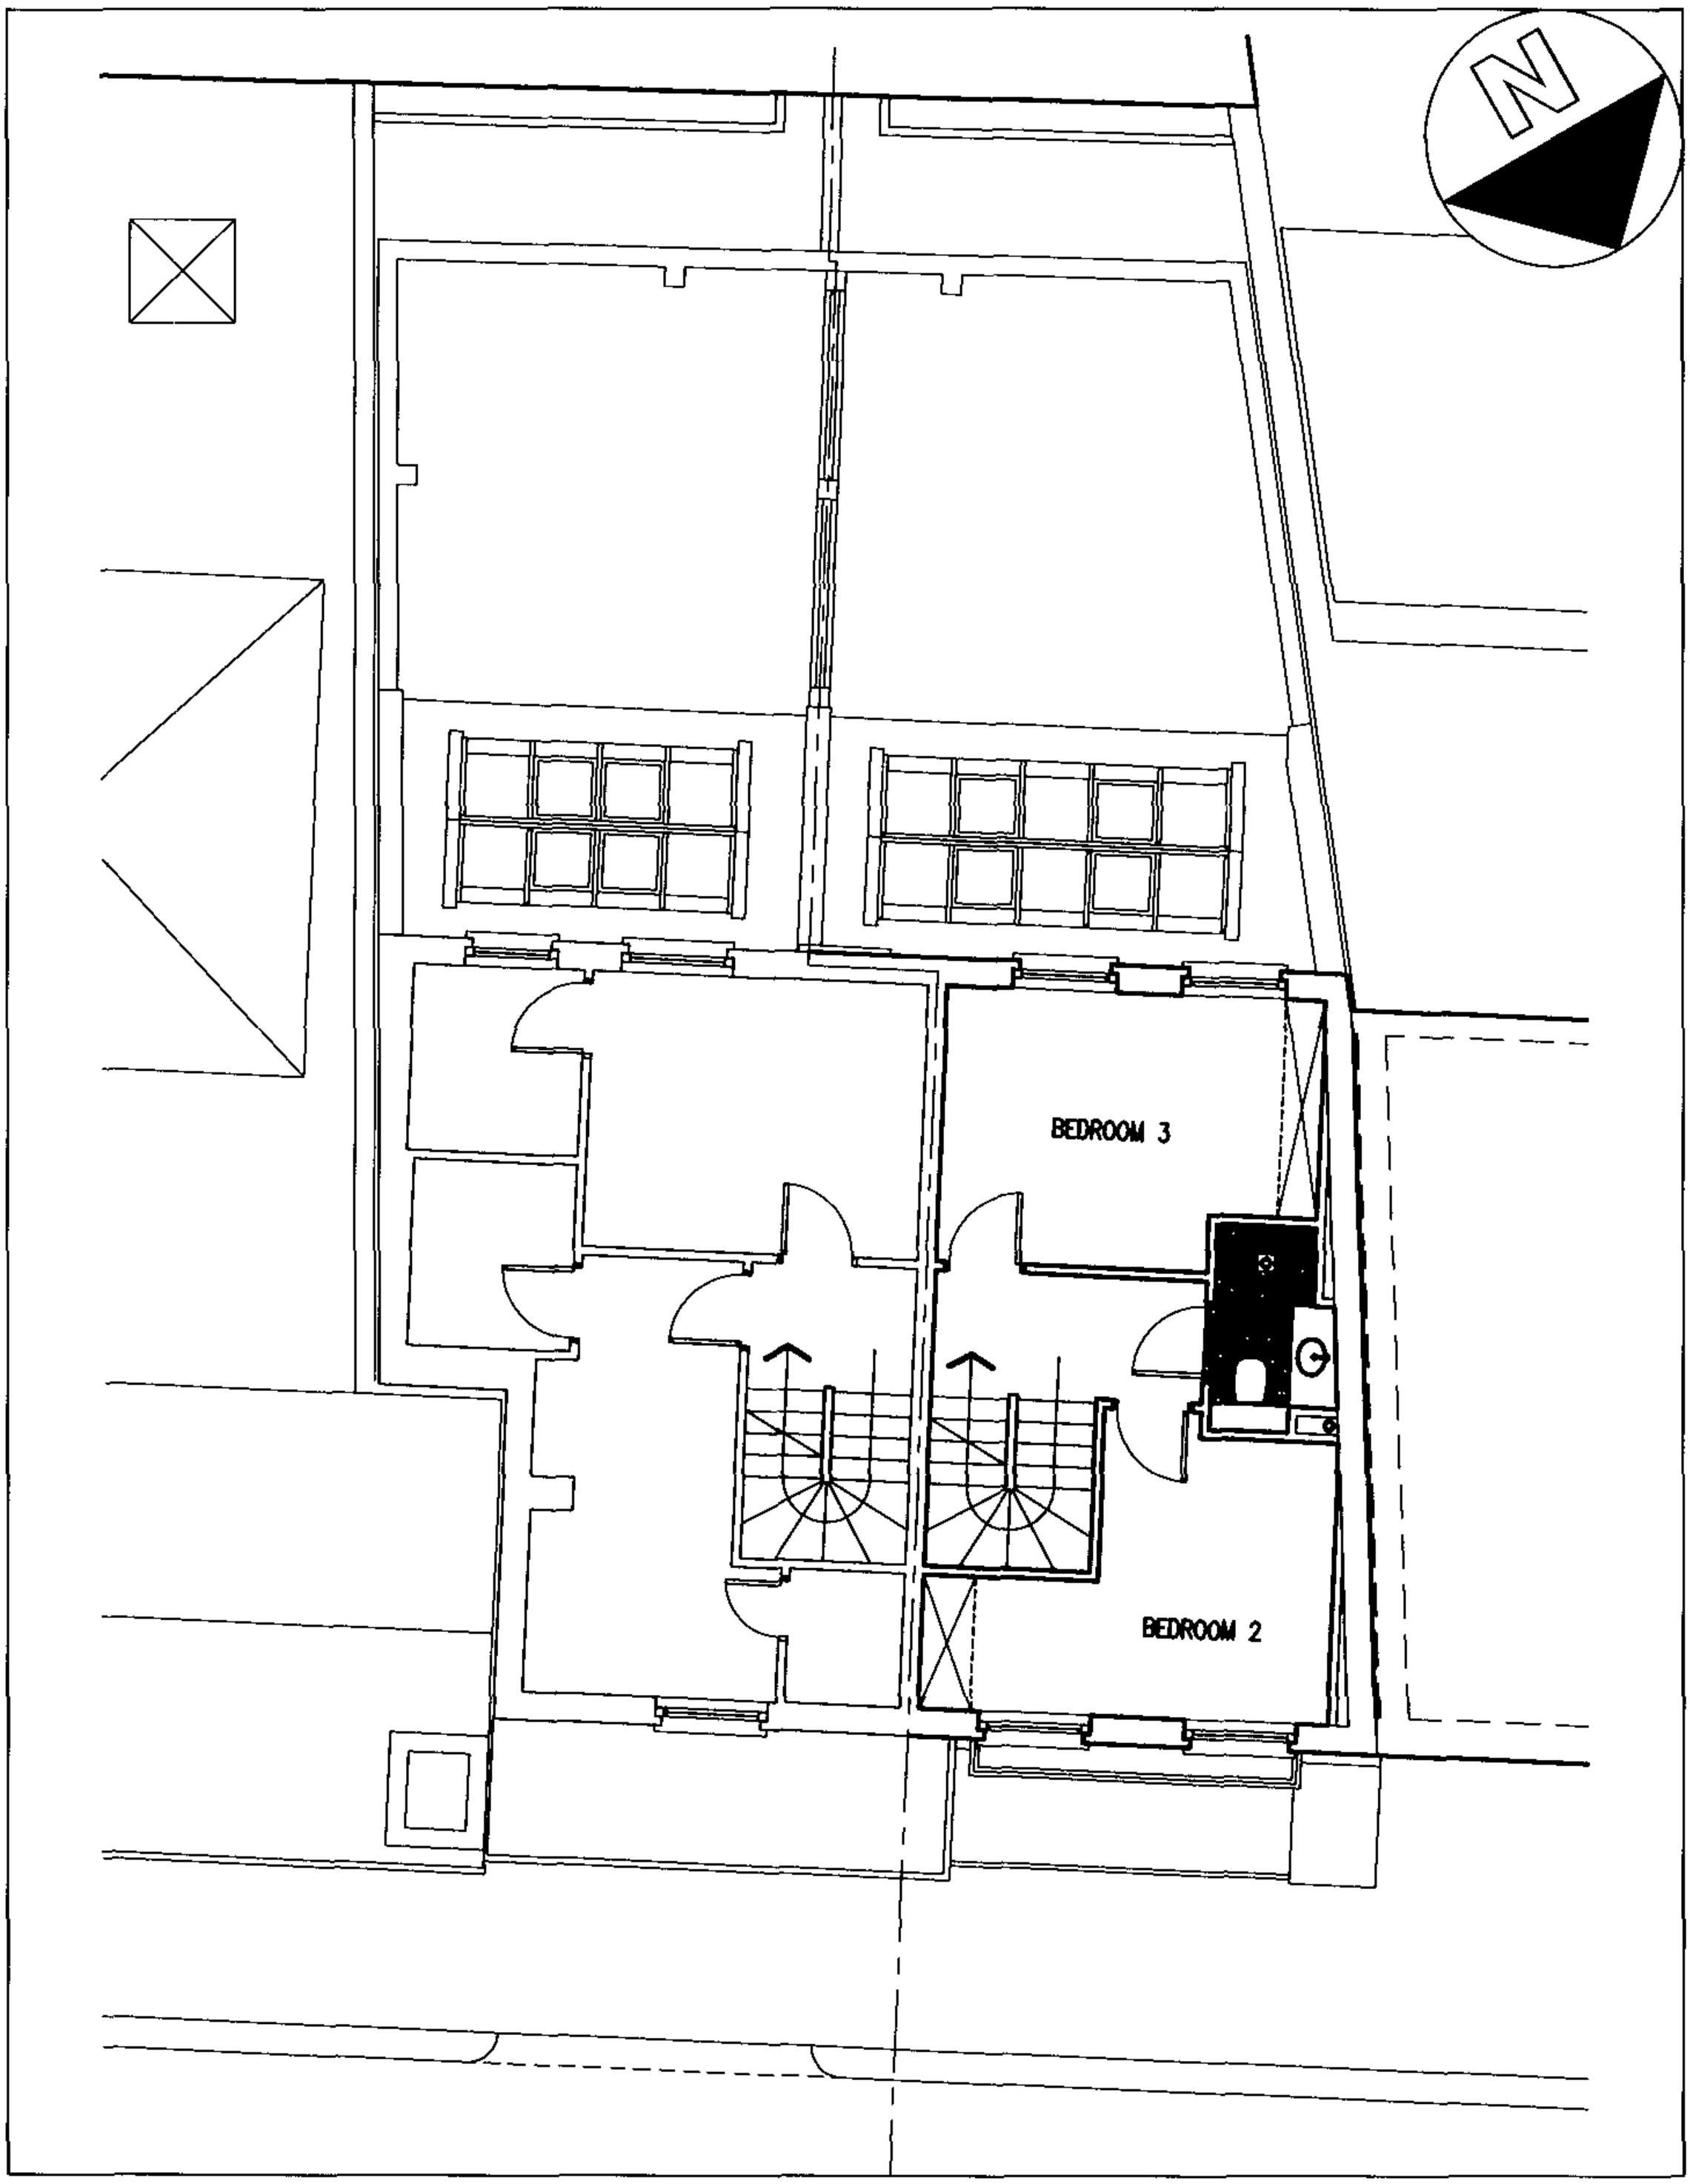

SUBJECT TO SITE SURVEY AND ALL RELEVANT STATUTORY AUTHORITY APPROVALS.

AS-BUILT DRAWING

Project: 89C REGENT'S PARK ROAD – LONDON NW1			Job No: 784
Drawing: EXISTING THIRD FLOOR PLAN			Drg.No: 05
Scale: 1:100 @ A4	Date: 24:07:2006	Drawn: DKC	CAD Ref: 784/05.dwg

Derek Copeman
Architect.

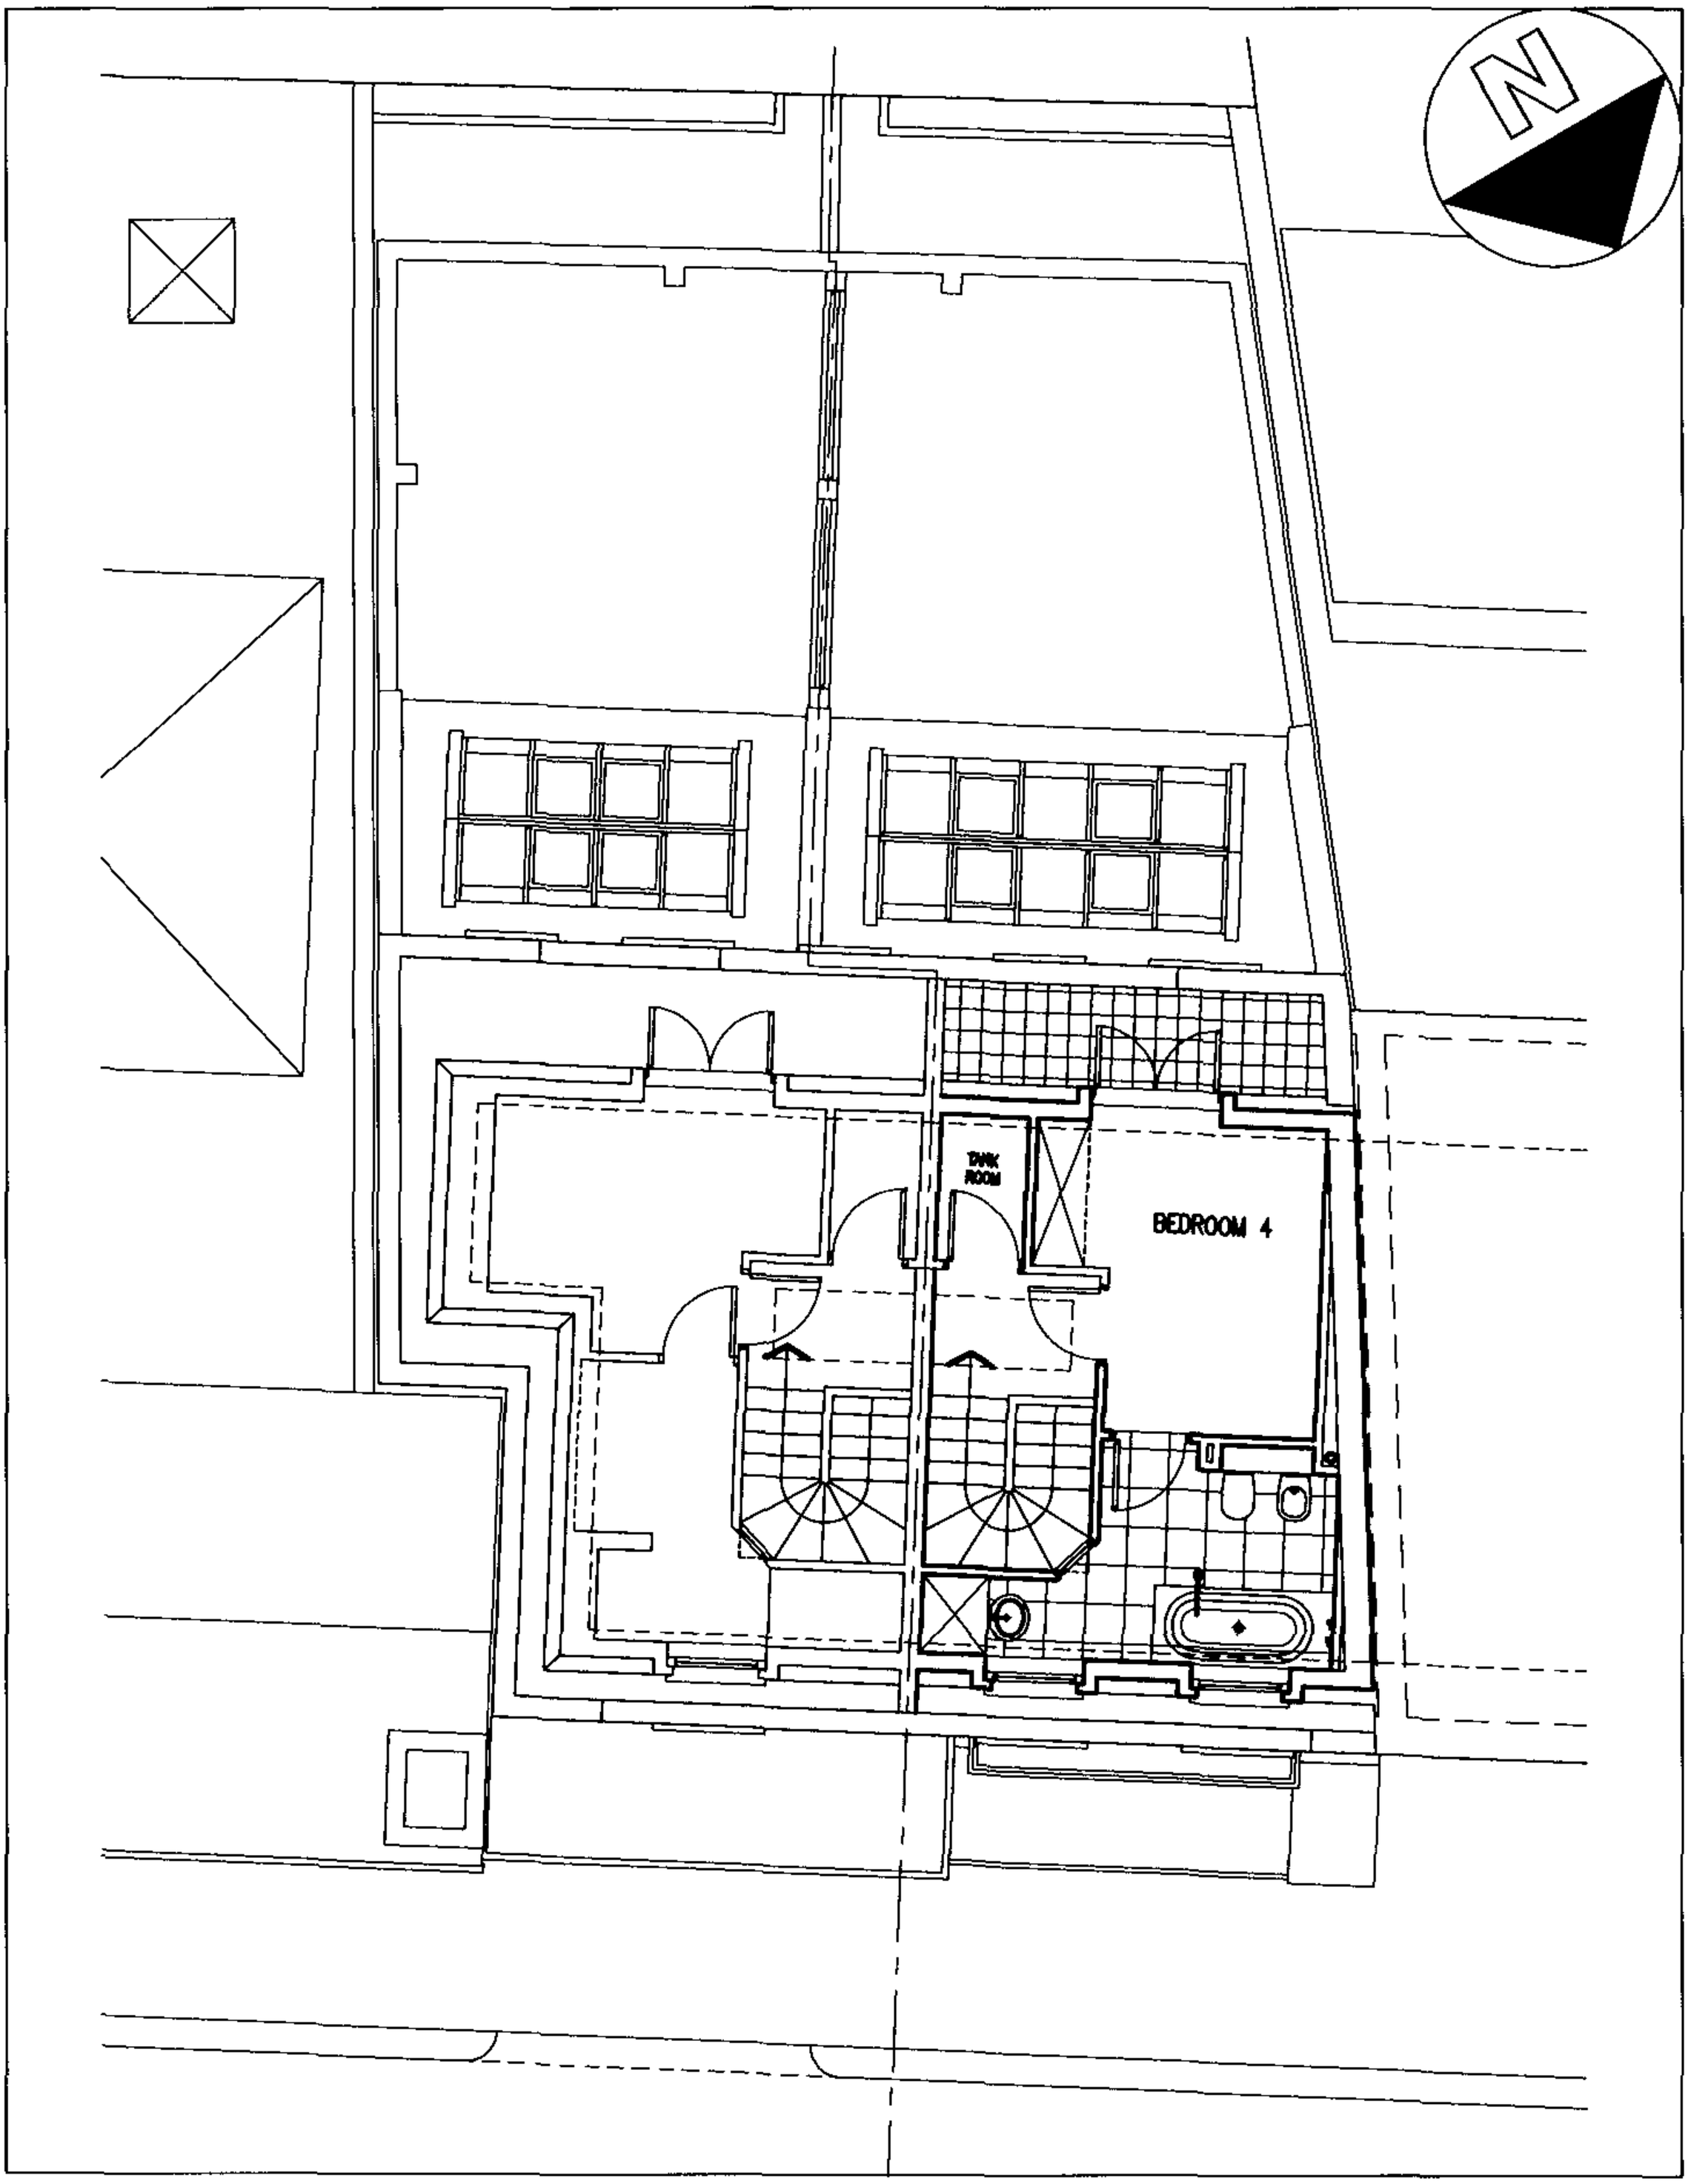

SUBJECT TO SITE SURVEY AND ALL RELEVANT STATUTORY AUTHORITY APPROVALS.

AS-BUILT DRAWING

Project:	89C REGENT'S PARK ROAD – LONDON NW1	Job No:	784
Drawing:	EXISTING FOURTH FLOOR PLAN	Drg.No:	06
Scale: 1:100 @ A4	Date: 24:07:2006	Drawn: DKC	CAD Ref: 784/06.dwg

Derek Copeman
Architect.

SUBJECT TO SITE SURVEY AND ALL RELEVANT STATUTORY AUTHORITY APPROVALS.

AS-BUILT DRAWING

Project: 89C REGENT'S PARK ROAD – LONDON NW1			Job No: 784
Drawing: EXISTING FRONT ELEVATION			Drg.No: 07
Scale: 1:100 @ A4	Date: 24:07:2006	Drawn: DKC	CAD Ref: 784/07.dwg

Derek Copeman Architect.

Planning • 3D Visualisation
Interior Design • Construction Management
CDM Consultants • Project Management

SUBJECT TO SITE SURVEY AND ALL RELEVANT STATUTORY AUTHORITY APPROVALS.

AS-BUILT DRAWING

Project:	89C REGENT'S PARK ROAD – LONDON NW1			Job No: 784
Drawing:	EXISTING REAR ELEVATION			Dwg.No: 08
Scale: 1:100 @ A4	Date: 24:07:2006	Drawn: DKC		CAD Ref: 784/08.dwg

Derek Copeman
Architect.

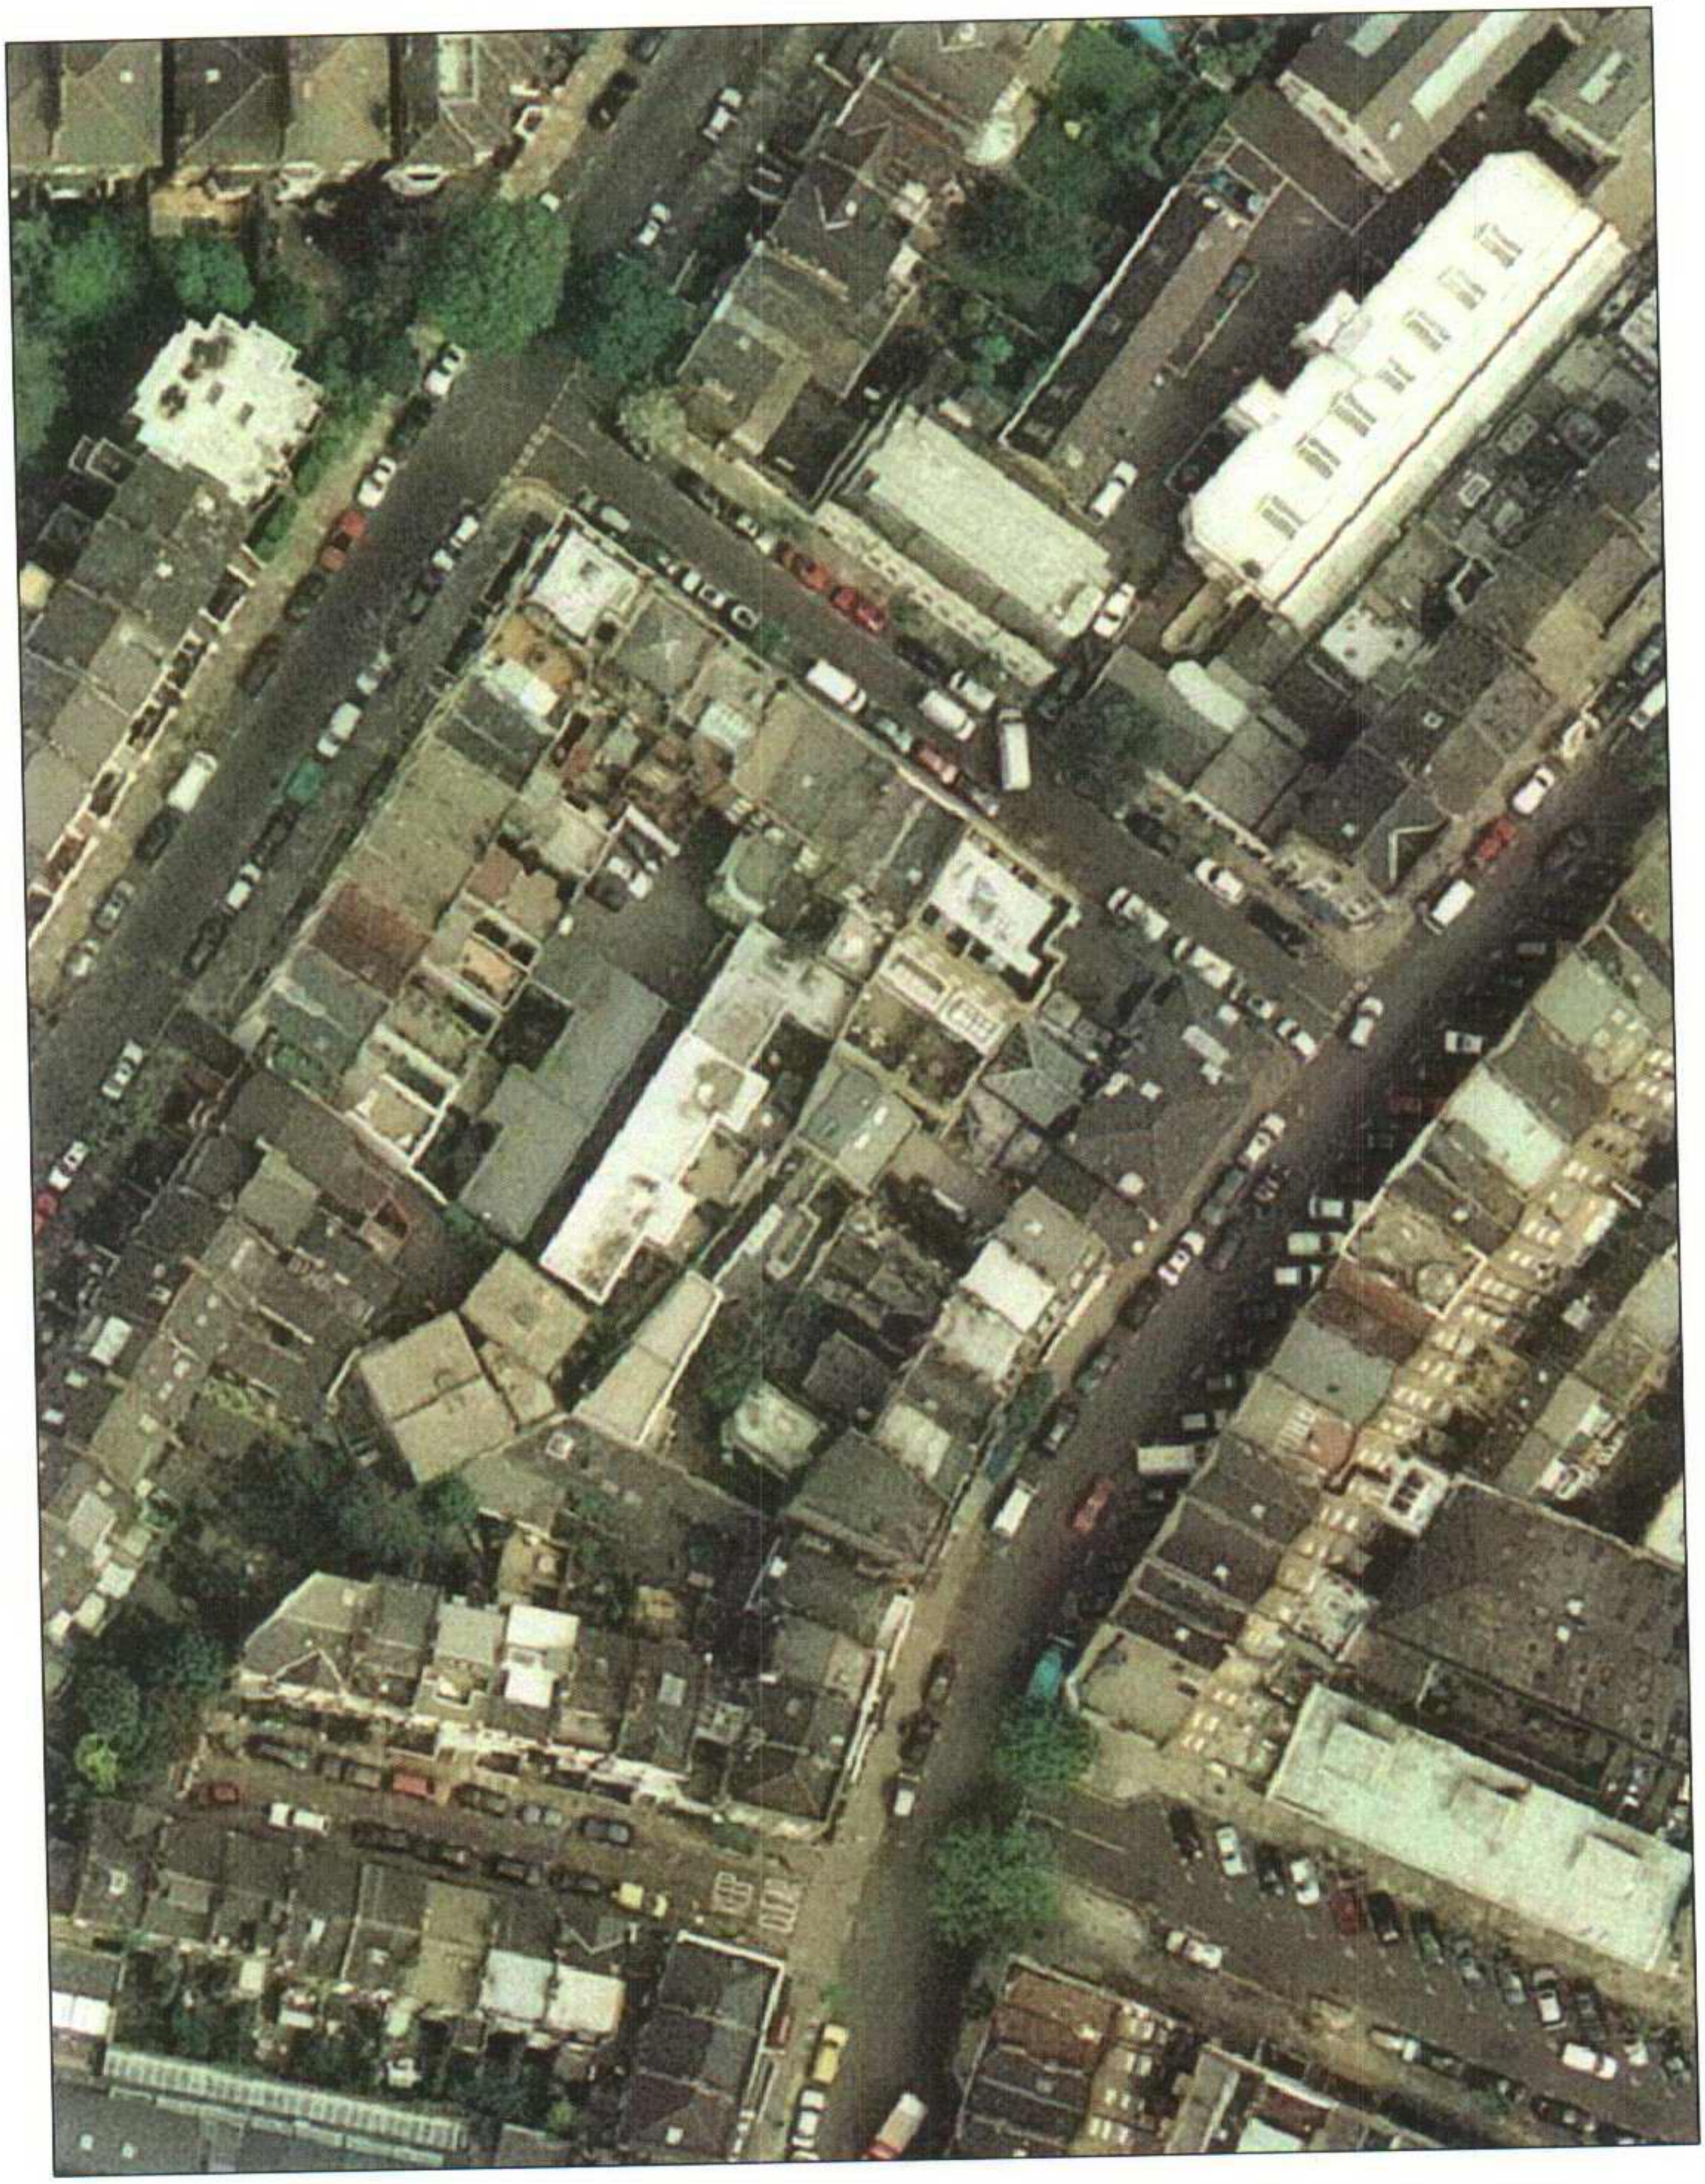

Project:	89C REGENT'S PARK ROAD – LONDON NW1		Job No: 784	Derek Copeman Architect.
Drawing:	EXISTING AERIAL PHOTOGRAPH		Drg.No: EP–01	Architecture • Planning • 3D Visualisation Interior Design • Construction Management CDM Consultants • Project Management
Scale: NTS	Date: 21:08:2006	Drawn: DKC	CAD Ref: 784/EP–01.dwg	

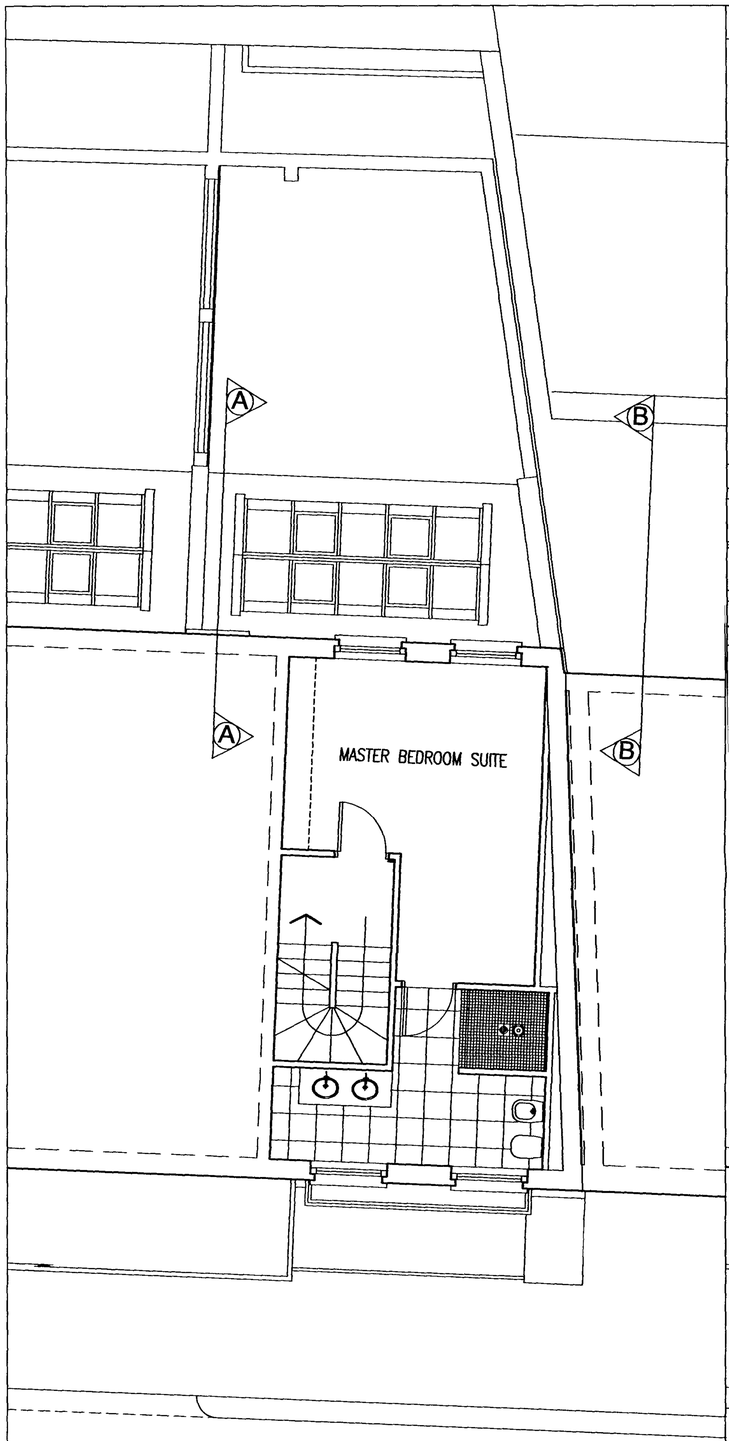

EXISTING SECOND FLOOR PLAN
Scale 1:50

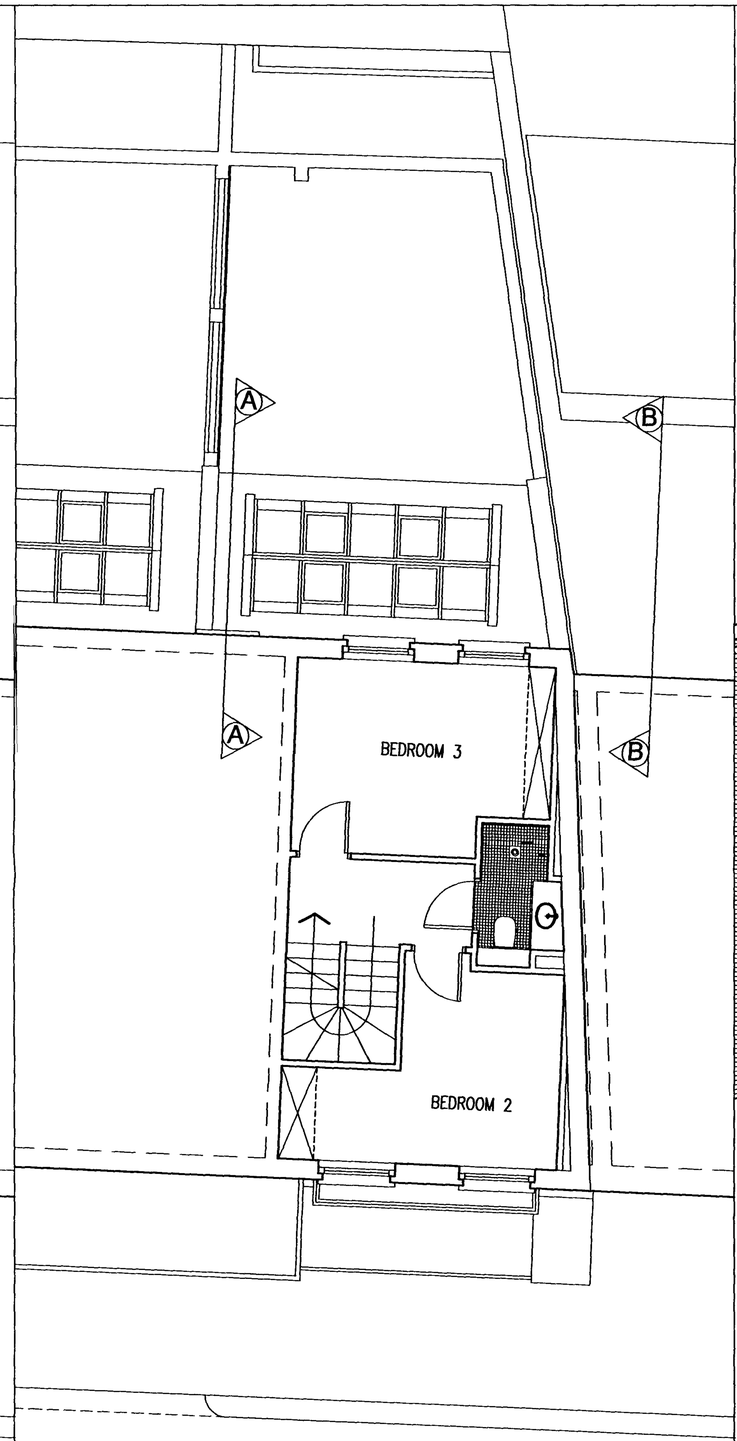

EXISTING THIRD FLOOR PLAN
Scale 1:50

EXISTING REAR ELEVATION
Scale 1:50

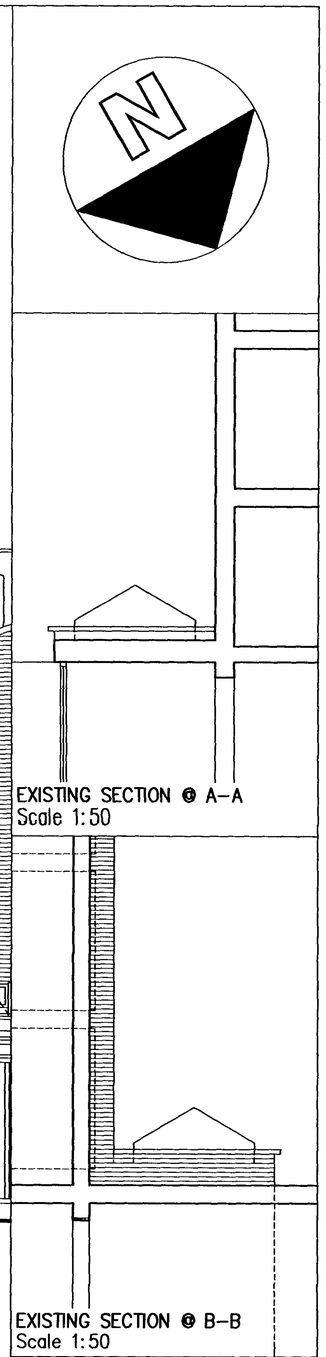

EXISTING SECTION @ A–A
Scale 1:50

EXISTING SECTION @ B–B
Scale 1:50

PLANNING DRAWING

Derek Copeman
Architect.
Architecture • Planning • 3D Visualisation
Interior Design • Construction Management
CDM Consultants • Project Management
Unit 2 Riverside Yard, Albion Street, Southwick, Brighton BN42 4AW
e-mail: derek.copeman@btopenworld.com
Tel: +44 (0)1273 591822
Fax: +44 (0)870 0053518

Project: 89C REGENT'S PARK ROAD

Drawing: EXISTING SECOND & THIRD FLOOR PLANS

Scale:	Date:	Drawn:	Checked:	CAD Ref:
1:50	24:07:2006	DKC	EG	784–100.dwg

784 · 100