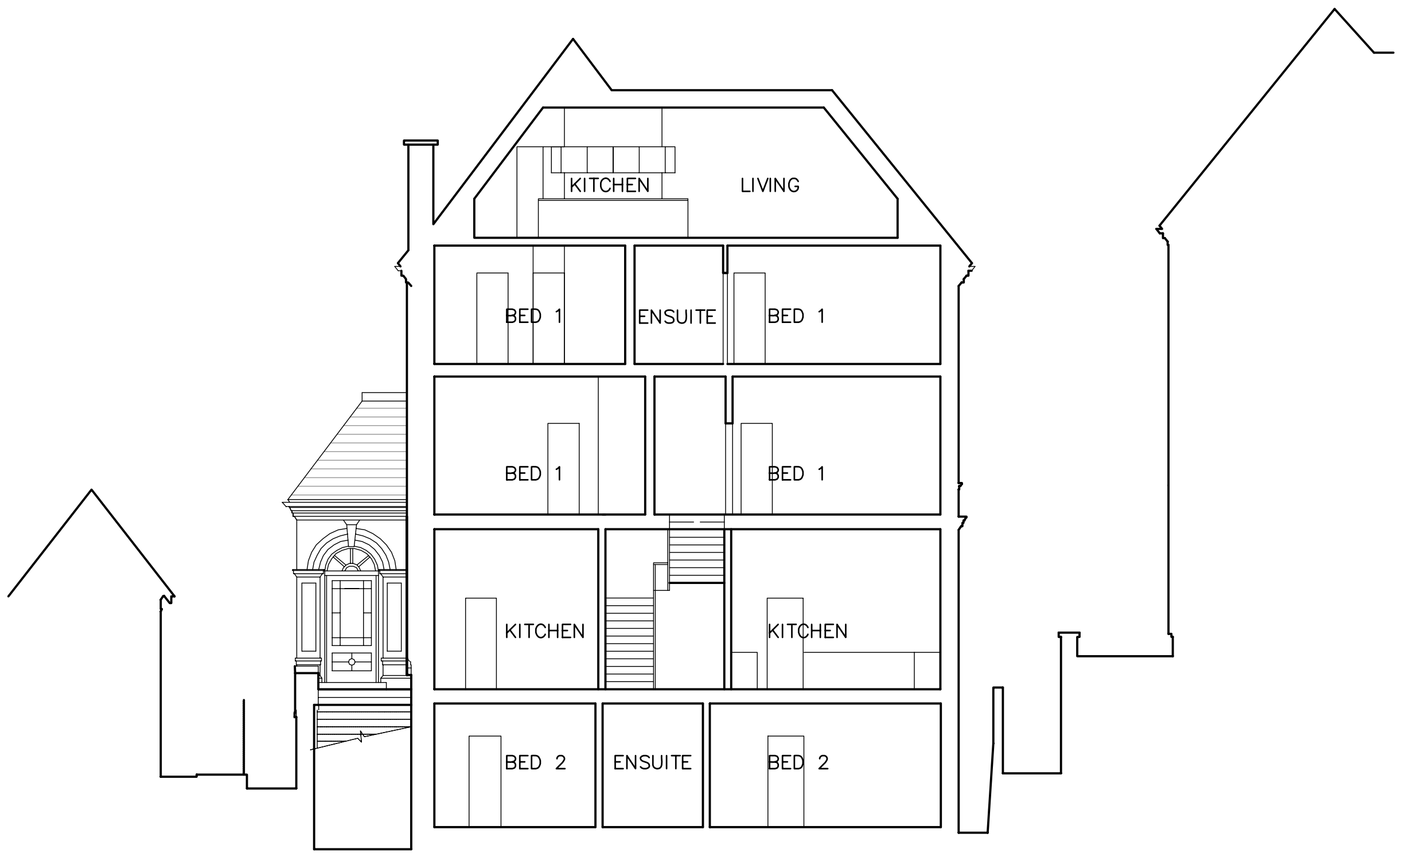

SECTION E–E

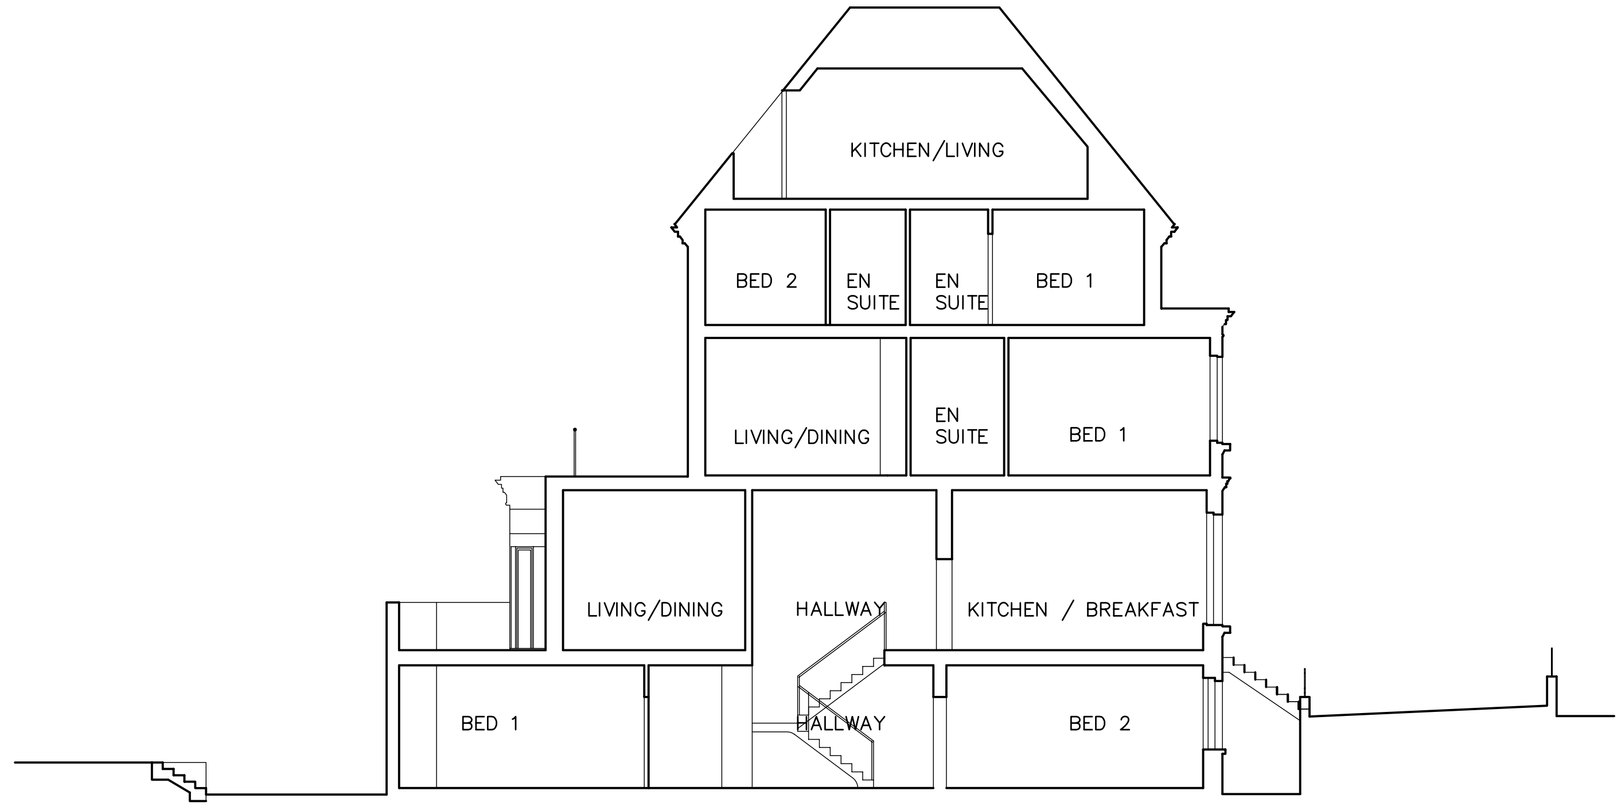

SECTION F–F

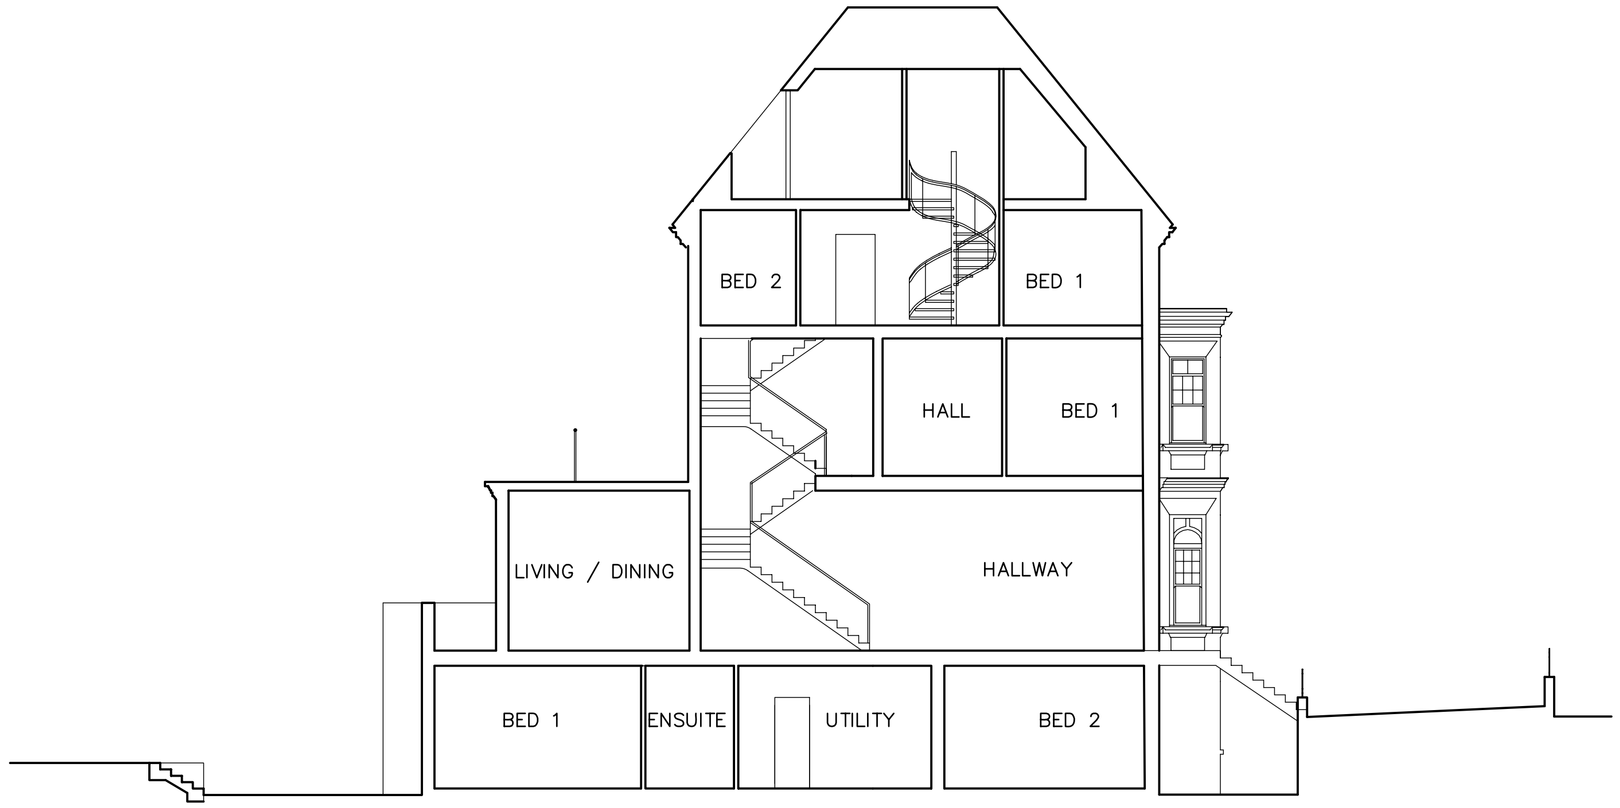

SECTION G–G

REVISIONS

B	SCHEME REVISED TO ACCORD WITH PLANNING REQUIREMENTS	SEPT 2003
C	GENERAL REVISIONS TO ACCORD WITH PLANNING REQUIREMENTS	OCT 2003
D	SECTIONS ALTERED FOLLOWING CHANGES TO REAR EXTENSIONS TO FIRST AND SECOND FLOORS, TO ACCORD WITH LATEST PLANNING REQUIREMENTS	DEC 2003
E	2NO ROOFLIGHTS SHOWN ON NORTH ELEVATION AS BUILT TO BE SUBMITTED AS PART OF A NEW SEPARATE PLANNING APPLICATION.	SEPT 2006
	ALTERATION TO ROOF OF MID–SECTION BAY EXTENSION TO UPPER GROUND LEVEL CHANGED FROM PITCHED ROOF TO FLAT ROOF, AS BUILT TO BE SUBMITTED AS PART OF A NEW SEPARATE PLANNING APPLICATION.	

GCK ARCHITECTS LIMITED

6 FIELD WAY
CAMBRIDGE
CB18RW

TEL 01223 411631
MOBILE 07860 650239
FAX 01223 512078

Project: 27 FITZJOHNS AVENUE
LONDON NW3

Project No:

Dwg Rev

Title: PROPOSED SECTIONS

Type Elem No.

Scale 1:100@A1 Date FEB 2003

78(PL).14 E