EXTERNAL FINISHES:

DORMER WALLING — PLAIN TILING TO MATCH EXISTING ROOF

DORMER ROOFING — FELT

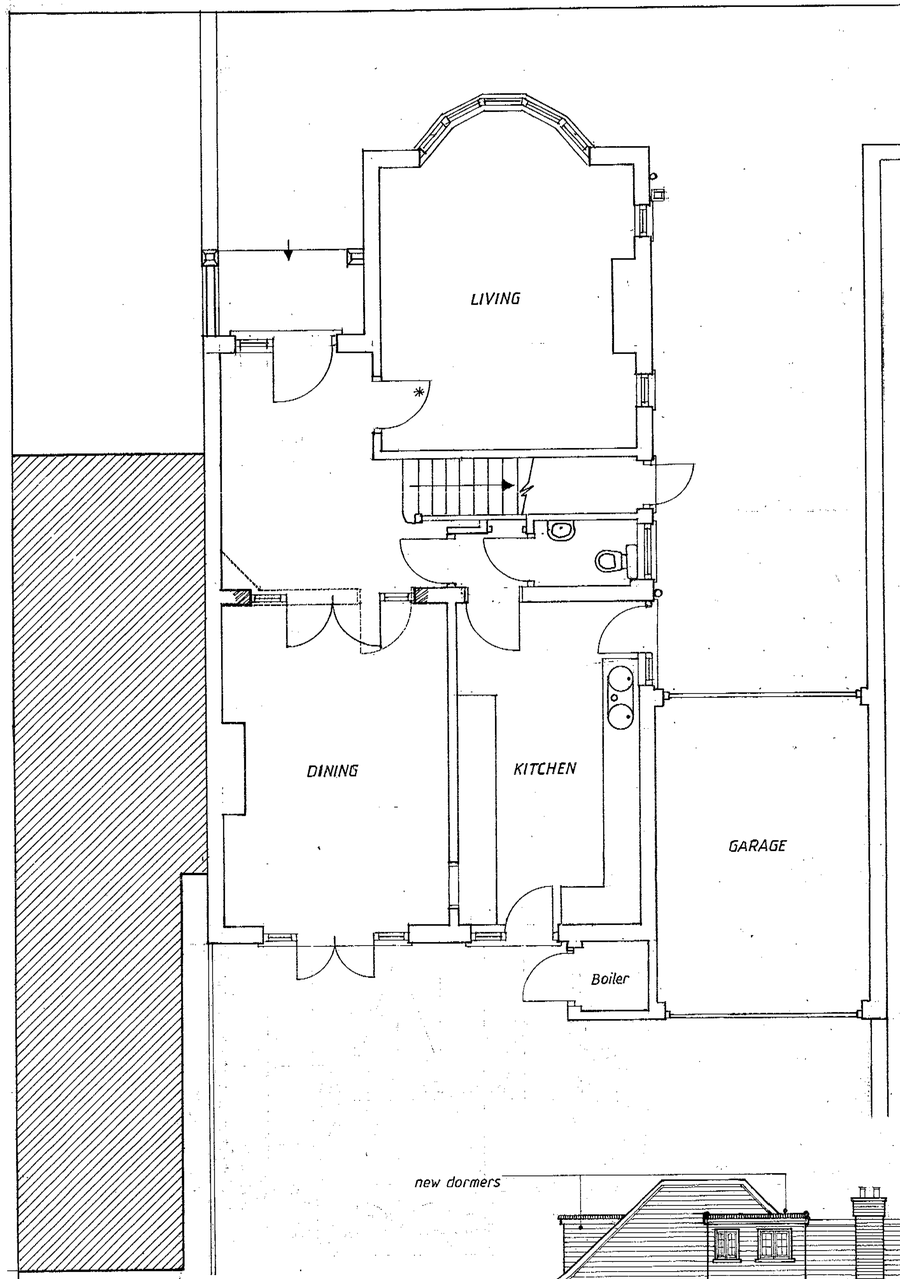

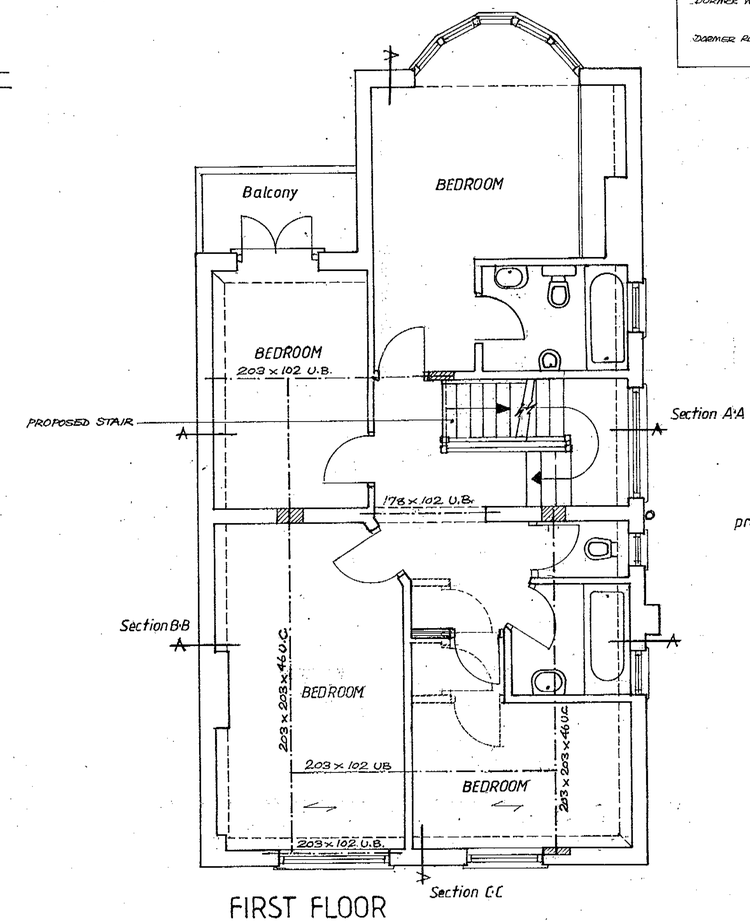

FIRST FLOOR

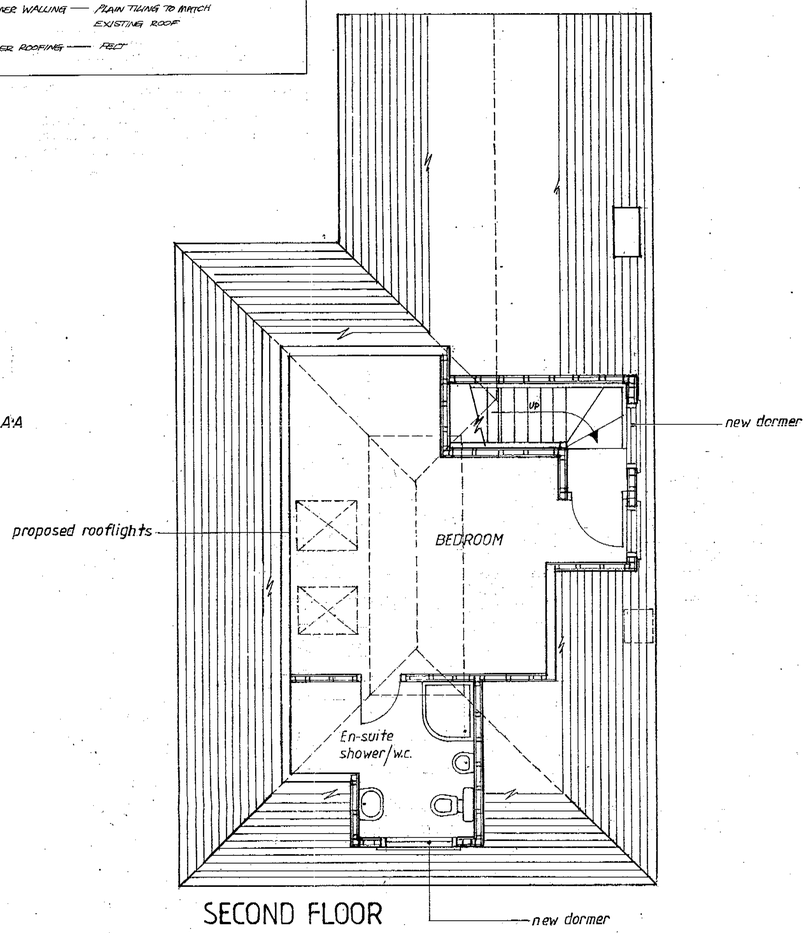

SECOND FLOOR

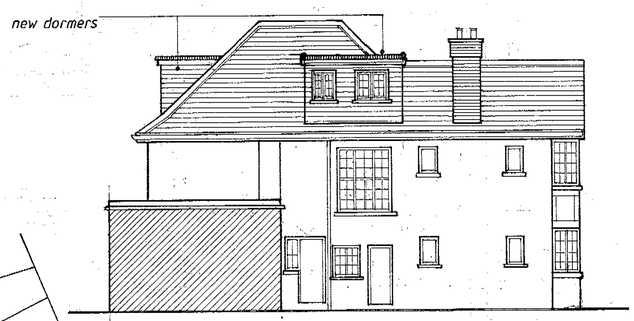

SIDE ELEVATION

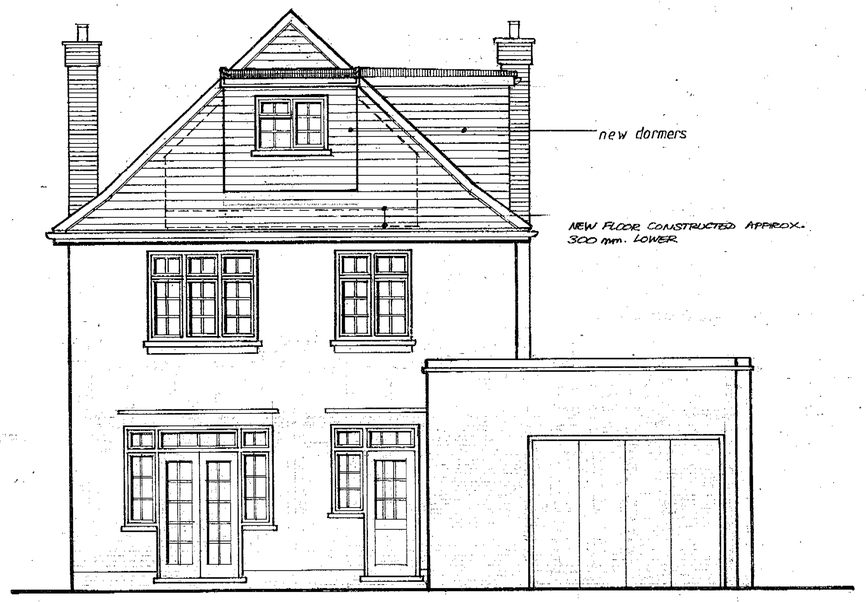

REAR ELEVATION

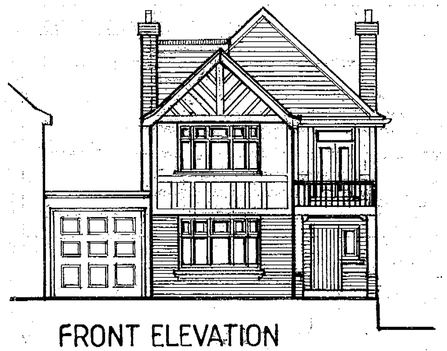

FRONT ELEVATION

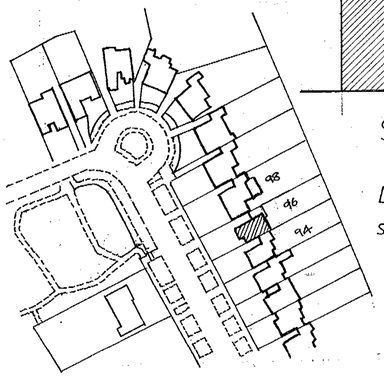

LOCATION PLAN

Scale 1:1250

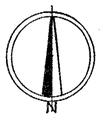

PROPOSED IMPROVENTS & ENLARGEMENT OF ROOF ROOM

WITH SIDE & REAR DORMERS (AS CONSTRUCTED)

96 Hillway Highgate N6

SCALE 1:50

JUNE 2004

DRG.NO. 635/5

ABBOTTS BUILDING CONTRACTORS LTD.

Tel. 020 8807 7336