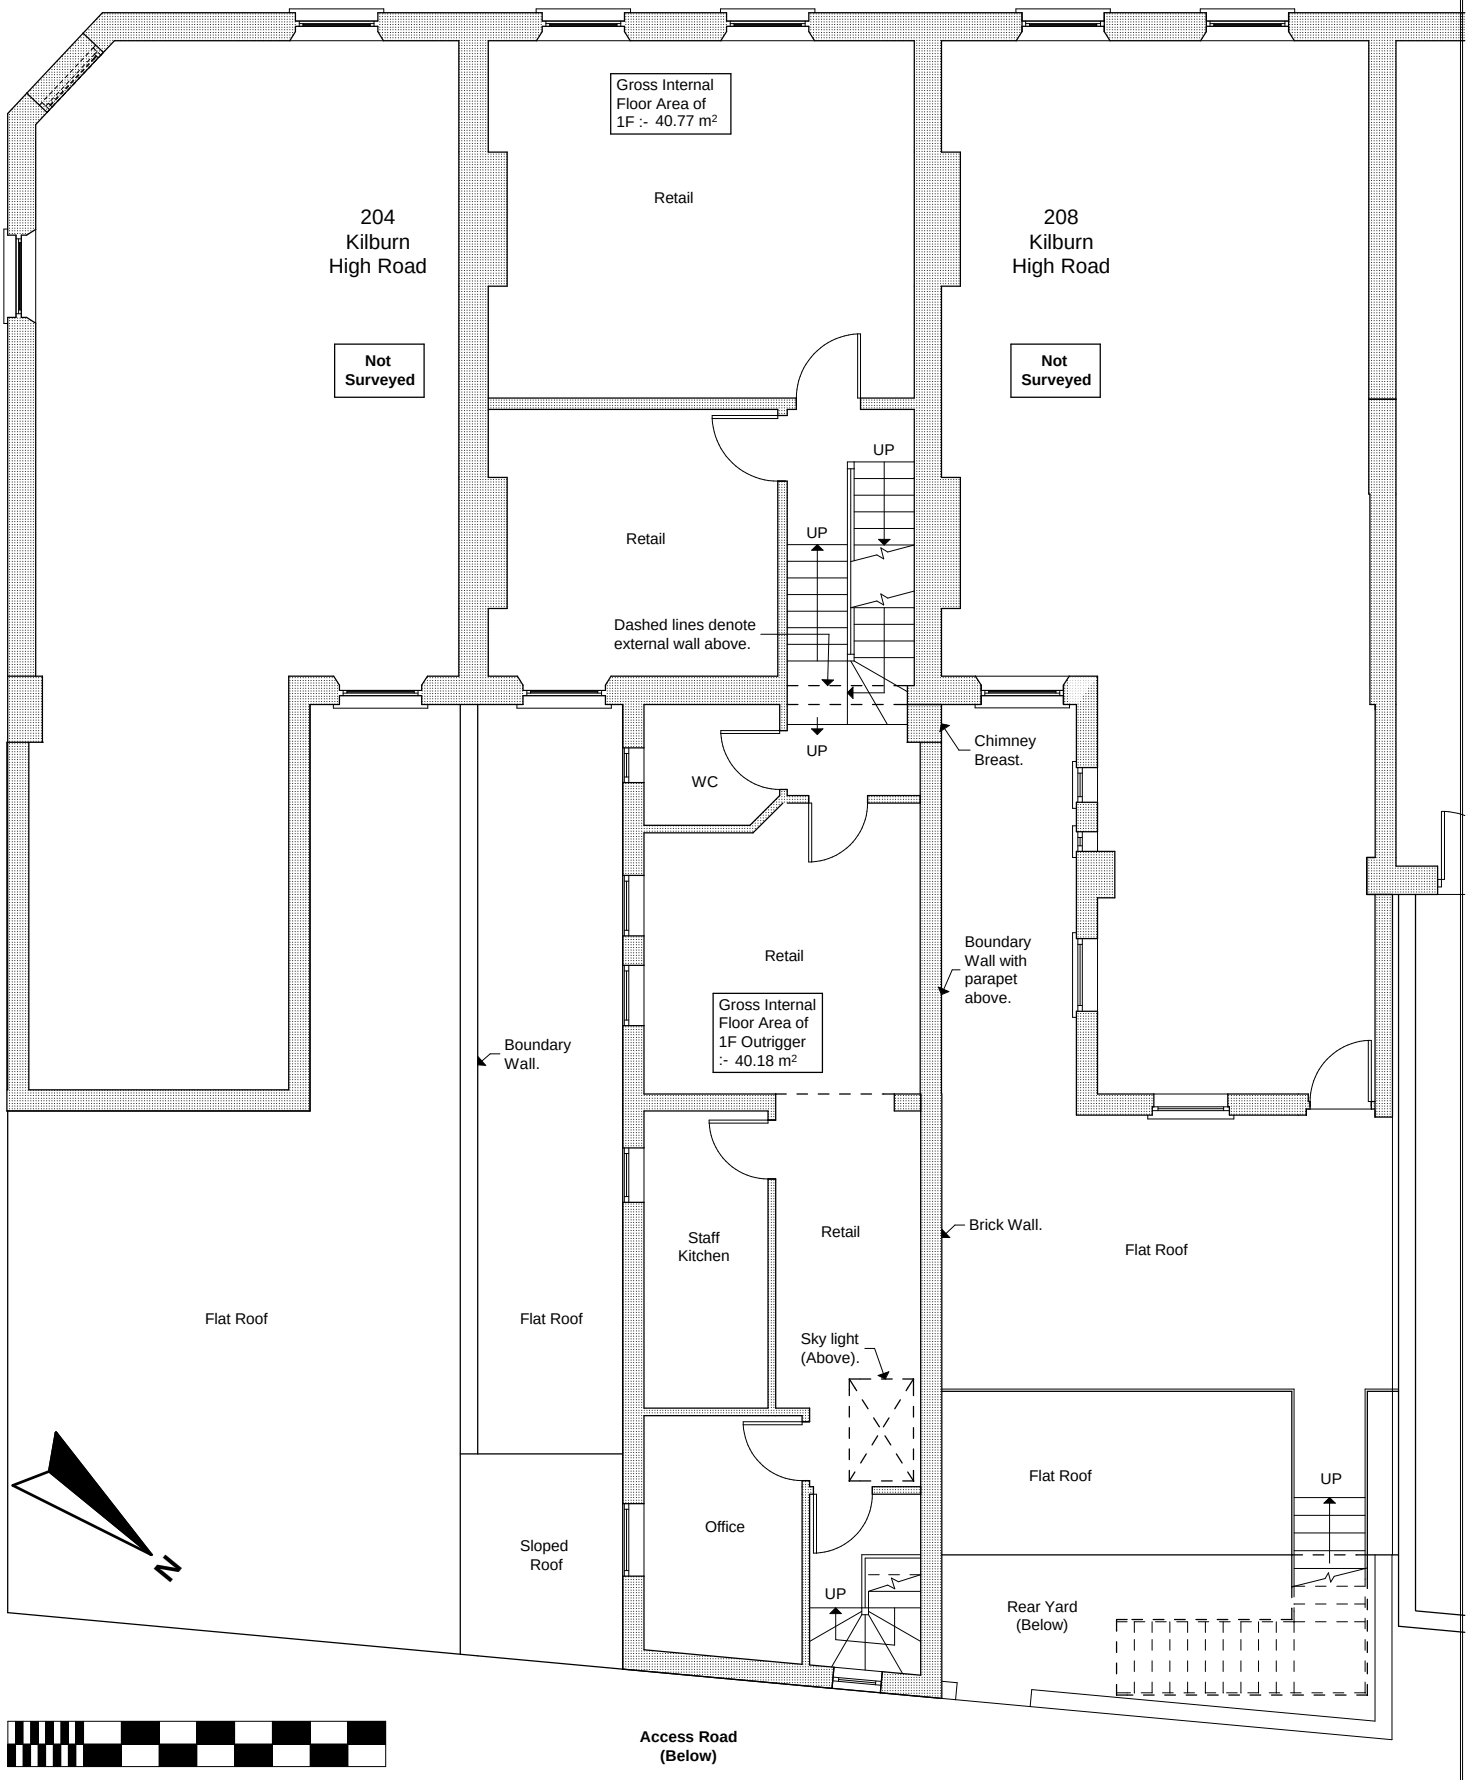

			File ref: 1085 - AB - Plans 7.pln	(3)	© Copyright
Project: 2F & 3F, 206 Kilburn High Road		Drawing size: A4	Preliminary	Rev / Date	
Client: Mr Amit Natha	Date: Aug 14	Scale: 1:100	Planning ■ / Building Regs / Tender / Construction / As Built ■		
Drawing: Existing 1F Plan	Reference Number: 1085-BA-122				

ARCHITECTS
DONALD SHEARER
CHARTERED ARCHITECTS
Scholar's House, Shottery Brook Office Park, Timothy's Bridge Road, Stratford-upon-Avon, Warwickshire, CV37 9NR
Tel : 01789 294 560
Fax : 01789 294 549
donald@ds-architects.demon.co.uk