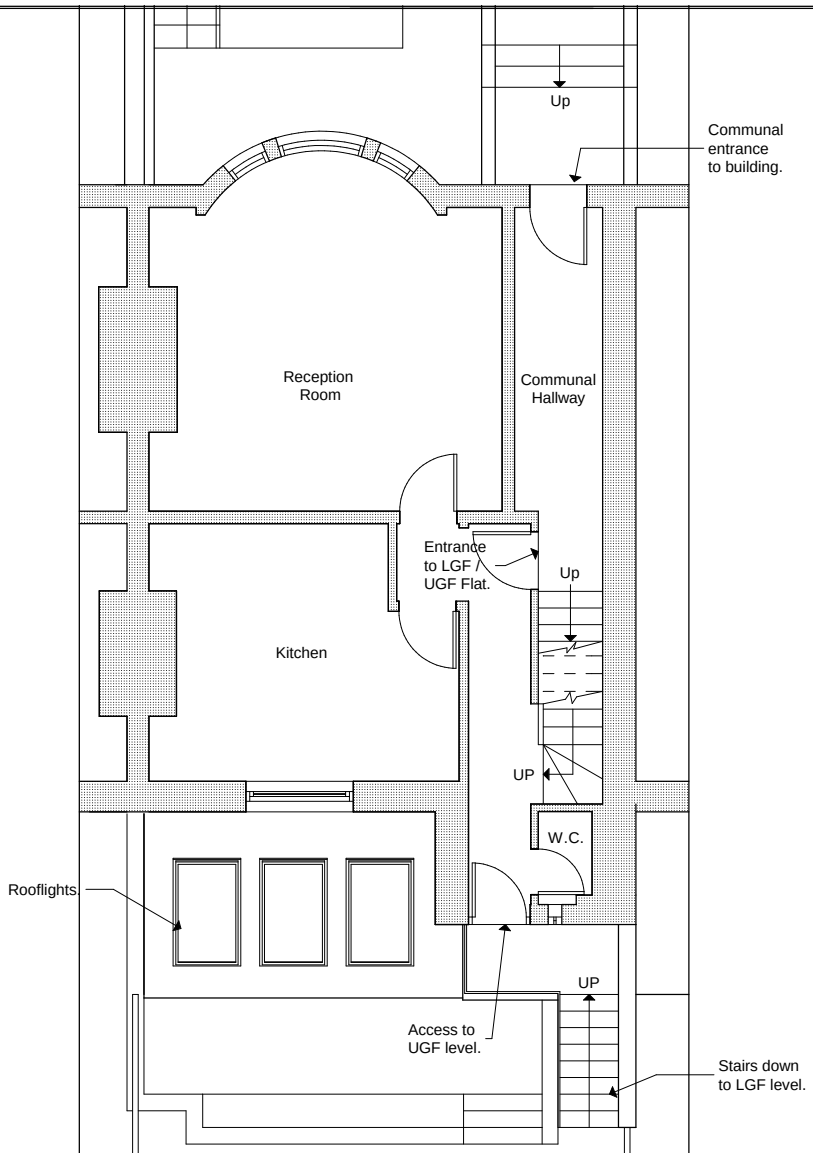

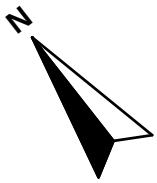

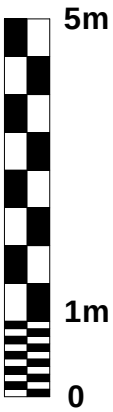

8 Bolton Road

6 Bolton Road

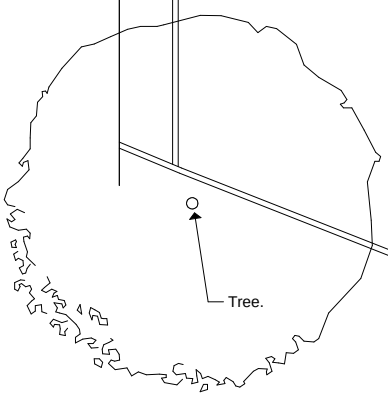

Preliminary	
Planning	■
Building Regs.	
Tender	
Construction	
As-built	■

File Ref: 1137AB007.pln © Copyright

ARCHITECTS
DONALD SHEARER
CHARTERED ARCHITECTS

Scholar's House, Shottery Brook Office Park,
Timothy's Bridge Road, Stratford-upon-Avon,
Warwickshire, CV37 9NR

Tel: 01789 294 560
Fax: 01789 294 549
donald@ds-architects.demon.co.uk

Project	7A Bolton Road
Client	Litven Limited
Drawing	Existing UGF Plan

Date	Scale	Drawing size
Aug 14	1:100	A4

Reference Number	1137-BA-103

Rev	Date	