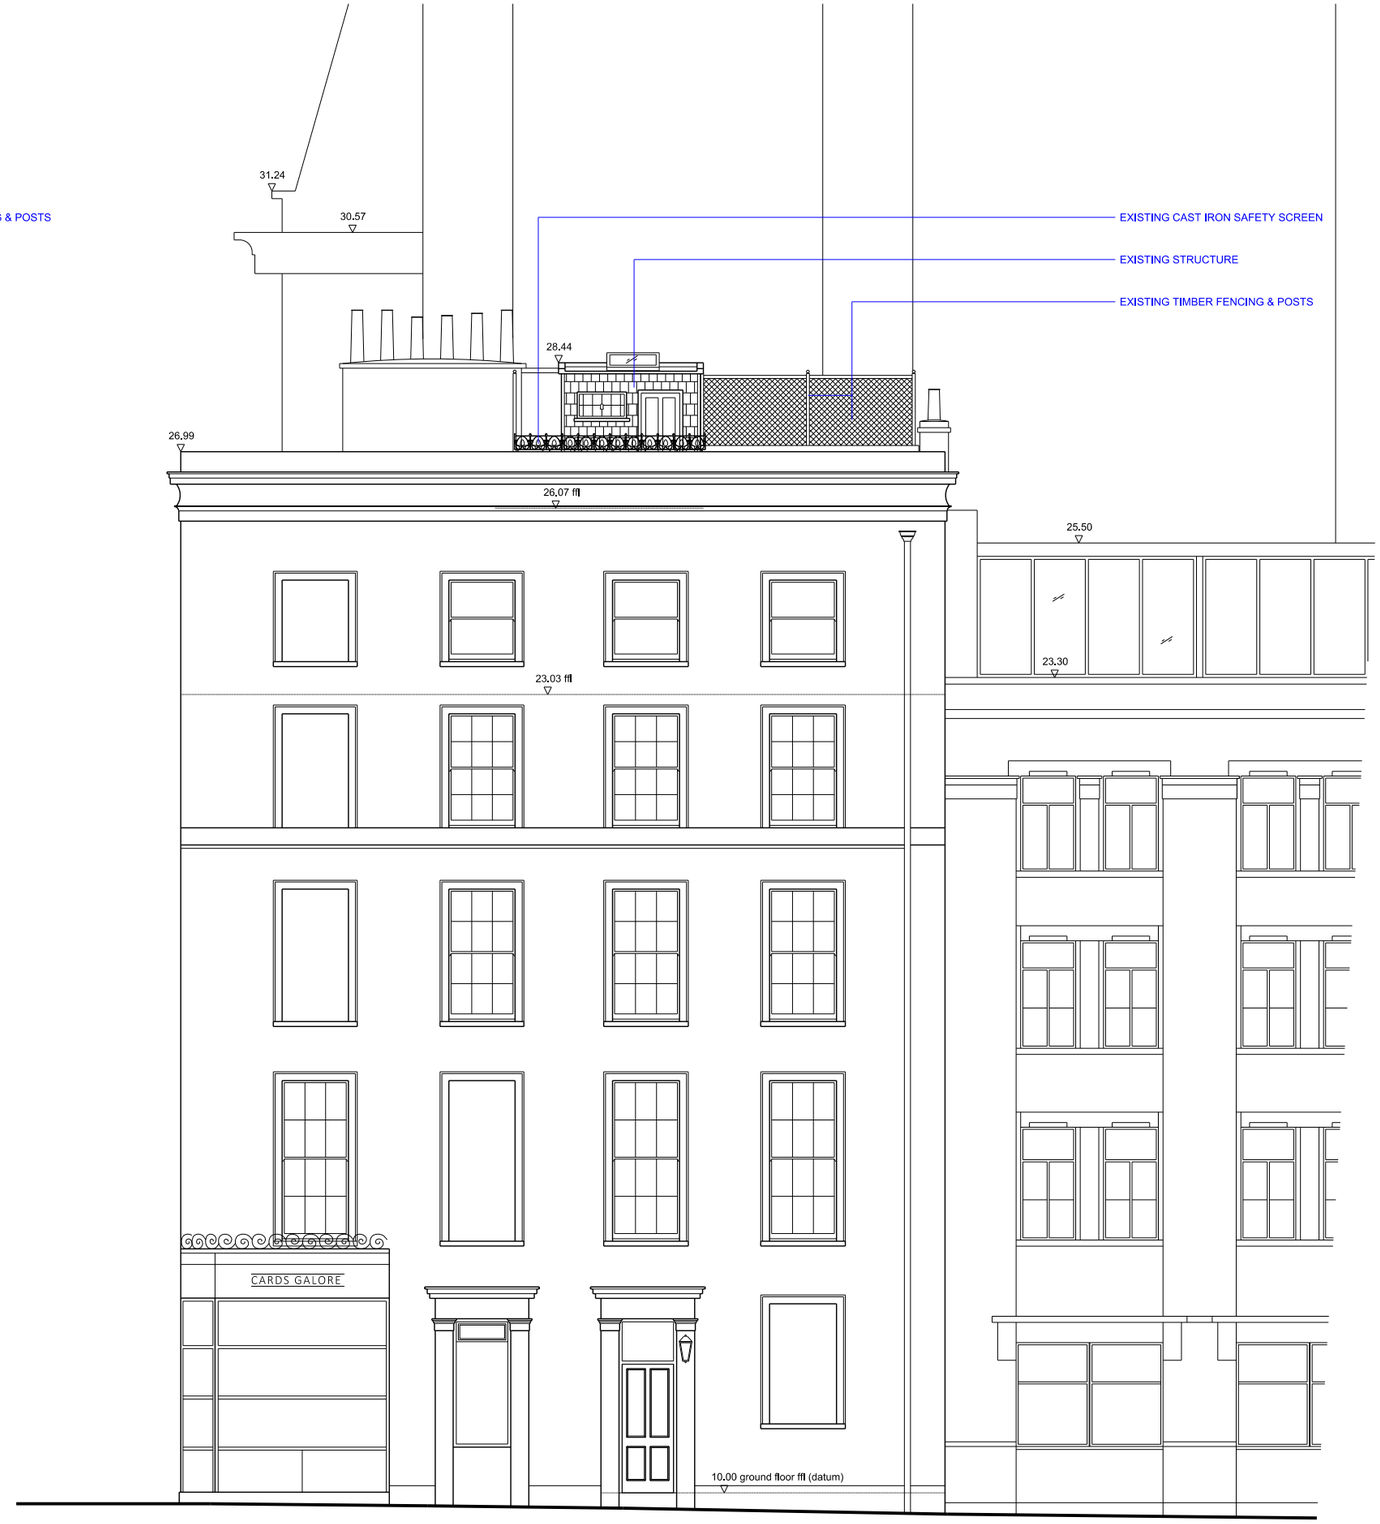

NOTES
1. Do not scale.
2. Contractors to check dimensions of all Issued drawings on site.
3. This drawing is copyright.

Revision	Date

NOTE:

The application only relates to fourth floor and above (no changes to floors below).

The existing roof is retained/in-tact and there is no loss of historic fabric.

Drawing Status: PLANNING	Client: PAUL BENTALL Project: 207 HIGH HOLBORN, LONDON WC1V 7BW
Drawing Title: EXISTING (AS BUILT) ELEVATIONS	**Architecture & Design**
Drawing No: 1443 EX 002 — Rev. -	Battersea Studios 80 Silverthorne Road London SW8 3HE ++44 (0)20 7436 4050 architecture@tectus.co.uk www.tectus.co.uk
Date: OCTOBER 2015 — Drawn	**tectus**
Scale: 1:50 @ A1 / 1:100 @ A3 — Checked	