W.P.G.SURVEYS
LAND SURVEYORS
MEADWAY HOUSE, 17-21 BRIGHTON ROAD
SURBITON, SURREY, KT6 5LR
TEL.020 8390 2711 FAX.020 8390 6277

SITE

69 KENTISH TOWN RD
LONDON
NW1 8NY

DRAWING

FLOOR PLANS

SCALE	DATE	JOB NO
1:100	JULY 2015	5153
SURVEYED BY SP.CP		DRAWING NO 01
DRAWN BY SP		

FOR

ARTHURELL
& KIRKLAND

LEVELS RELATE TO :-

OSBM SITUATEDED ON 156-170 KENTISH TOWN ROAD. VALUE 27.08m

ON DETAIL SURVEY

AB	AIR BRICK	JB	JUNCTION BOX
AC	AIR COMPRESSOR	LBX	LETTER BOX
ACU	AIR CONDITIONING UNIT	LC	LAMP COLUMN
AL	AIR LINE	LT	LIGHT
ASP	ARTIFICIAL STONE PAVING	MHR	MANHOLE (SERVICED
AT	ADJ. TREE	MP	MILE POST
BB	BELISHA BEACON	MP	METAL POST
BW	BOLLARDS	NP	NEWSPAPER POST
BH	BORE HOLE	NR	NEWSPAPER RACK
BL	BED LEVEL	OH	OVER HEAD
BOLL	BOLLARD	OST	OIL STORAGE TANK
BS	BUS STOP	PB	POST BOX
BT	BRITISH TELECOM	PE	PATH ENDING
CAB	CABINET	PL	PAVEMENT LIGHT
CBK	COAL BUNKER	PM	PARKING METER
C.BOX	CONTROL BOX	PO	POLE SIGN
CE	CONTENTS GAUGES	RE	RODDING EYE
CI	CAST IRON	RFL	ROOF LEVEL
CL	COVER LEVEL	RS	ROAD SIGN
CPL	COAL PLATE	SB	SHRUB/PATT. BOX
CTV	CABLE TELEVISION	SNP	STREET NAME PLATE
DL	DOUBLE LINE	SRL	SINGLE RED LINE
DRL	DOUBLE YELLOW LINE	SYL	SINGLE YELLOW LINE
ELEC	ELECTRICITY	TCB	TELEPHONE CALL BOX
FAI	FRESH AIR INLET	TH	TRIAL HOLE
F.HYD	FLUSH HYD	TLCB	TRAFFIC LIGHT CONTROL BOX
FM	FOUL MANHOLE	TP	TELEGRAPH POLE
FLT	FLUSH LIGHT TONER	TRL	TRAFFIC LIGHT
FP	FLAG POLE	TS	TRIG STUMP
G	GULLY	TT	TOP OF TANK
GB	GAS GOVERNOR	TW	TOP OF WALL
GV	GAS VALVE	TF	TOP OF FENCE
HT	HEIGHT	UN	UNABLE TO LIFT
IC	INSPECTION COVER	UT	UNABLE TO TRACE
IL	INVERT LEVEL	VP	VENT PIPE
ILL	ILLUMINATED	WL	WATER LEVEL
IP	INSPECTION PLATE	WM	WATER METER
		WP	WOOD POST
		WV	WATER VALVE

ON FENCES/DIVISIONS

CPV	CONCRETE POST	/HB	HORIZONTAL BOARD
MPV	METAL POST	/IMP	INTERWOVEN PANEL
WPV	WOOD POST	/M	MESH
/RW	RAILWAY KERB	/MR	METAL RAIL
/CB	CLOSE BOARDED	/PR	PLASTIC RAIL
/CI	CORRUGATED IRON	/RL	REST LINK
/CL	CHAIN LINK	/VB	VERTICAL BOARD
/CP	CONCRETE PALING	/W	WIRE
/WP	WOODEN PALING	/WR	WIRE RAIL
		/WW	WIRE MESH

ON BUILDINGS
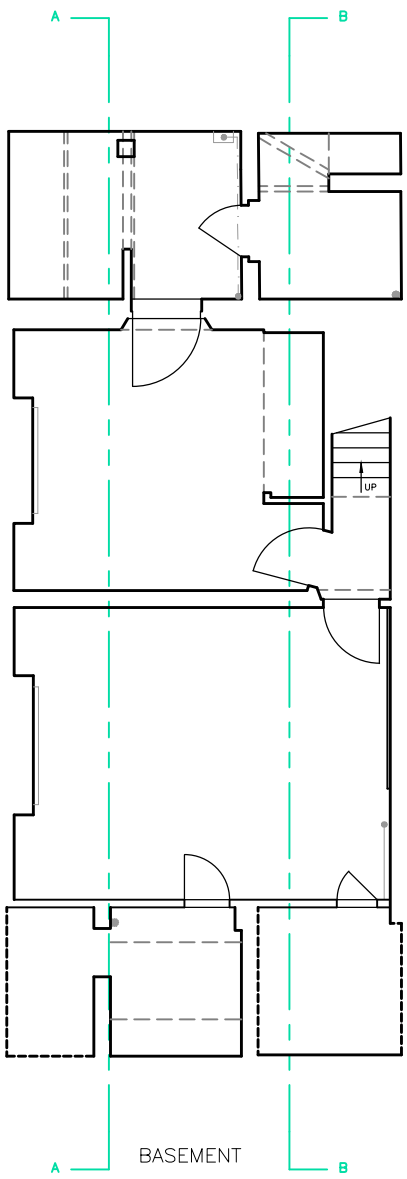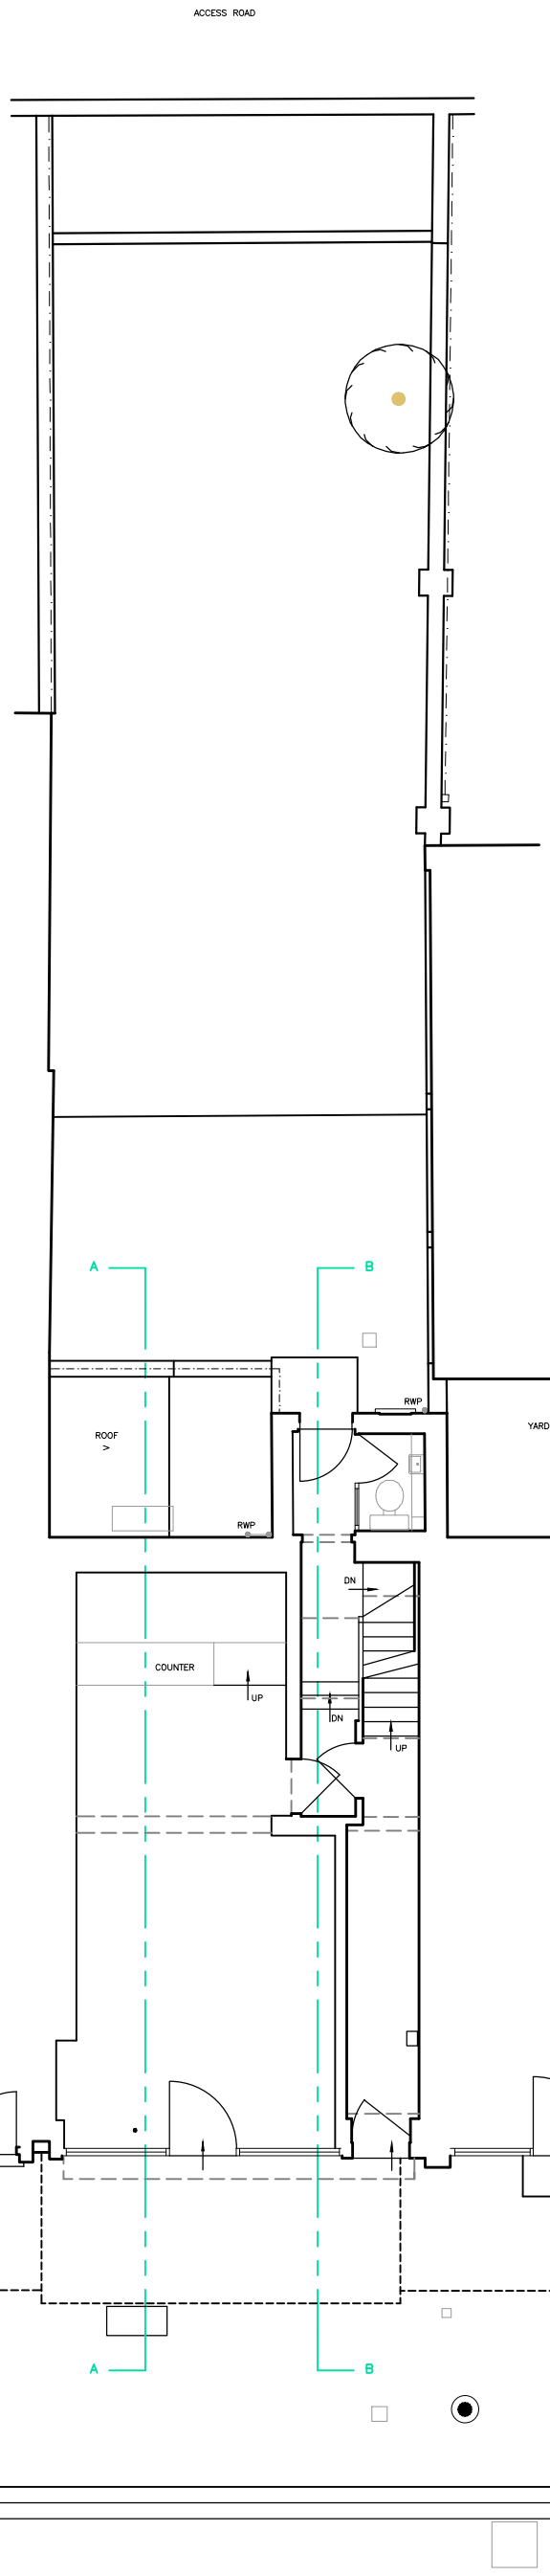
AV	AIR VENT	RWP	RAIN WATER PIPE
C	CILL LEVEL	SA	SPRING OF ARCH
CA	CENTRE OF ARCH	SCH	SUSPENDED CEILING HEIGHT
CH	CEILING HEIGHT	SD	SLIDING DOOR
CWT	COLD WATER TANK	SL	SOIL PIPE
DH	DOOR HEAD	SVP	SOIL VENT PIPE
EMP	ELECTRIC SWITCH PANEL	TOA	TOP OF ARCH
F	FRAME HEIGHT	UCH	UNDERSIDE OF BEAM
FB	FLUSH DOOR	WCD	WINDOW CILL
GBL	GLAZED BRICK LIGHT	WB	WATER BUTT
HWT	HOT WATER TANK	WH	WATER HEATER
PART	PARTITIONING	WP	WASTE PIPE
RSD	ROLLER SHUTTER DOOR	WST	WATER STORAGE TANK
		HEAD	HEAD LEVEL