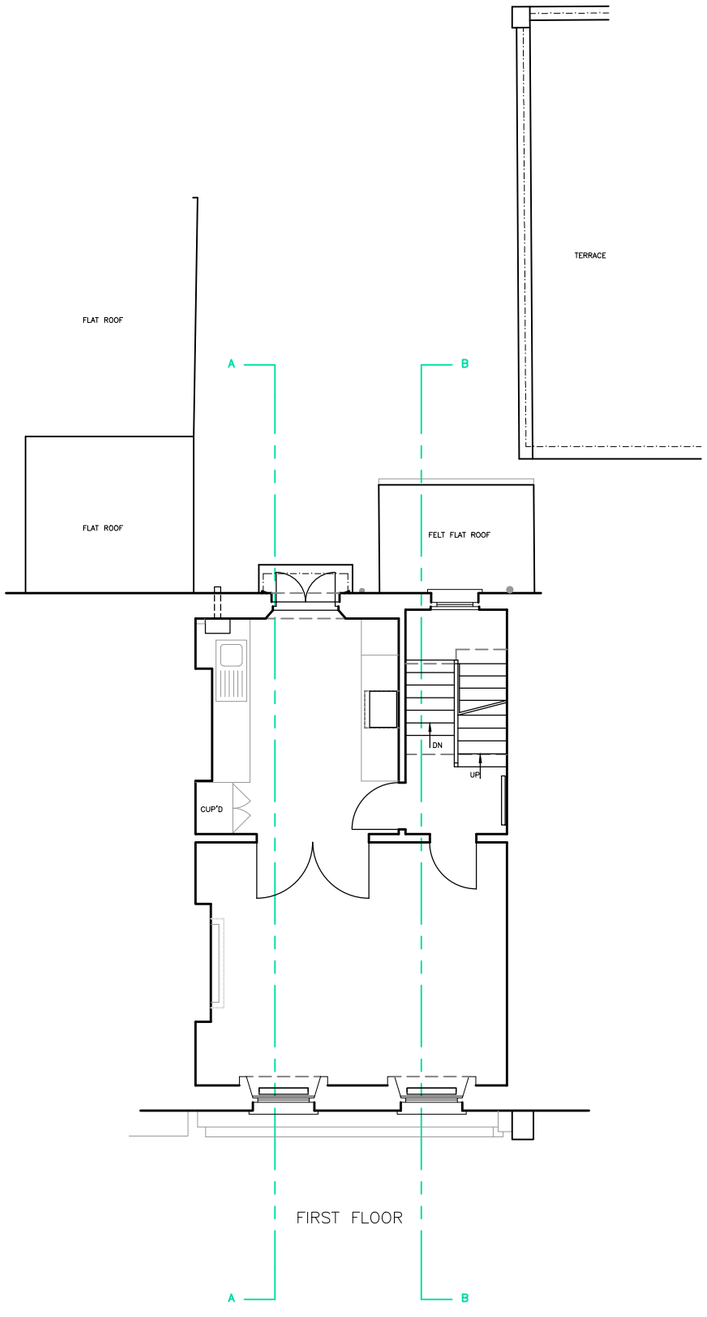

FIRST FLOOR

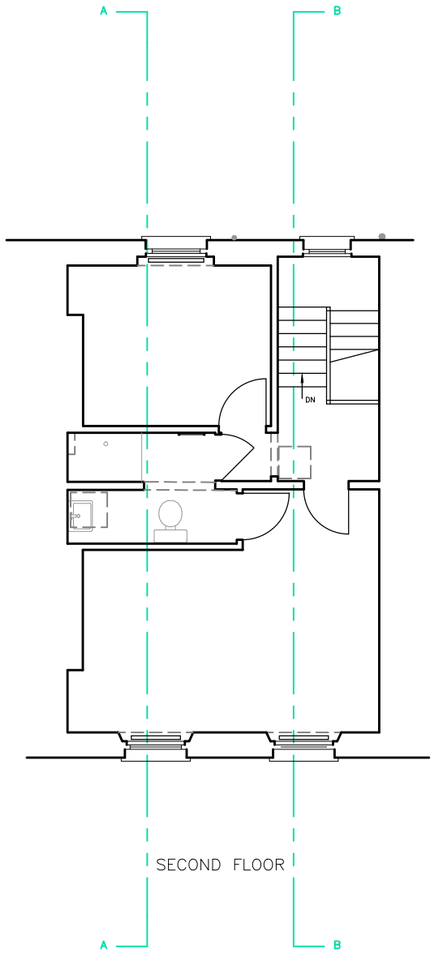

SECOND FLOOR

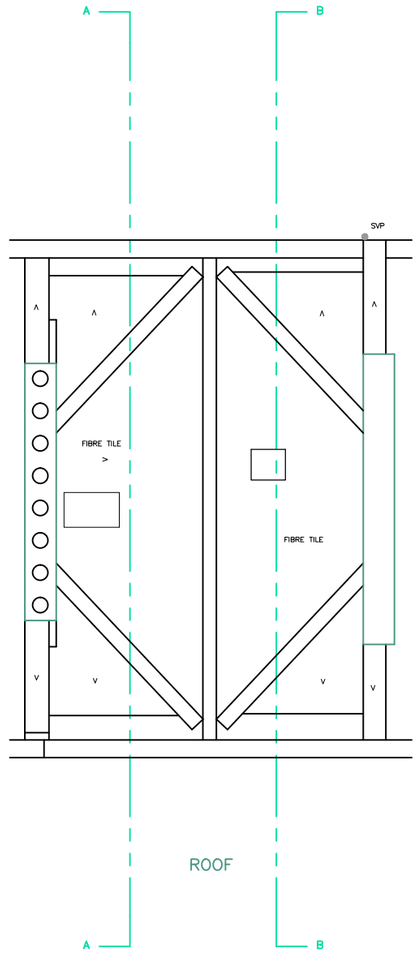

ROOF

LEVELS RELATE TO :-

OSBM SITUATEDED ON 156-170 KENTISH TOWN ROAD. VALUE 27.08m

ON DETAIL SURVEY

AB	AIR BRICK	JB	JUNCTION BOX
AC	AIR CONDITIONER	LB	LITTER BIN
ACU	AIR CONDITIONING UNIT	LC	LAMP COLUMN
AP	ARTIFICIAL STONE PAVING	LT	LIGHT
ASP	ASPHALT	MB	MAIL BOX (SERVICED
AT	AIR TANK	MP	METAL POST
BB	BOLLARD BEACON	MT	METAL TANK
BW	BRICK WALL	PP	PEDESTAL POST
BY	BOW WELL	RP	RECTANGULAR POST
BL	BOX LEVEL	RS	RODDING STONE
BOLL	BOLLARD	SH	SHOWER HEAD
BS	BLIND SUMP	ST	OIL STORAGE TANK
BT	BRITISH TELECOM	TP	TELE POST
CAB	CABINET	PE	PARK EDGING
C.BOX	CONTROL BOXES	PL	PAVEMENT LIGHT
CB	CHIMNEY BRICK	PM	PARKING METER
CC	CAST IRON	PO	POLE SIGN
CE	CAST IRON	RE	ROOF LEVEL
CL	CONCRETE	RG	ROOF GUTT BOX
CO	COAL HATCH	SB	STREET SIGN PLATE
CTV	CABLE TELEVISION	SL	STREET NOX LAMP
DL	DOUBLE RED LINE	TL	TRAFFIC YELLOW LINE
EVC	ELECTRICITY LINE	TC	TRAFFIC CONTROL BOX
FAC	FENCE AND PALEY	TW	TELE. WELL
F.BED	FLOWER BED	TLB	TRAFFIC Light CONTROL BOX
FH	FIRE HYDRANT	TR	TELEGRAPH POLE
FP	FLOWER POT	TS	TRAFFIC SIGN
FT	FLAG POLE	TT	TRAFFIC TURN
G	GULLY	TW	TOP OF WALL
GB	GAS GOVERNOR	TY	TOP OF YARD
GV	GAS VALVE	UC	UNABLE TO CHECK
HT	HEIGHT	UL	UNABLE TO LIFT
IC	INSPECTION COVER	UT	UNABLE TO TRACE
IL	INVERT LEVEL	VP	VENT PIPE
IL	INVERT LEVEL	WL	WATER LEVEL
IP	INSPECTION PLATE	WP	WOOD POST
		WV	WATER VALVE

ON FENCES/DIVISIONS

CBW	CONCRETE BOND	AGR	AGRICULTURAL BOARD
BRK	METAL RAIL	BF	BOARDED FENCE
PW	PICKET FENCE	CF	CHAIN FENCE
RW	RAILWAY FENCE	GR	GUARD RAIL
CSB	CLOSE BOARD	PAL	PLAIN TILE SILL
CSP	CORRUGATED SHEET	PL	PLAIN TILE
CSS	CORRUGATED SHEET	RL	RAILINGS
CVD	CHAIN LINK	VB	VERTICAL BOARD
HED	HEDGE ROW	WF	WIRE FENCE
PCW	CONCRETE PALING	WG	WOOD RAIL
		WSW	WOOD SECTION WALL

ON BUILDINGS

AV	AIR VENT	BWP	RAIN WATER PIPE
C	CILL LEVEL	SP	SPRINKLER
CH	CENTRE OF ARCH	SPH	SPRINKLER CEILING HEIGHT
CW	COLD WATER TAP	SVP	SOIL VENT PIPE
CWT	COLD WATER TANK	WC	WATER CLOSET
DH	DOOR HEAD	WP	WATER PIPE
EP	ELECTRIC METER PANEL	WT	WATER STORAGE TANK
F	FLOOR LEVEL		
FB	FLOOR BOARD		
FL	FLOOR LEVEL		
GL	GLAZED SKY LIGHT		
HWT	HOT WATER TANK		
RSD	ROLLER SHUTTER DOOR		

W.P.G.SURVEYS
LAND SURVEYORS
MEADWAY HOUSE, 17-21 BRIGHTON ROAD
SURBITON, SURREY, KT6 5LR
TEL.020 8390 2711 FAX.020 8390 6277

SITE

69 KENTISH TOWN RD
LONDON
NW1 8NY

DRAWING

FLOOR PLANS

SCALE 1:100	DATE JULY 2015	JOB NO 5153	
SURVEYED BY SP.CP		DRAWING NO 02	
DRAWN BY SP			

FOR

ARTHURELL
& KIRKLAND