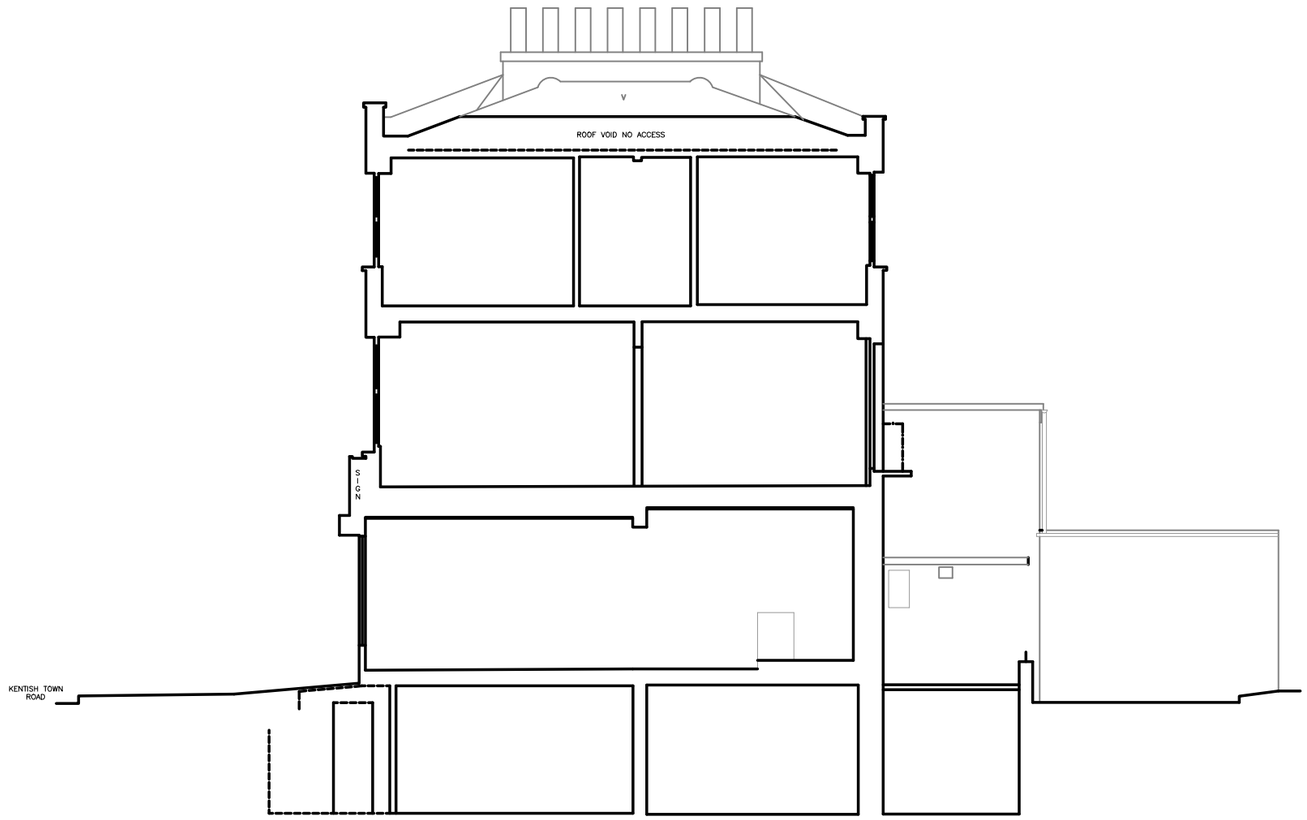

DATUM 20.00m

SECTION A–A

LEVELS RELATE TO :–

OSBM SITUATEDED ON 156–170 KENTISH TOWN ROAD. VALUE 27.08m

ON DETAIL SURVEY

		HEAD	HEAD LEVEL

W.P.G.SURVEYS

LAND SURVEYORS

MEADWAY HOUSE, 17–21 BRIGHTON ROAD
SURBITON, SURREY, KT6 5LR
TEL.020 8390 2711 FAX.020 8390 6277

SITE

69 KENTISH TOWN RD
LONDON
NW1 8NY

DRAWING

SECTION A–A

SCALE 1:100	DATE JULY 2015	JOB NO 5153	
SURVEYED BY SP.CP		DRAWING NO 04	
DRAWN BY SP			

FOR

ARTHURELL
& KIRKLAND