

General Notes:

- This drawing is based on tender drawing information - drawing 3008_KLB_GMP-Sheet - 3043 - GMP Floor & Reflected Ceiling Plan.dwg. Exact dimensions to be verified against the site survey / site measurements prior to construction.
- To be read in conjunction with change log document
- *Ramp could be revised to 1:13.43

Colour Key:

Items in **Blue** are additional requested items
 Items in **Pink** are Client supply items

P7	Updated following Grahams 28.01.16	LM	BP	03.02.16
P6	Issued for Reach Active. Below 'rev-P6' changes are post Contractor Proposal Issue 'rev-P5' based on 3D walk-through meeting with the Client. Area below the APS in receiving / shipping room and transfer hatches boxed. Shelving added in the storage cupboard, office layout revised (TBC by client), anti-splash screen & wall units added to sink in QC Room, Gap between wall and chemical storage to be sealed with fixed panel. Lockers, coat hooks & hand sanitiser dispenser added to Stair lobby as per client comments. Internal glazing Clean room divided into these panels. Annotations revised generally.	BP	DS	06.01.15
P5	QC room sink (colour) revised to client comments. Bi-swing door (colour) updated as per Building Control (HCD) comments	BP	DS	11.12.15
P4	Client supply items indicated in pink, QC room furniture revised following client comments	LM	BP	10.12.15
P3	Secondary glazing revised to fixed, office layout revised to indicate 5 seating positions, trolley included, RWP revised to adjacent side of extension,	LM	BP	30.11.15
P2	Stair door revised to 2way swing, extension & ramp levels revised, external door revised to single leaf	LM	BP	06.11.15
P1	First issue	LM	BP	02.11.15
rev	description	drawn	checked	date

Bond Bryan Architects

The Church Studio Springvale Road Sheffield S10 1LP
 t +44(0)114 266 2040 w www.bondbryan.com
 f +44(0)114 268 7021 tw @bondbryan
 e UCL.KLB@bondbryan.co.uk

**GMP LAB
 Kathleen Lonsdale Building
 UCL Gower Place, London**



PROPOSED BASEMENT GA PLAN - GMP

bba project ref	scale(s)	original paper size
15-159	1:50, 1:20	A1

name :	project	originator	zone	level	type	role	number
--------	---------	------------	------	-------	------	------	--------

KLB - BBA - Z0 - B1 - DR - A - 02001

status :	suitability description :
S3	ISSUED FOR REVIEW AND COMMENT
revision :	revision description :
P7	PRELIMINARY

This document is © Bond Bryan Architects Ltd. If in doubt ASK. Drawing measurements shall not be obtained by scaling. Verify all dimensions prior to construction. Immediately report any discrepancies on this document to the Architect. This document shall be read in conjunction with associated models, specifications and related consultant's documents.

PROPOSED LOCATION OF FIXED SECONDARY GLAZING & DOUBLE GLAZING MARKUP FOR PLANNING
 09.02.2016



Single Pane Windows

Suitable for internal applications.

- The aluminium frame is finished in silver or white.
- Toughened Safety glass BS6206AT as standard, also available with Georgian Wired, Polycarbonate, or Tinted glass.
- All commercial sizes available
- Optional reveal frame in White or Grey.




Special Colours

Red



Green

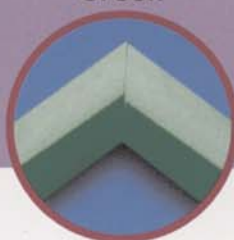

Blue



Stock Colours

Silver



White



Silver



White



GLASS DOOR SYSTEMS

www.cab-glassdoors.co.uk

Tel: 01865 891143

Fax: 01865 890033

Flexible

Window fitted



For varied wall thickness/
flush fitting




Window with
reveal frame



Screw fitting or glue



Standard frames finished
in Silver or white

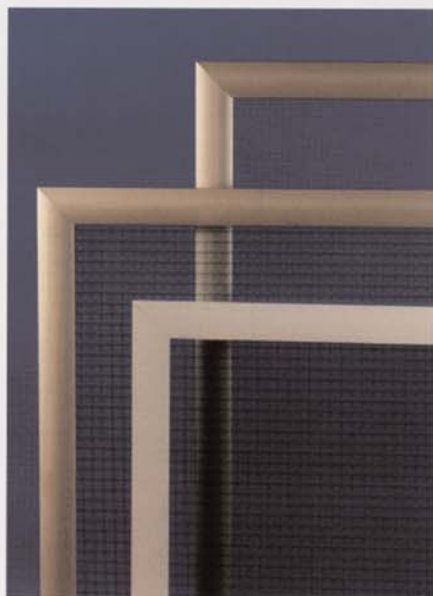

Special colours



13, Monument Business Park,
Chalgrove, Oxon OX44 7RW. ENGLAND
Tel: +44 (0)1865 891143 Fax: +44 (0)1865 890033
Email: cab.glassdoors@virgin.net

www.cab-glassdoors.co.uk

SINGLE PANE WINDOWS FOR INTERNAL APPLICATIONS