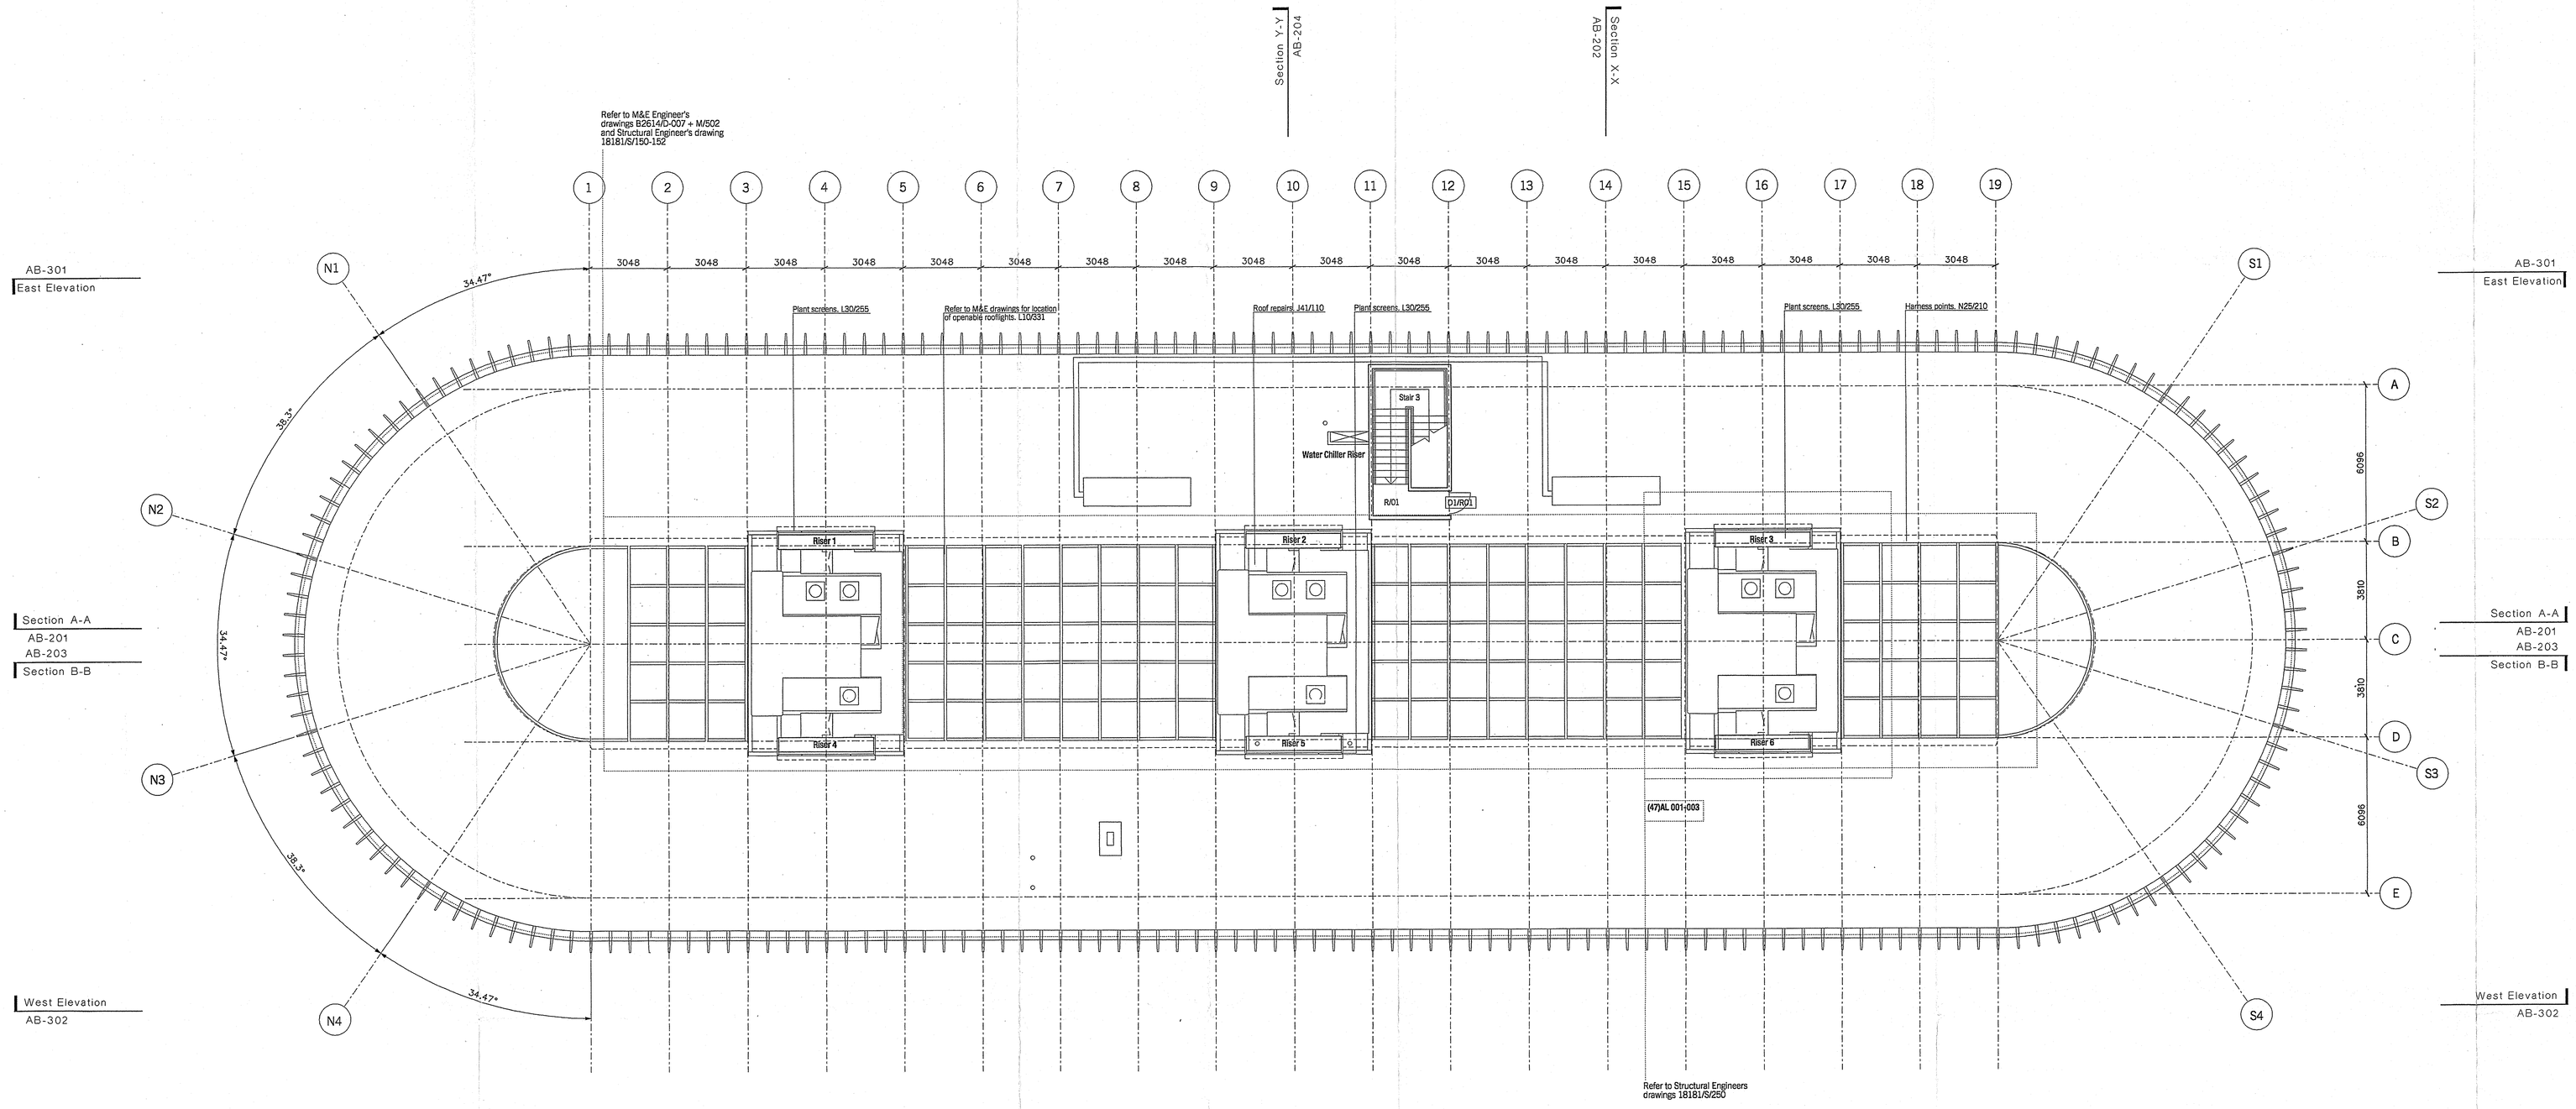

All dimensions are to be checked on site and any discrepancies noted in writing to JMP.
All dimensions are in millimetres unless noted otherwise.
If in could ask the Contract Administrator.

Revisions

Rev.	Date	Description	Drawn	Checked
01	05.11.02	Issued As Built for Phase 1	NJ	RE
02	23.05.03	Issued As Built for Phase 2	NJ	RE

Key:

- Denotes brickwork wall. F10/160
- Denotes 100mm blockwork wall. F10/350
- Denotes concrete infil.
- Denotes plasterboard partition wall. K10

Floor Datum: +65.56

0 1m 5m 10m

John McAslan + Partners
202 Kensington Church St
London W8 4DP
Telephone: 020 7727 2663
Facsimile: 020 7221 8835
mailbox@mcaslan.co.uk
www.mcaslan.co.uk

Swiss Cottage Library
Roof GA Plan

scale	1:100 at A0	job no.	767
date	23.05.03	drawing by	NJ
drawing status	AS BUILT	checked by	RE
drawing no.	(2-)AB 006	revision	01