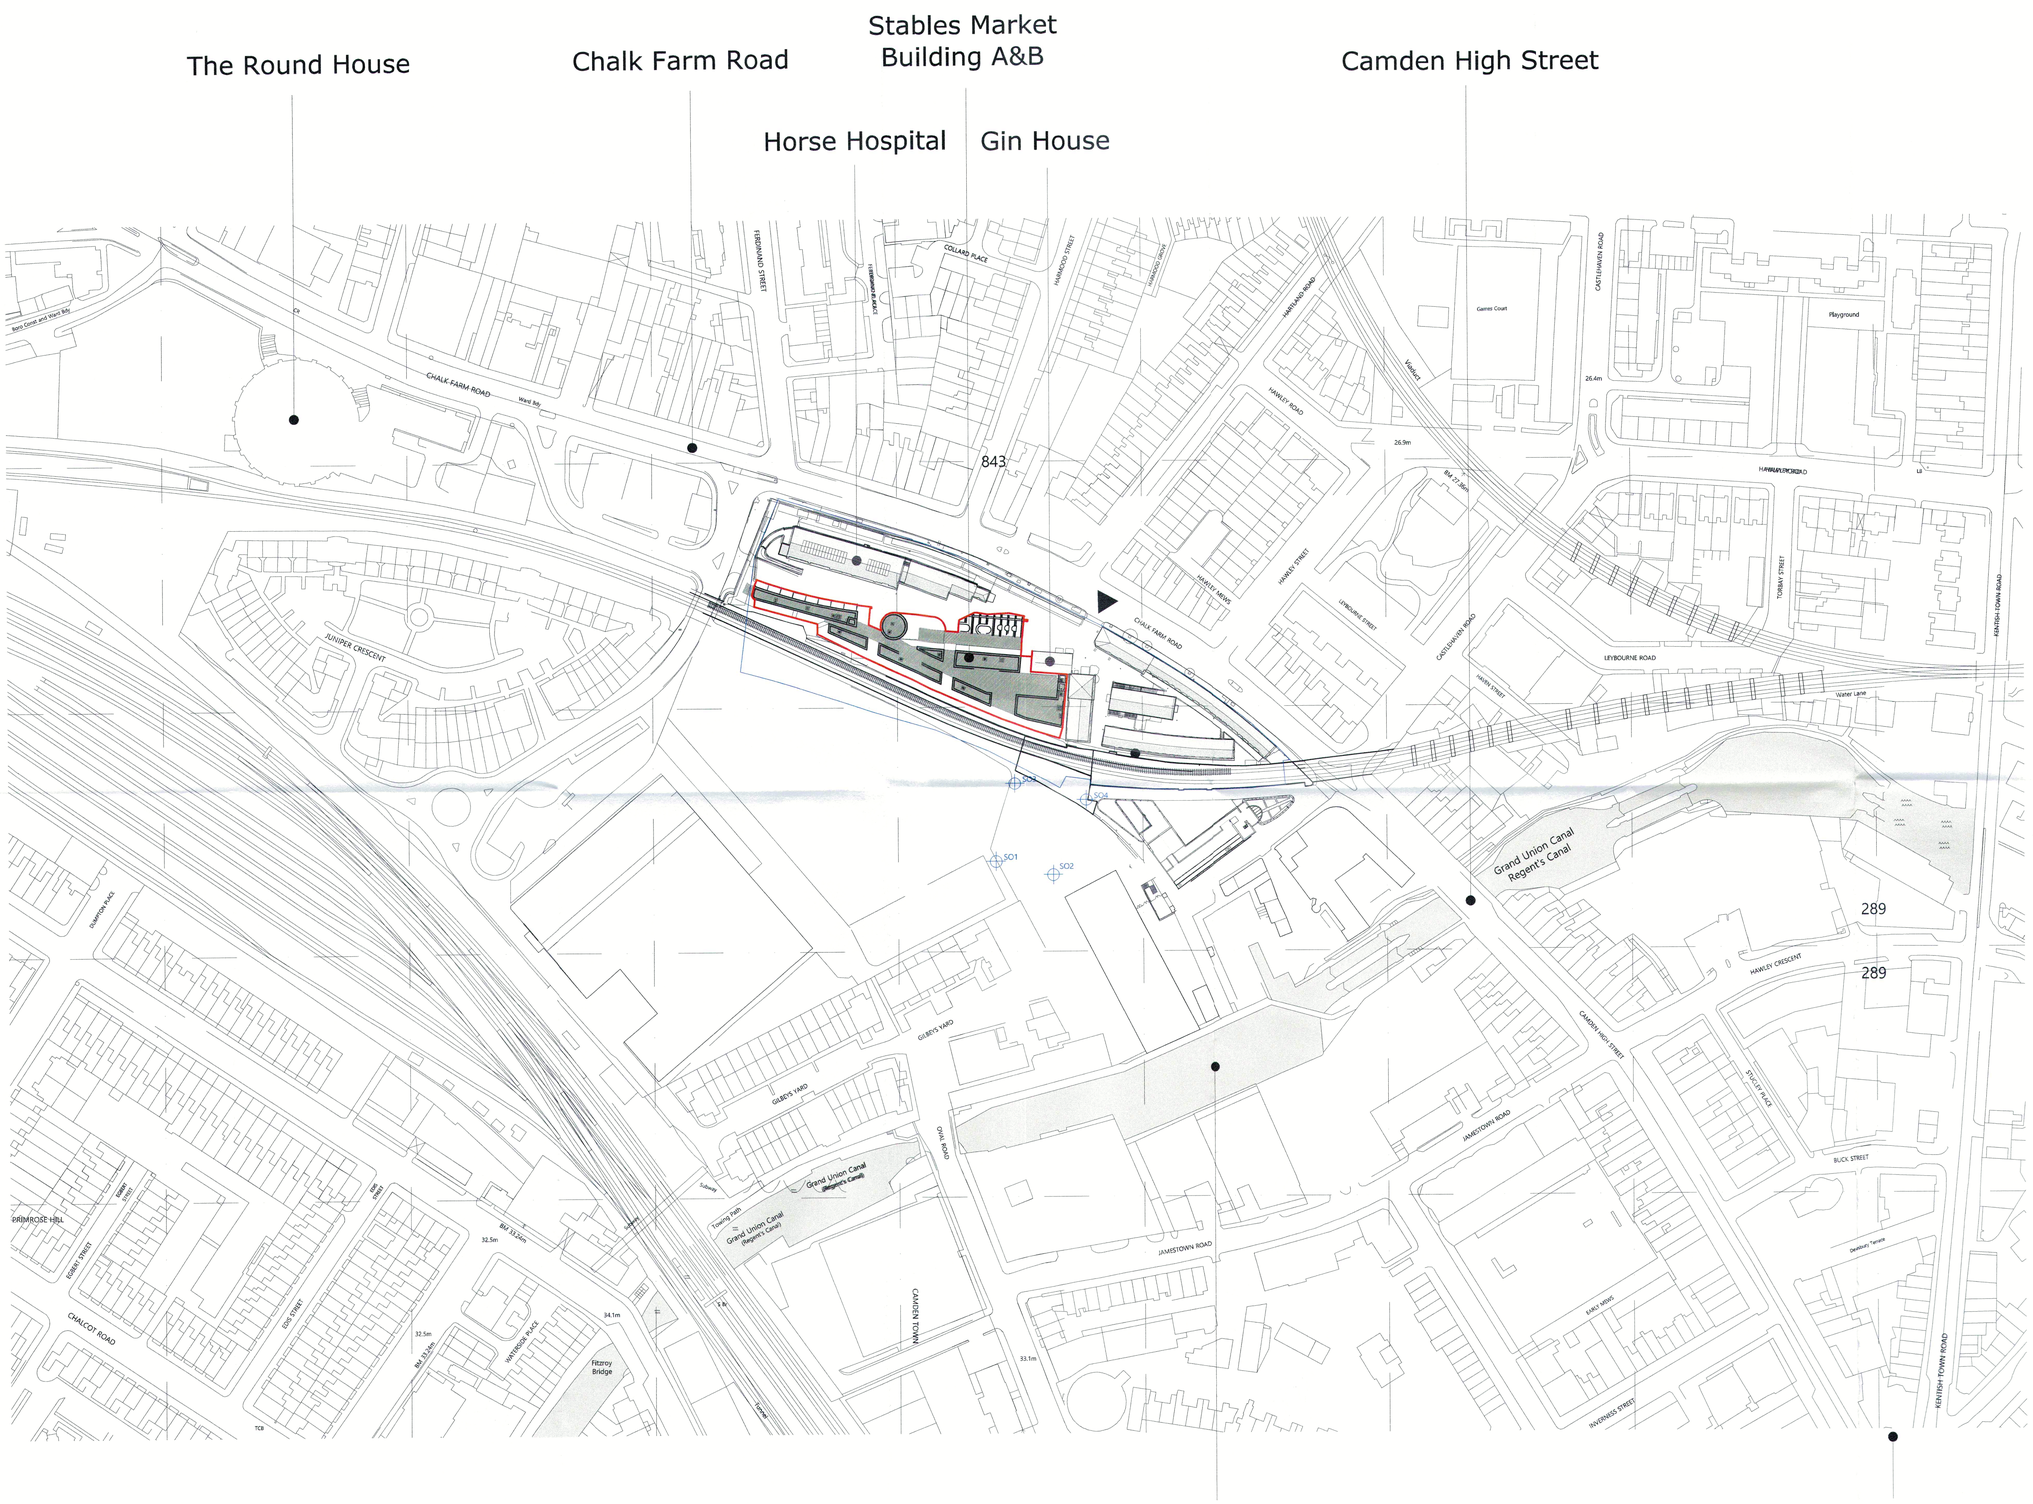

Grid Setting Out
(based on OS
Superplan Data):

SO1 - North = 1954710
- East = 839191

SO2 - North = 1949135
- East = 862535

SO3 - North = 1986807
- East = 846855

SO4 - North = 1979839
- East = 876035

Client

Stanley Sidings Ltd

Project

Camden Stables A&B site

Title

Location Plan

Lawful development application

Reflecting the as-built condition in 2010

project	drg no.	Rev
05005	100_00	PL1

date	scale
25.05.2016	1:1250 @ A1