Key.

H

C
B1
B2
A1
A2

Scale 1:100

0   1m   2m   4m   6m   10m

Planning

Top of Parapet +76.095m

Existing building shown in red dashed line.

Top of Parapet +72.78m

Conservation Rooflights

Winscombe Street +71.41m

Top of Parapet +69.88m

Top of Pentad Housing +67.72m

Top of Parapet +64.48m

THE PEOPLES GOSPEL MISSION HALL

Brickwork to match existing

Panelled new door

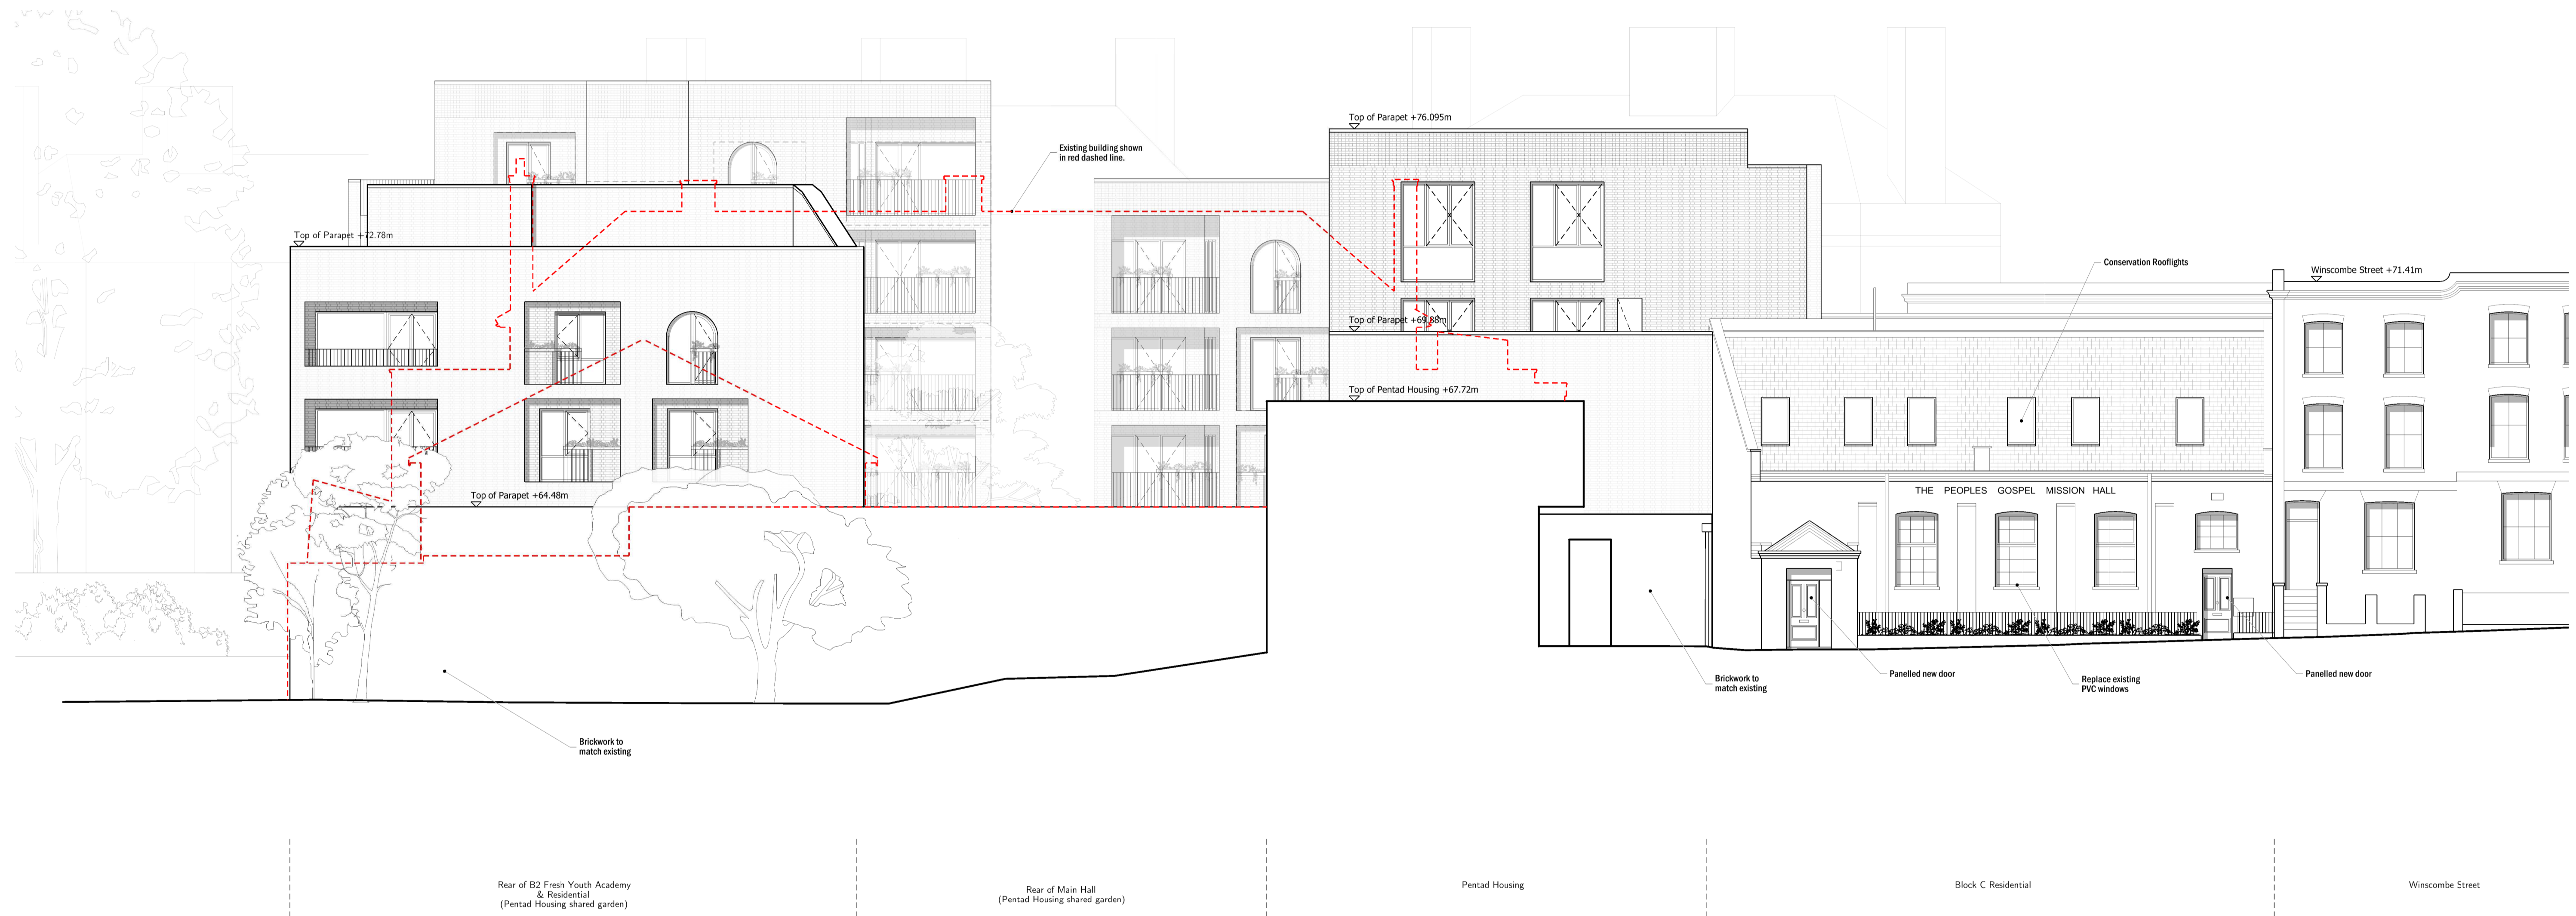Replace existing PVC windows

Panelled new door

Brickwork to match existing

Rear of B2 Fresh Youth Academy
& Residential
(Pentad Housing shared garden)

Rear of Main Hall
(Pentad Housing shared garden)

Pentad Housing

Block C Residential

Winscombe Street

01 **Section HH**
As Propsoed