N

Substation

Office Cycle Store

lobby

Commercial bin store

Affordable Housing Entrance

Private Housing Entrance

post boxes

Office toilets

OFFICE AREA-1620sqm--17437 sqft

Location of rooflight above

Location of rooflight above

Unscreened Glass balustrade to Canada Viewing

Office toilets female

Office toilets male

Affordable Housing Entrance

post boxes

Temporary waste storage

35 Bike Stands, Type 1, For Affordable Housing

Private Housing Entrance

basement vent grille

Transition Zone 1/20 3000mm

Ramp 1/10 27000mm

Transition Zone1/20 3000mm

Roof of bulk storage

Affordable Housing | Private Ownership

Affordable Housing

Refuse Store

Car Parking For Social Rent Disabled units

AS-BUILT

DO NOT SCALE FROM THIS DRAWING : Verify all dimensions on site

PKS architects

project	35 OVAL ROAD, LONDON NW1, SCHEME 3
title	Upper Ground floor plan
scale	1:100 @ A0
author	KS
date	23.11.06
job no.	716
dwg no.	003-03
rev.	D

© PKS Architects LLP 10 Deane House Studios, Greenwood Place, London, NW5 1LB t. 020 7424 4800 f. 020 7424 4801 e. pks@pksarchitects.com

N

Private Ownership

Affordable Housing

Private Ownership

Shared Ownership

Affordable Housing

Private Ownership

Affordable Housing

AS-BUILT

DO NOT SCALE FROM THIS DRAWING : Verify all dimensions on site

PKS architects

project: 35 OVAL ROAD, LONDON NW1, SCHEME 3

title: 1st floor plan

scale: 1:100 @ A0 | author: KS | proj no.: 003-04 | rev.: B

date: 23.11.06 | job no.: 716

© PKS Architects LLP 10 Deane House Studios, Greenwood Place, London, NW5 1LB t. 020 7424 4800 f. 020 7424 4801 e. pks@pksarchitects.com

N

Private Ownership

Affordable Housing

Private Ownership

Shared Ownership

Affordable Housing

Private Ownership

Affordable Housing

AS-BUILT

DO NOT SCALE FROM THIS DRAWING : Verify all dimensions on site

PKS architects

project	35 OVAL ROAD, LONDON NW1, SCHEME 3
title	2nd floor plan
scale	1:100 @ A0
author	KS
date	23.11.06
job no.	715
dwg no.	003-05
rev.	B

© PKS Architects LLP 10 Deane House Studios, Greenwood Place, London, NW5 1LB t. 020 7424 4800 f. 020 7424 4801 e. pks@pksarchitects.com

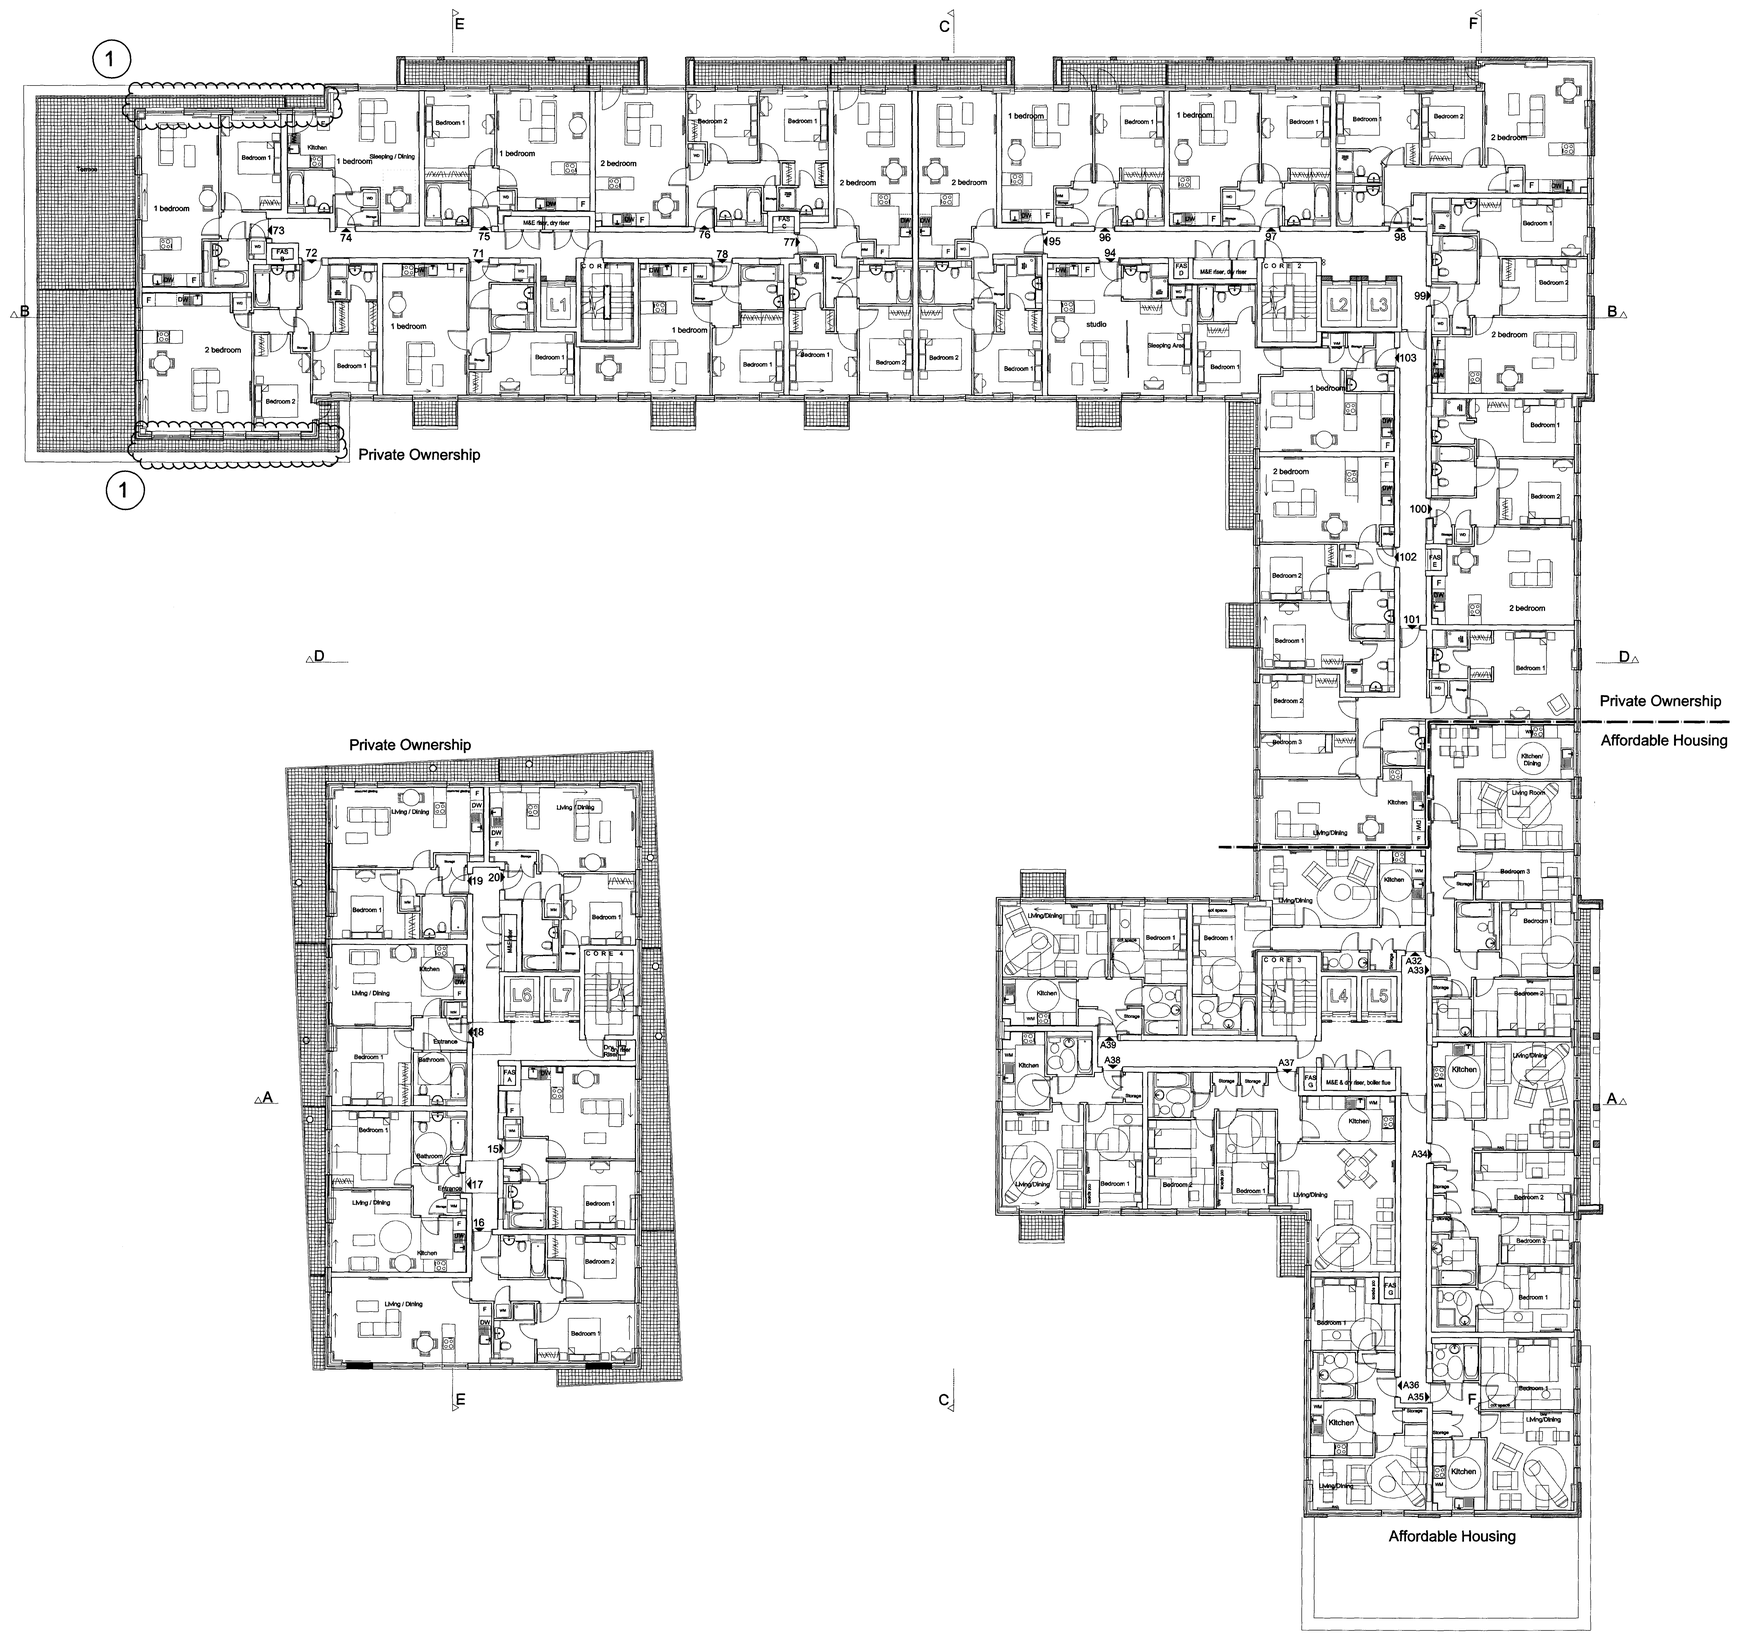

AS-BUILT

DO NOT SCALE FROM THIS DRAWING : Verify all dimensions on site

PKS architects

project	35 OVAL ROAD, LONDON NW1, SCHEME 3
title	3rd floor plan
scale	1:100 @ A0
author	KS
date	23.11.06
job no.	716
dwg no.	003-06
rev.	B

© PKS Architects LLP 10 Deane House Studios, Greenwood Place, London, NW5 1LB t. 020 7424 4800 f. 020 7424 4801 e. pks@pksarchitects.com

AS-BUILT

DO NOT SCALE FROM THIS DRAWING : Verify all dimensions on site

PKS architects

project	35 OVAL ROAD, LONDON NW1, SCHEME 3
title	4th floor plan
scale	1:100 @ A0
author	KS
date	23.11.06
job no.	716
dwg no.	003-07
rev.	B

© PKS Architects LLP 10 Deane House Studios, Greenwood Place, London, NW5 1LB t. 020 7424 4800 f. 020 7424 4801 e. pks@pksarchitects.com

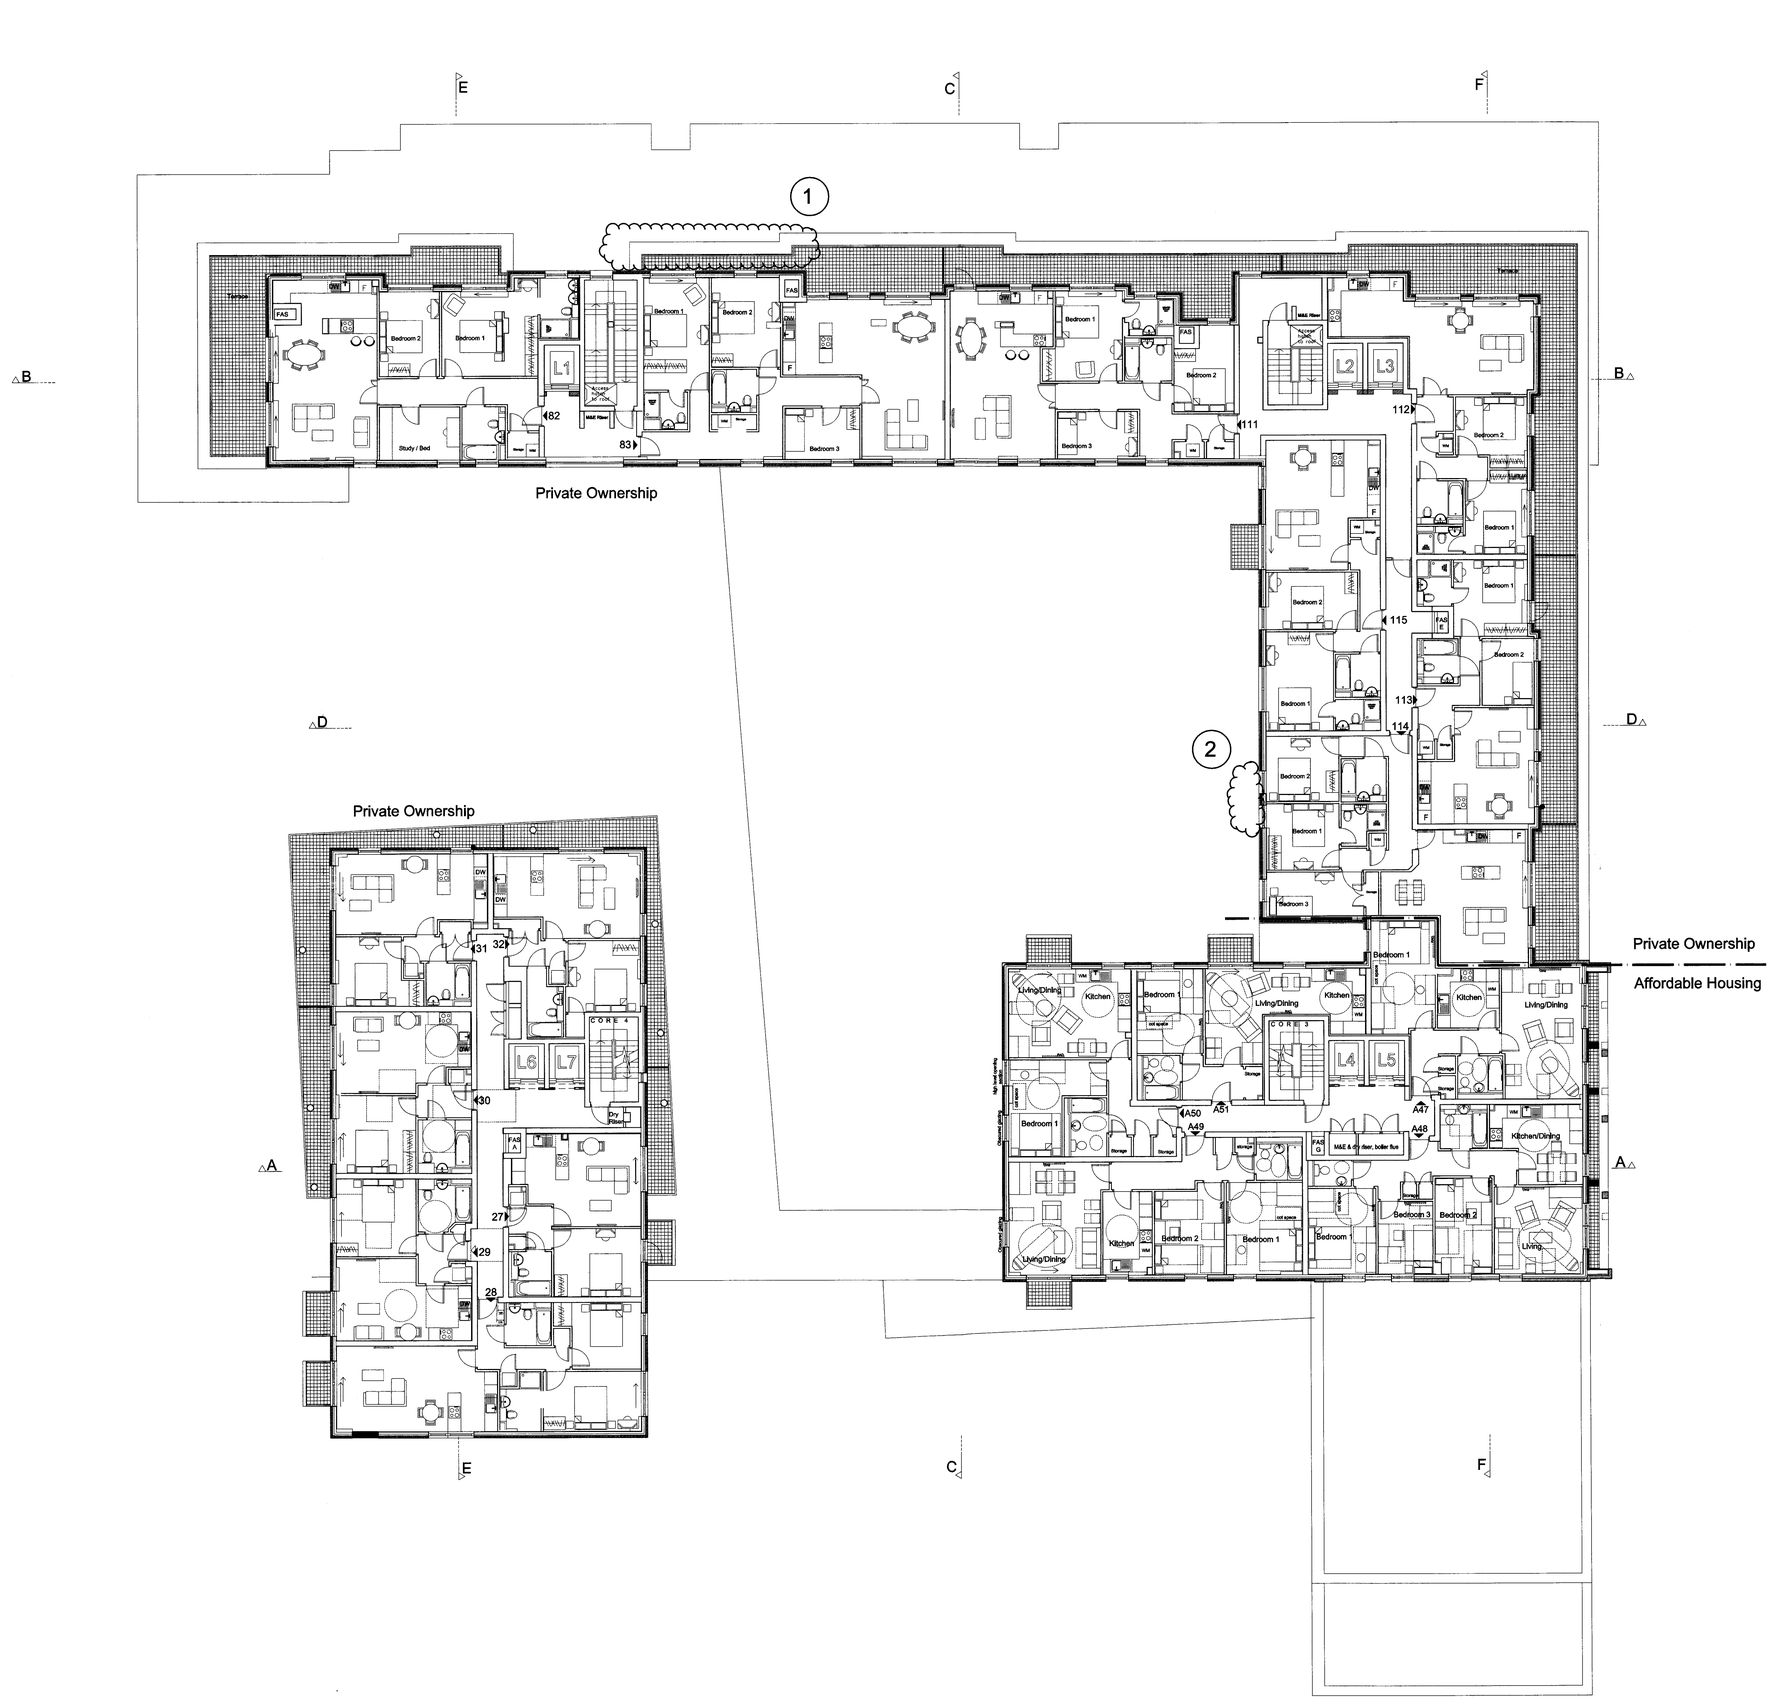

AS-BUILT

DO NOT SCALE FROM THIS DRAWING : Verify all dimensions on site

project	35 OVAL ROAD, LONDON NW1, SCHEME 3
title	5th floor plan
scale	1:100 @ A0
author	KS
dwg no.	003-08
rev.	B
date	23.11.06
job no.	716

PKS architects

© PKS Architects LLP 10 Deane House Studios, Greenwood Place, London, NW5 1LB t. 020 7424 4800 f. 020 7424 4801 e. pks@pksarchitects.com