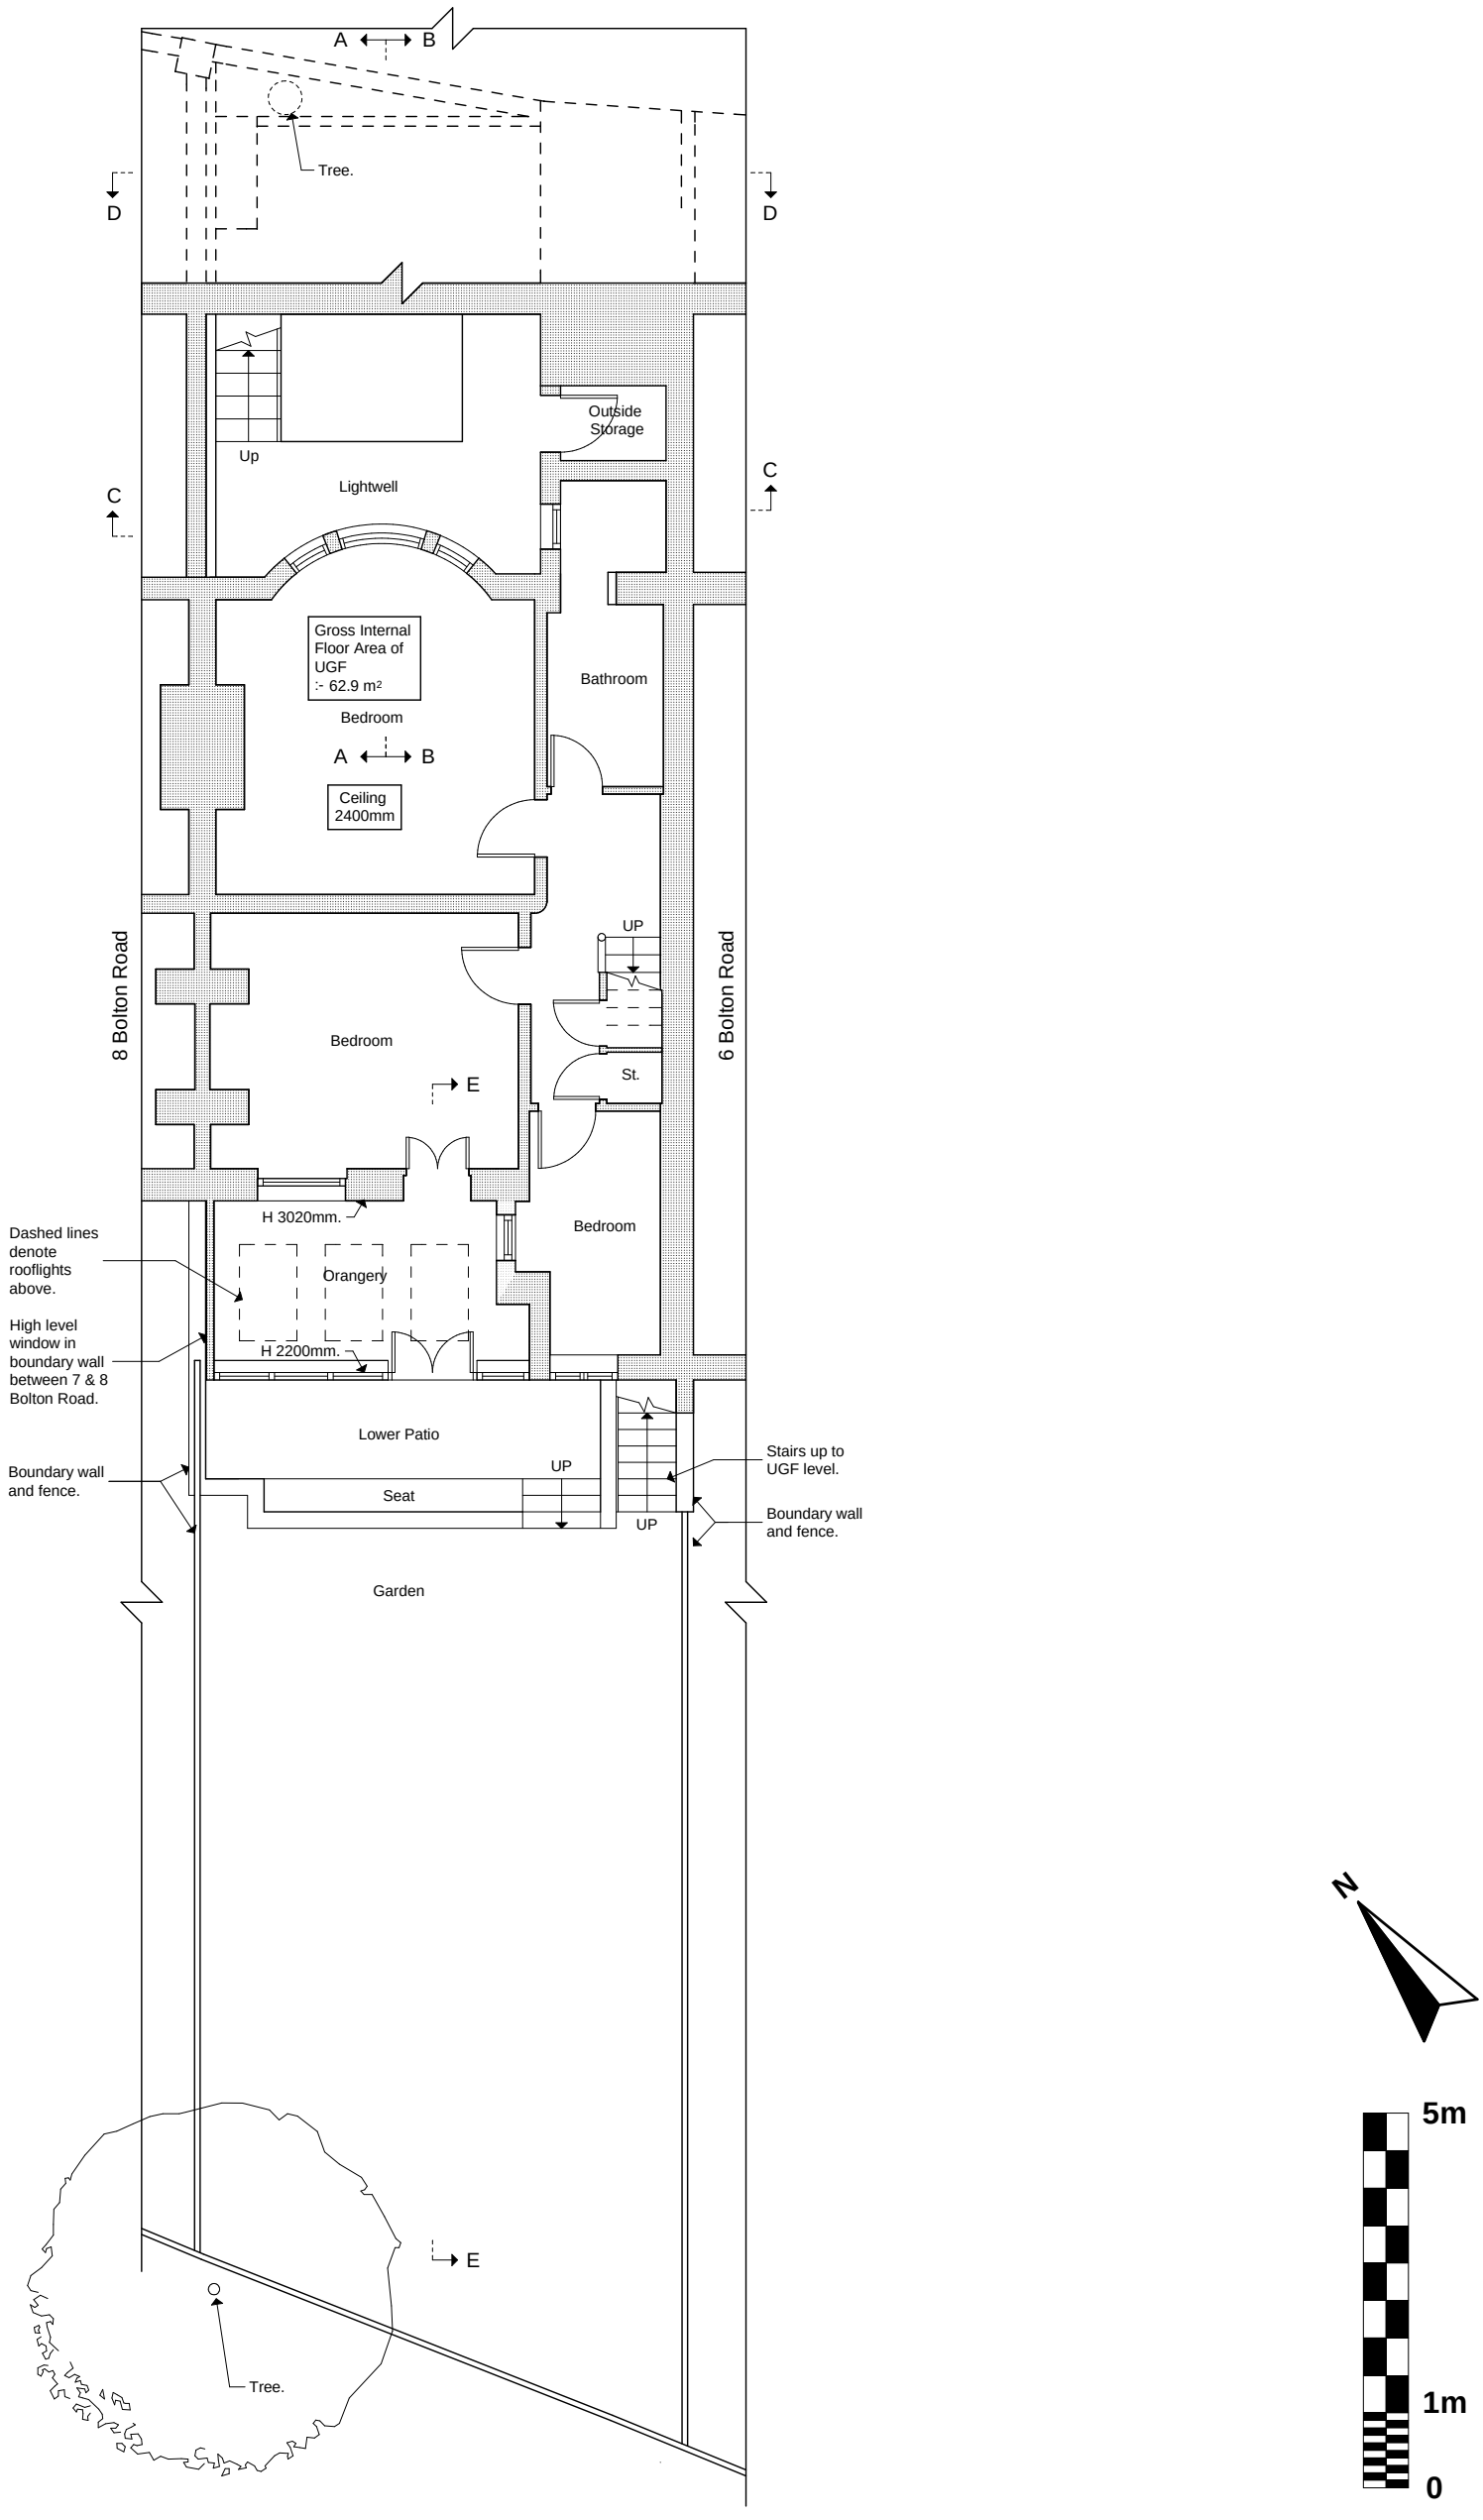

Project	7 Bolton Road
Reference Number	1249-BA-102
Client	Litven Limited
Date	Apr 16
Scale	1:100
Drawing Size	A3
Drawing	Existing LGF Plan

Preliminary	
Planning	■
Building Regs	
Tender	
Construction	
As Built	■

Rev	Date	

File Ref: 1249 - BA - Plans 1.pln © Copyright

ARCHITECTS
DONALD SHEARER
CHARTERED ARCHITECTS
Scholar's House, Shottery Brook Office Park, Timothy's Bridge Road, Stratford-upon-Avon, Warwickshire, CV37 9NR
Tel: 01789 294 560
ds-architects@hotmail.co.uk