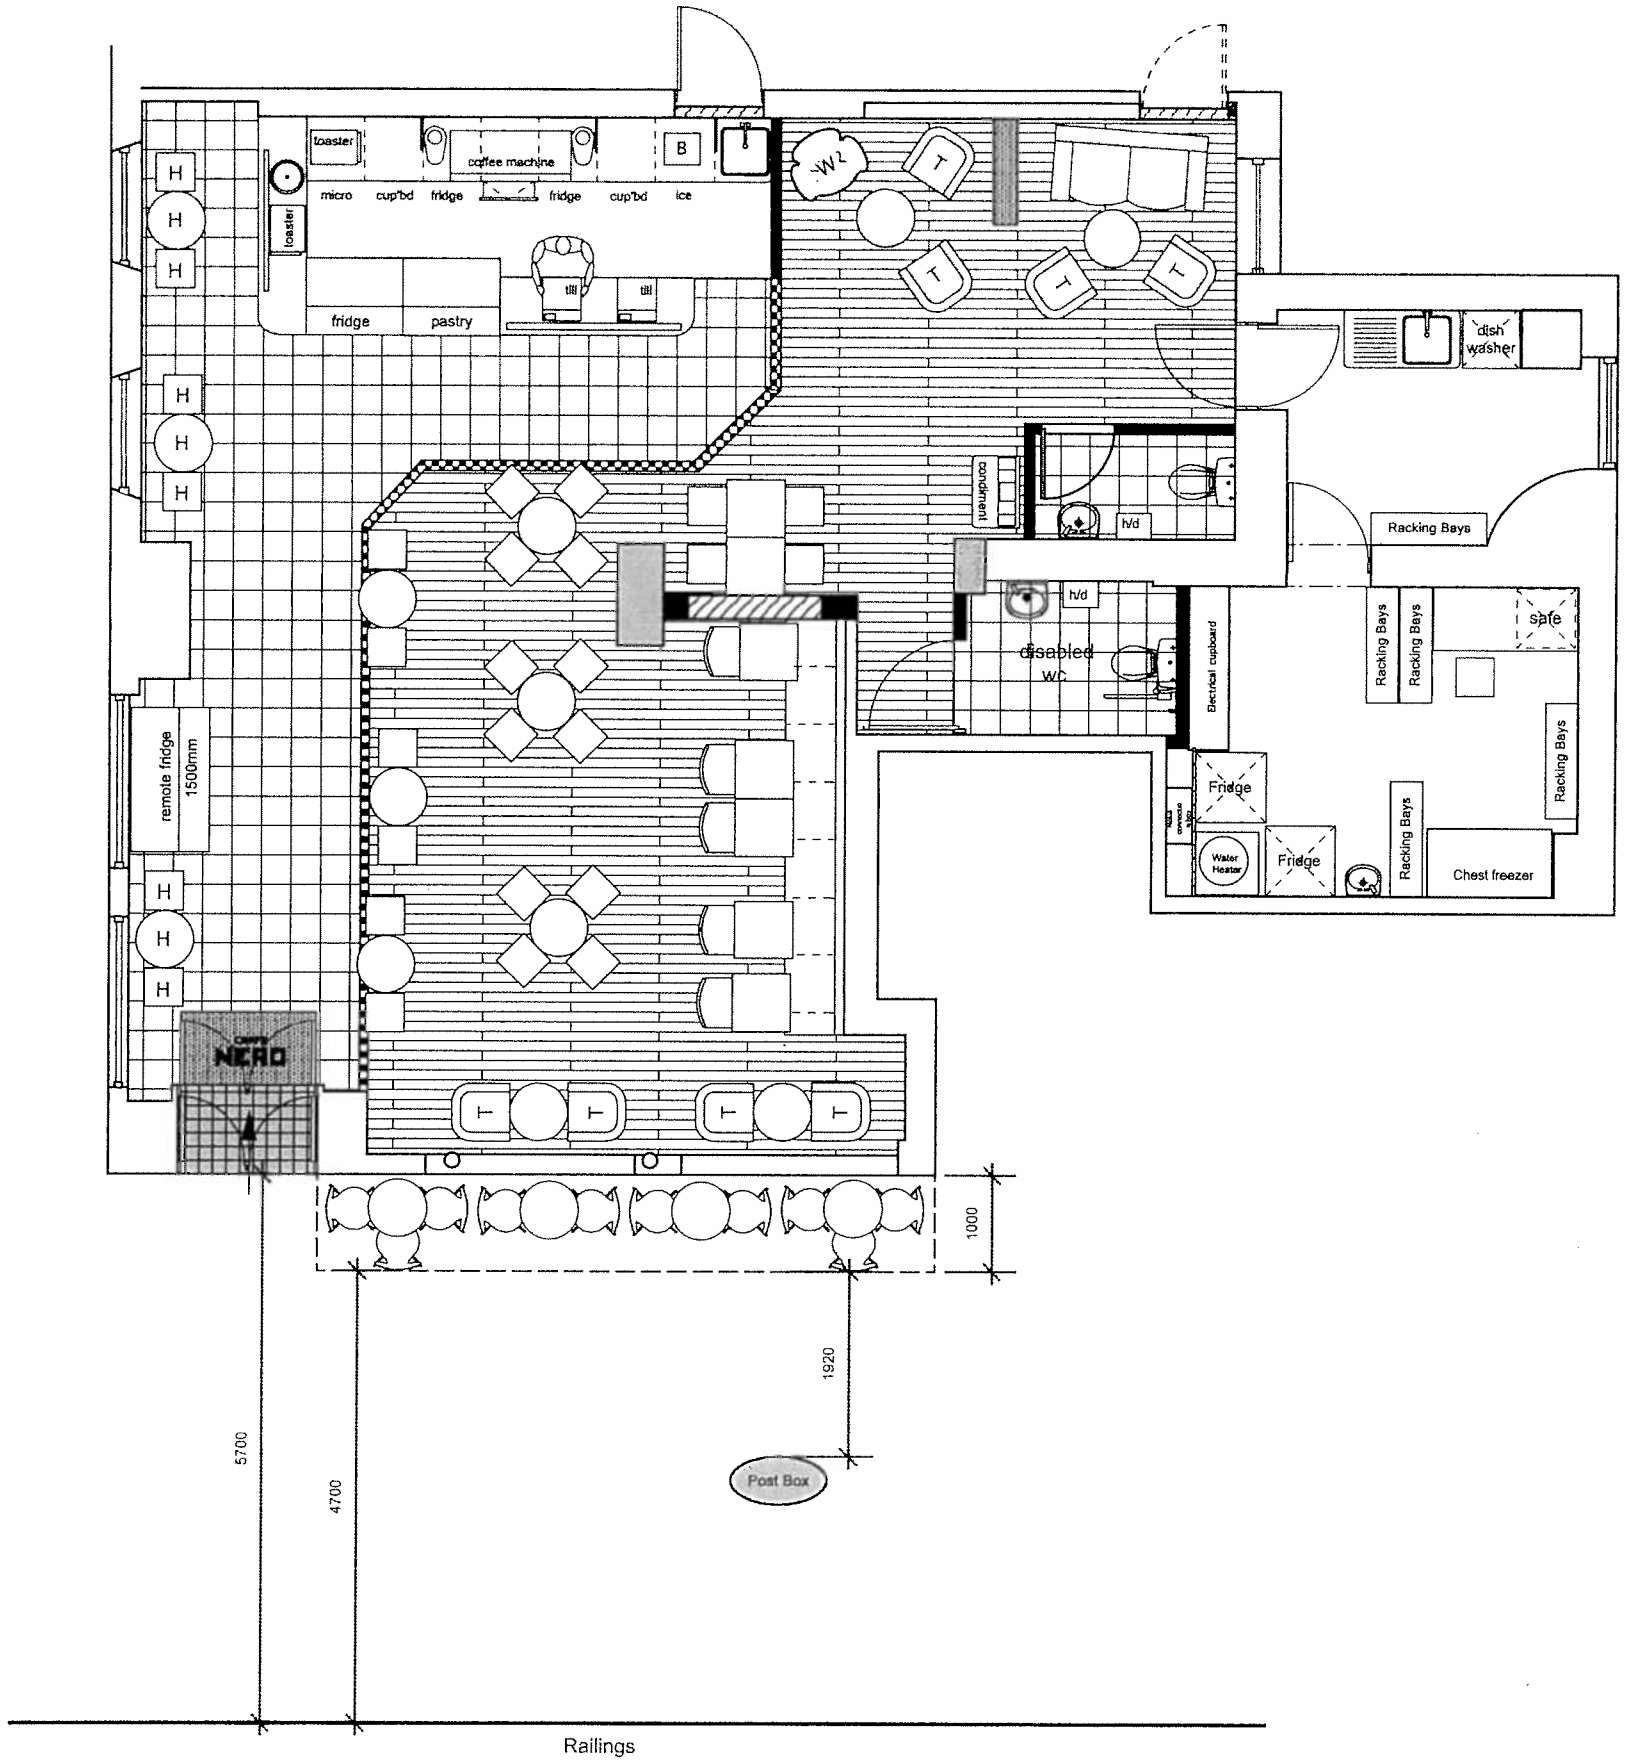

Rev N°	Description	Date

Notes

This drawing represents a performance guide upon which the contractor/subcontractor must base his/her working drawings & details. Include all necessary tolerances prior to manufacture and installation

Contractor to must undertake a full survey of the area to establish all dimensions & ensure accurate setting out.

Advise on suitability of all details shown to ensure structural stability, ease and economy of construction

Refer to digital master artwork in regard to all graphic work shown

AS BUILT

bedrock

Bedrock Design Consultants Ltd
4th Floor, 57 Hatton Garden, London, EC1N 8HP

T 020 3116 0120
F 020 3116 0121
info@bedrockdesign.co.uk

Client
Caffe Nero

Project
Theobolds Road

Description
External Seating

Scale	Drawn by	Date
1/75@A3	RW	26/02/16

Drawing N° Revision
CN341-001

This drawing is the copyright of Bedrock Design Consultants Ltd. This drawing cannot be copied, reproduced, retained or disclosed to any unauthorised person without prior permission in writing from the designer.