AS BUILT ELEVATION OF Nº 46.

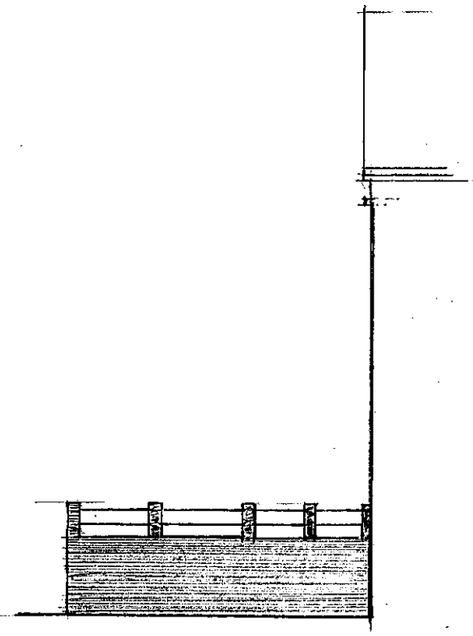

SIDE ELEVATION

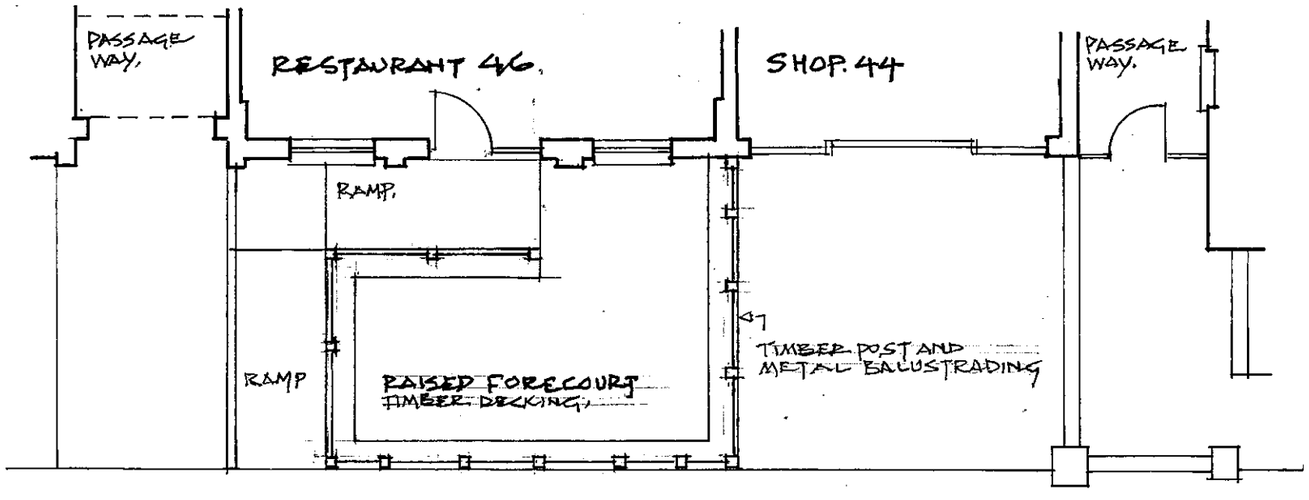

AS BUILT PLAN OF FRONTAGE Nº 46

R E P designs
2 Lulworth Court
13 Cannon Hill
London N14 7DJ
020 8882 3803

Contract
46 Birchington Road
Kilburn London NW64LJ
Client
Neritan

Drawing No 17/GL/01
As Built Frontage
Scale 1:100
Date June 2017
Drawn by EP

0 1 2 3 4 5