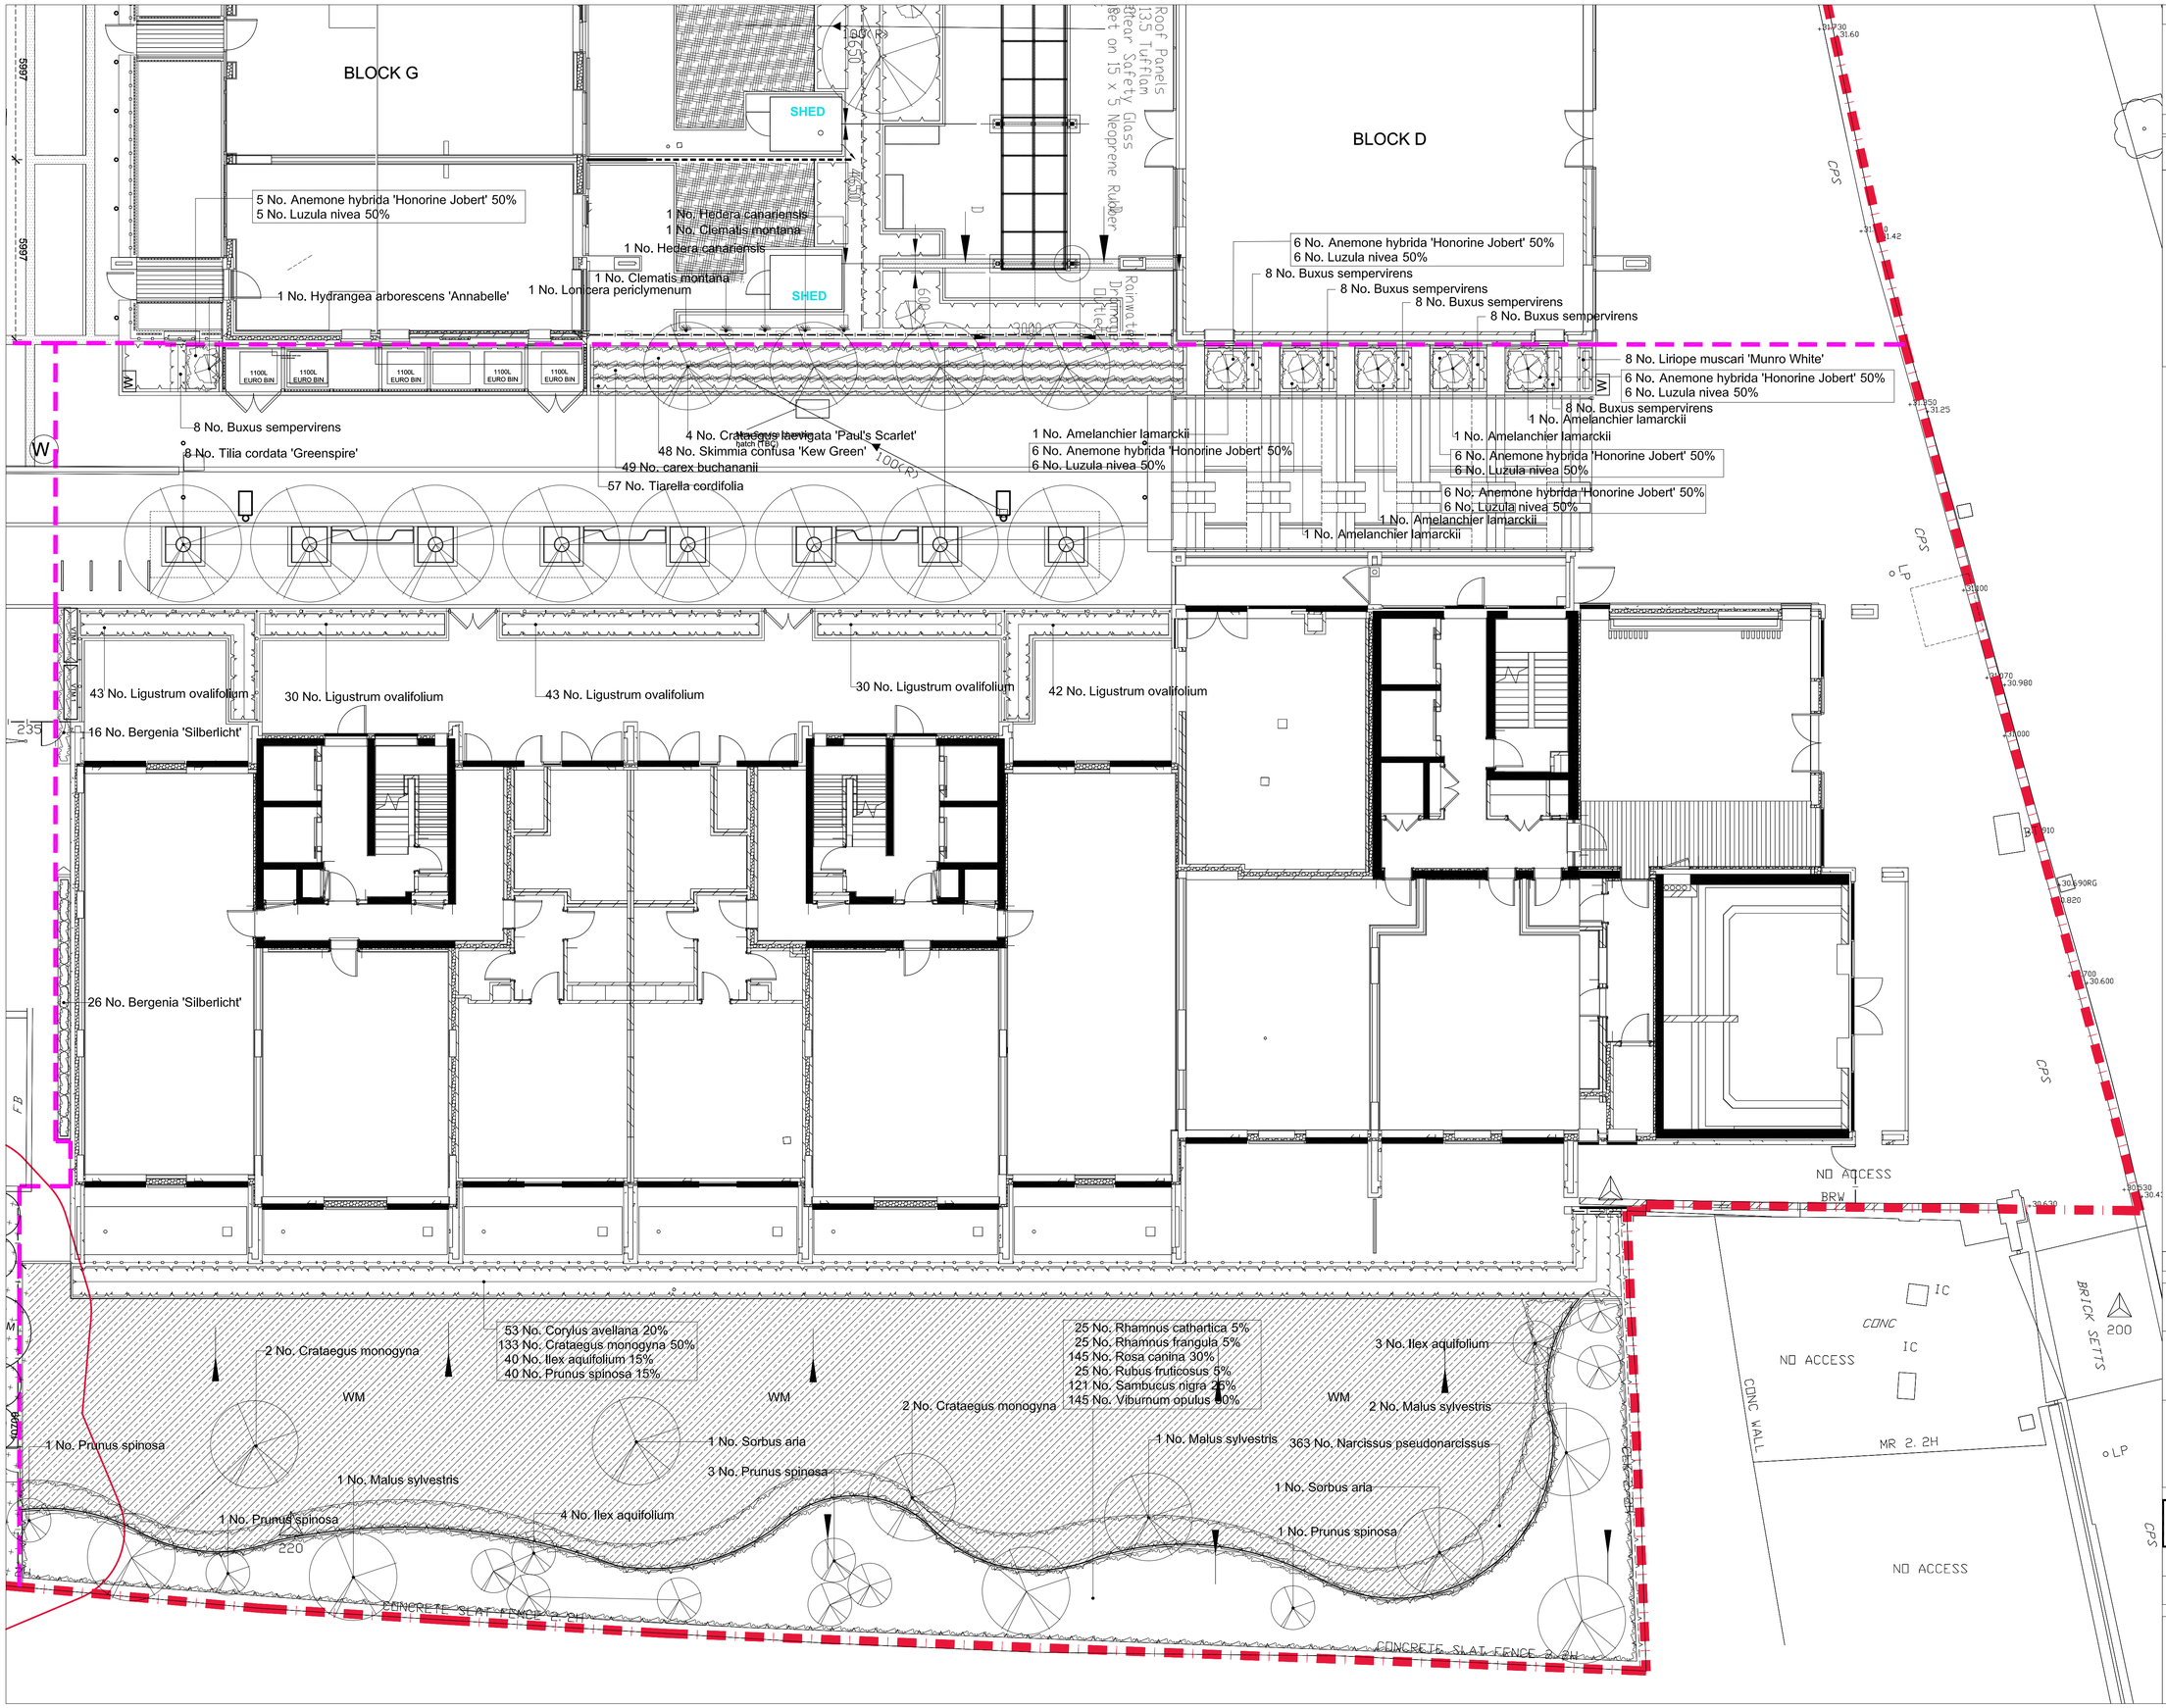

notes

- The contractor is responsible for checking dimensions, tolerances and references. Any discrepancy to be verified with the Architect before proceeding with the works.
- Where an item is covered by drawings to different scales the larger scale drawing is to be worked to.
- Do not scale drawing. Figured dimensions to be worked to in all cases.

CDM Regulations 2007

ALL current drawings and specifications for the project must be read in conjunction with the Designer's Hazard and Environmental Assessment Record.

CDM 2007

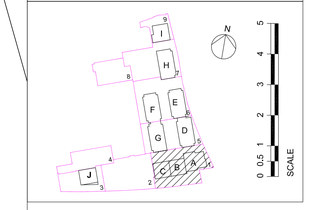

Turf
Medallion® turf by Rolawn or similar approved

Wildflower turf
Wildflower Landscape Turf by Wildflowerturf or similar approved

Wildflower turf of shady area
Premium (Hillier) Wildflower turf by Wildflowerturf or similar approved

Proposed trees

Existing tree retained

Existing tree root protection zone

Climber

date	rev	revision/author/checker
19.07.17	F	Street trees on York Way omitted MF/HS
30.06.17	E	Issued as record drawing HS/AJ
08.07.16	D	Retaining wall omitted to south west of Block B HS
17.03.15	C	issued for QA correction.HS
24.10.14	B	CONSTRUCTION Issue
02.05.14	A	General amendments to planting plan and schedule
03.04.14	-	First Issue for DT Co-ordination & Comment

purpose of issue
CONSTRUCTION

project
MAIDEN LANE

drawing
EXTERNAL WORKS:
PLANTING PLAN 1
BLOCK A, B, C

drawing no	rev
AA1692C/3.1/230	F

drawn	PW	checked	AJ
scale @ A1	1/100	date	APR 2014

PRP Architects ©
10 Lindsey Street
Smithfield
London
EC1A 9HP
T +44 (0)20 7653 1200
F +44 (0)20 7653 1201
lon.prp@prparchitects.co.uk