NOTE

THIS DRAWING IS TO BE READ IN CONJUNCTION WITH ALL OTHER RELEVANT DRAWINGS AND SPECIFICATIONS

THIS DRAWING HAS BEEN PREPARED FOR IDENTIFICATION PURPOSES ONLY. VERIFICATION OF DRAWN INFORMATION TO BE CARRIED OUT BY CONTRACTOR PRIOR TO OTHER USE.

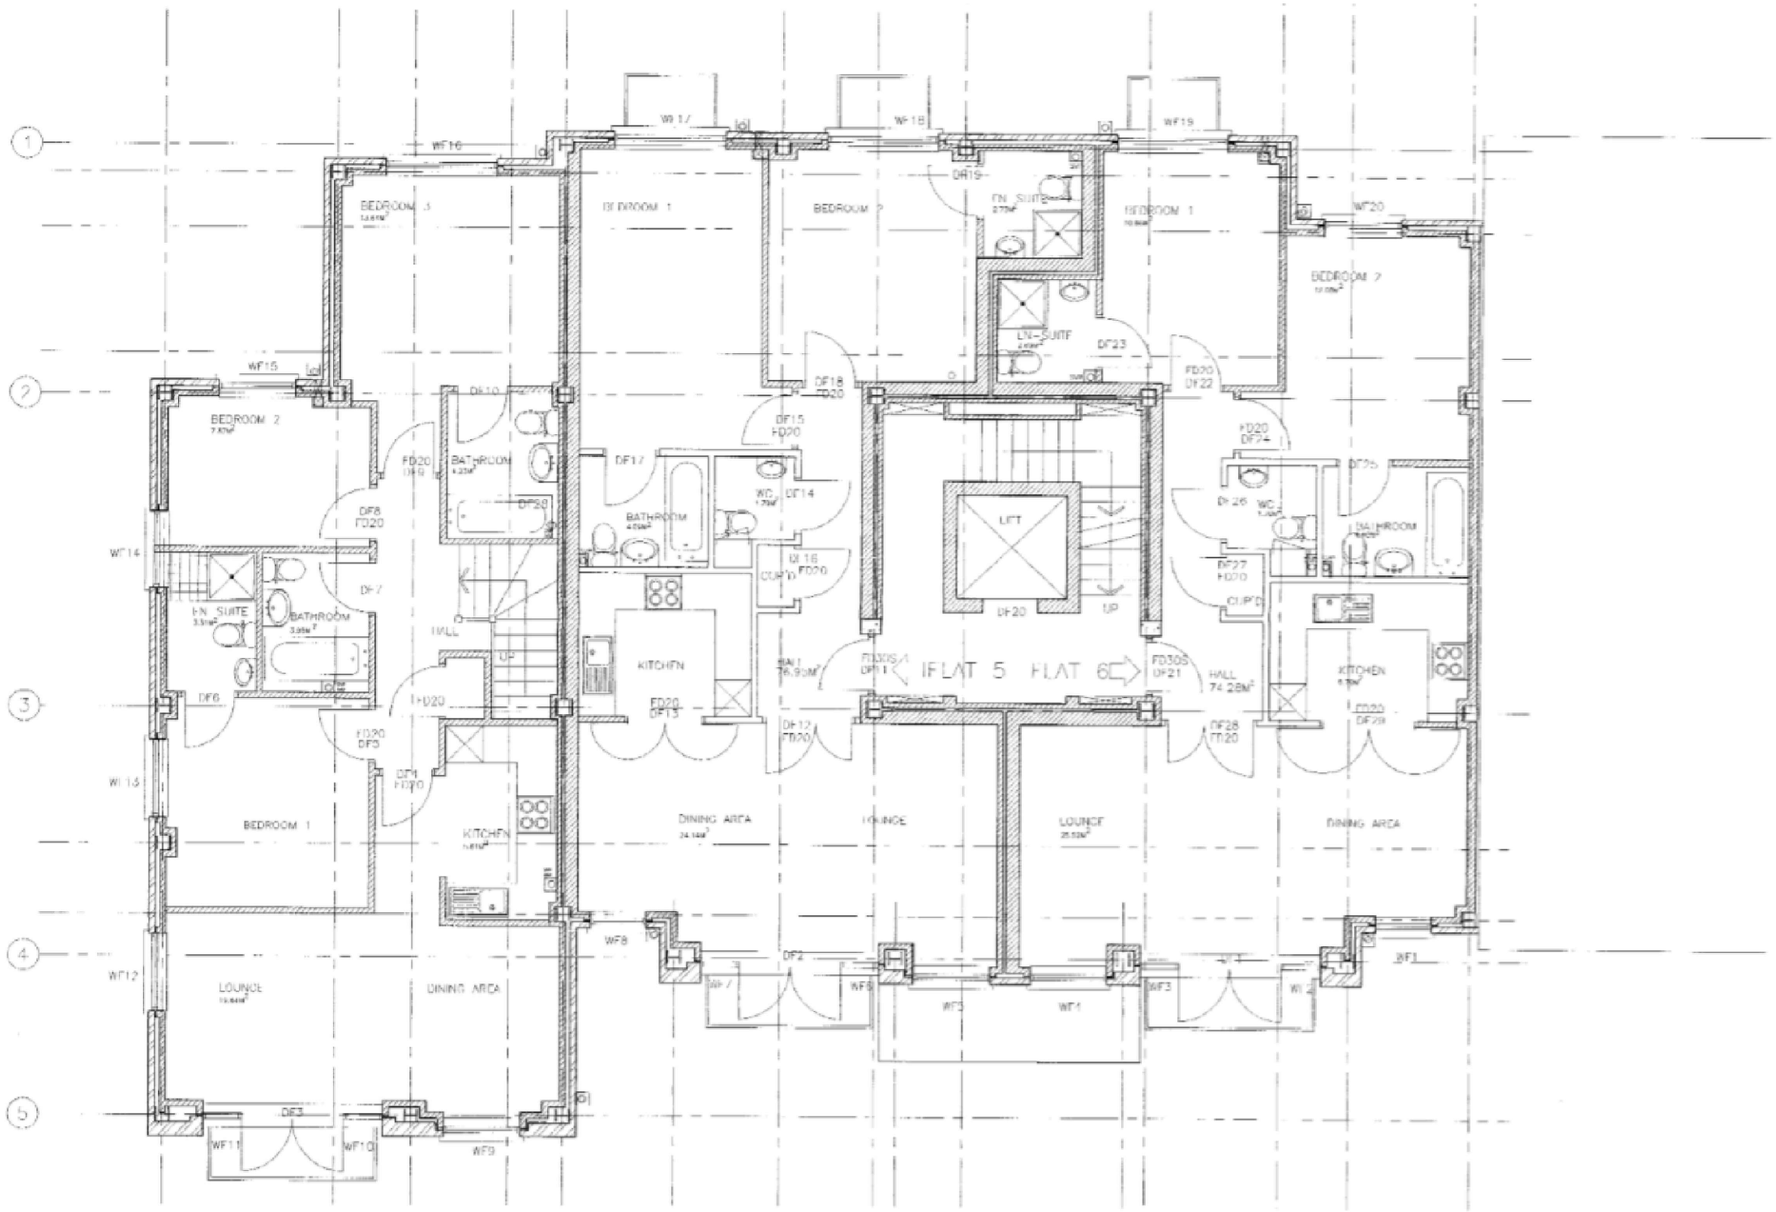

FIRST FLOOR PLAN

SCALE - meters

1 2 3M 6M

Extract from archive drawings

rev

STEVEN ADAMS RIBA ARCHITECTS

28b ENGLANDS LANE
LONDON NW3 4UE
Tel 020 7722 7664
Fax 020 7722 7652

project	no
HEATH CUT LODGE LONDON NW3	720

drawing	no
RECORD DRAWING EXISTING FIRST FLOOR PLAN	RD 02

scale	date	drawn	checked
1:100@A3	23.11.17	RE	SAA