1:50.

ALL LEVELS ARE IN METRES RELATED TO ORDNANCE DATUM LOCATED ON CAMDEN HOUSE INVERNESS STREET (value 28.87m)

sh	sill to head height
fs	floor to sill height
u/s	underside height
t/s	topside height
fb	floorboard direction
conc	concrete
rl	roof light
cup'd	cupboard
fp	fireplace
sd	sliding door
svp	soil and vent pipe
rwp	rain water pipe
©	carpet
(3.17)	room height
- - - -	roof slope

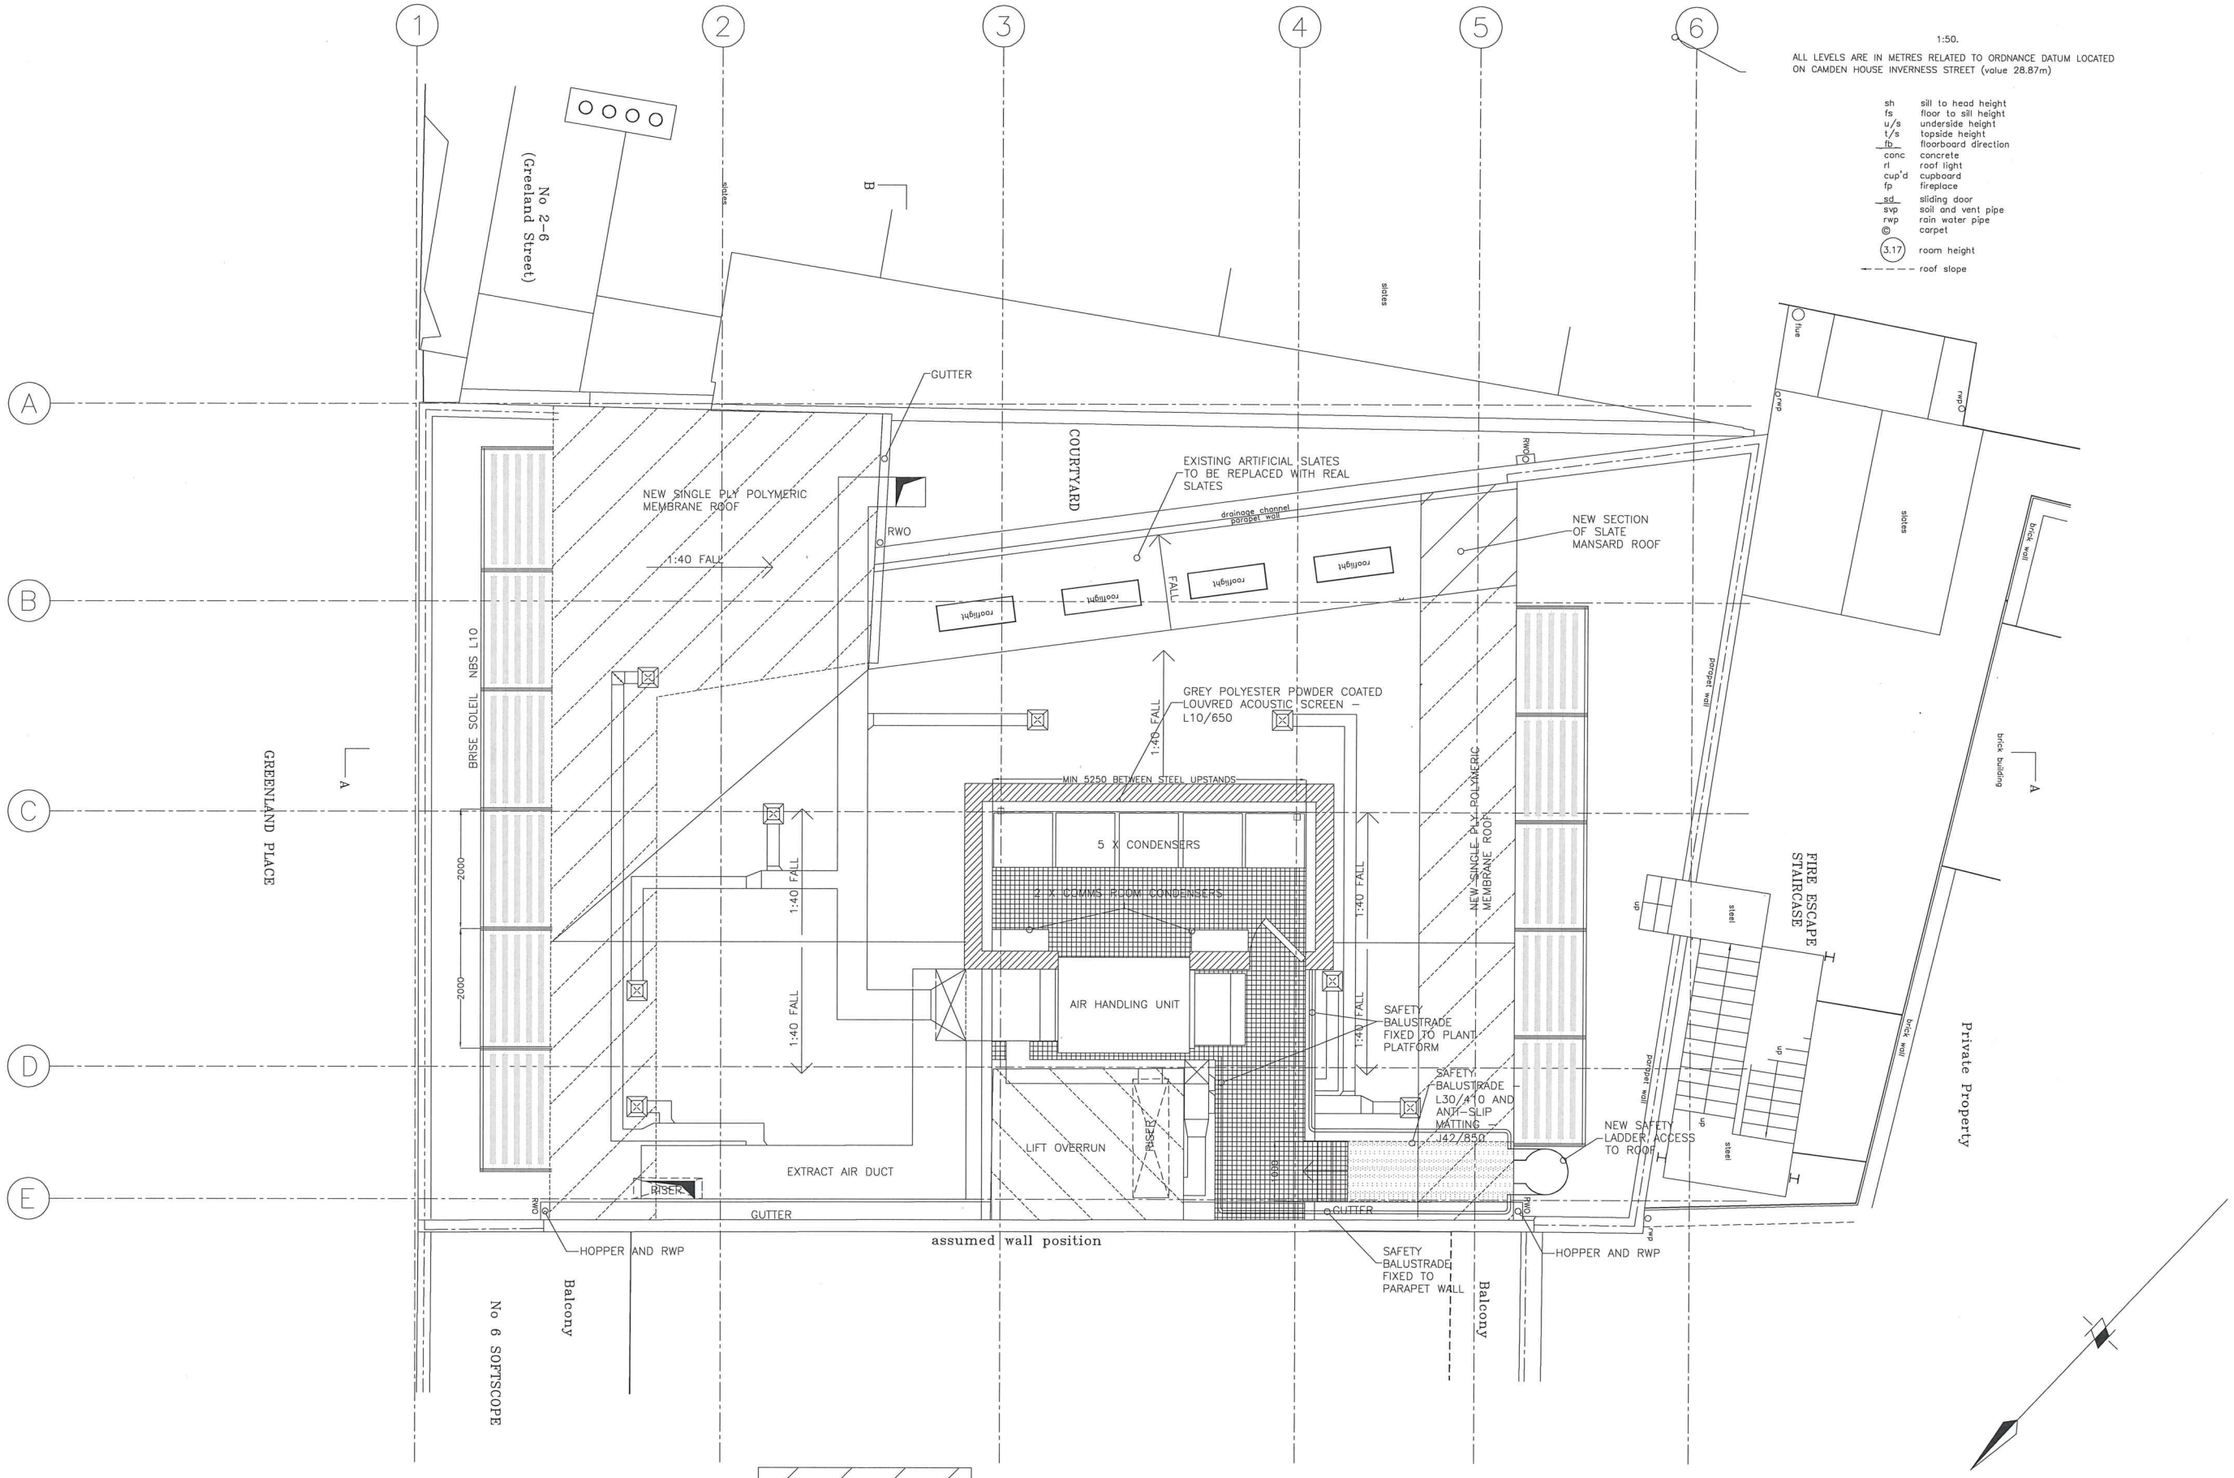

AREA OF NEW ROOF STRUCTURE

revision	date	initials	description of amendments
F	27.09.06	HJ	STATUS CHANGED TO AS BUILT

AS BUILT

Foundation architecture ltd.

Saloon House, 5-12 Mandela Street, London NW1 0DU t 0207 383 5511 f 0207 383 5522 e foundationarchitecture@yahoo.co.uk

project: NSPCC, 7-8 GREENLAND PLACE, LONDON, NW1 0AP

title: ROOF PLAN - PROPOSED

scale	date	drawn	checked	job no.	dwg no.	rev.
150@A1	MAY 2006	FAL		369	P105	F

Do not scale from this drawing. All dimensions to be verified on site.

*Scale is 1:100 at A3