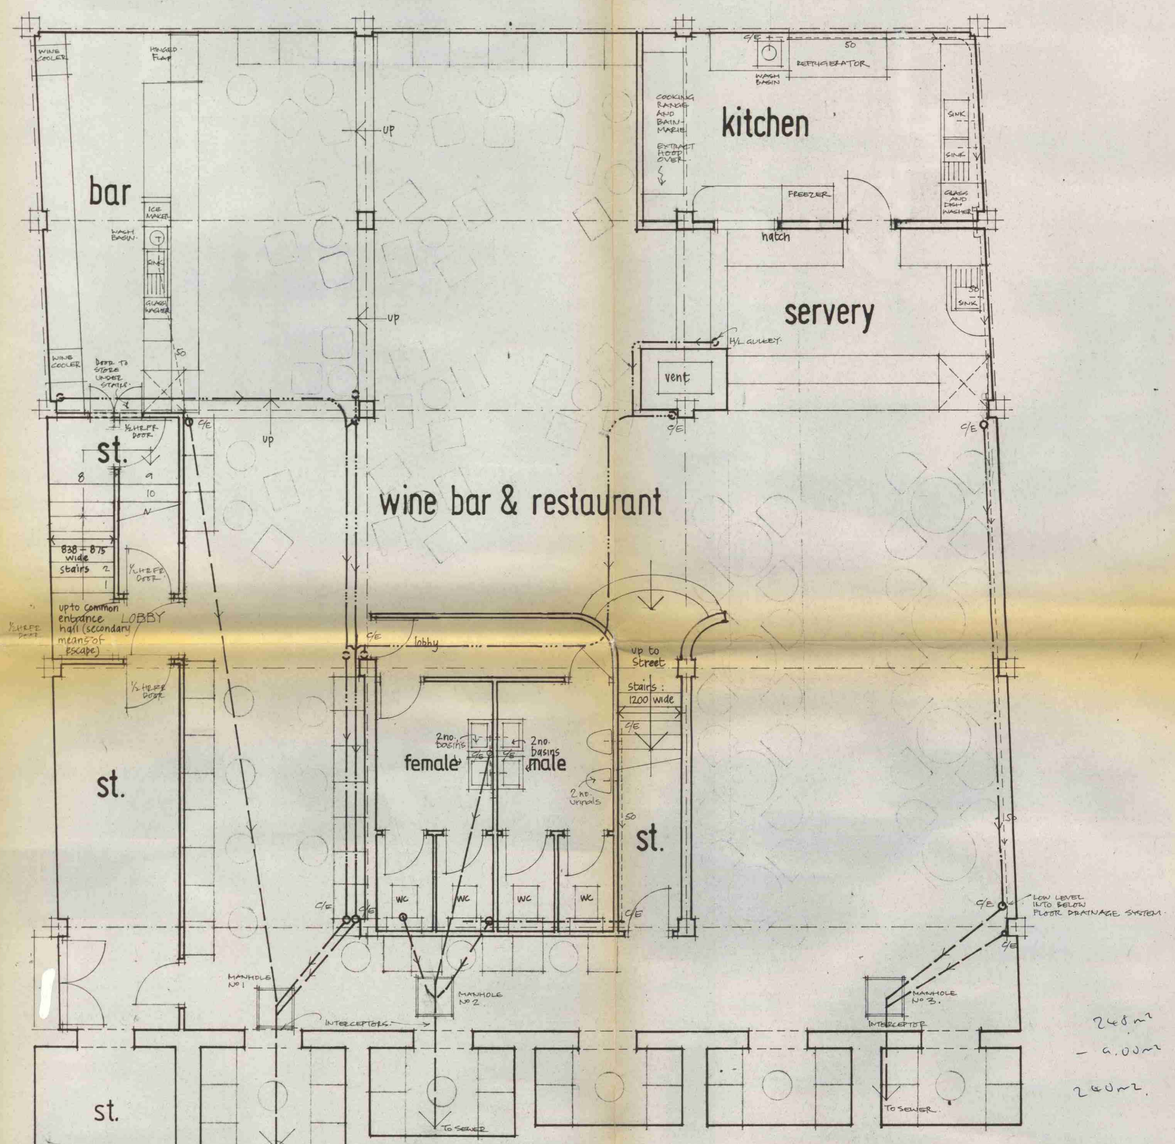

total seating shown : 125 persons

approx. floor area excluding toilets, stairs, storage, bar, kitchen & servery : 177 sq.m (1910 sq.ft.)

BASEMENT PLAN

Do not scale; work to figured dimensions.
Check all dimensions on site.
Report all discrepancies to Architect

notes

- ABS WASTE PIPE. DIA. IN MM
- CI CAST IRON PIPE OVERHEAD
- " " " AT FLOOR LEVEL
- " " " BELOW FLOOR
- " " " AT HIGH LEVEL FROM FLATS.
- " " " DOWN TO BELOW FLOOR LEVEL.

G/E ACCESS FOR RODDING.

G.C. Fey 9.4.85

OCT 84	MINOR REVISIONS TO DRAINAGE AND LAYOUT AS BUILT	A

revisions

Lambiel Associates

Architects
1 Allsop Place London NW1 5LE
01-935 8561

client

MR. S.K. JOSHI

job and drawing title

139-143 WHITFIELD ST.
LONDON W1

TP 8500~~619~~ 989

BASEMENT PLAN
DRAINAGE DIAGRAM

PROPOSED WINE BAR AND RESTAURANT

scale	drawn	date
1:50	ggr	27.2.84

drawing number

job	number	revision
401	3	A

LONDON BOROUGH OF CAMDEN
TOWN AND COUNTRY PLANNING ACTS
11 JUL 1985
PLANS NOT APPROVED
ON BEHALF OF THE COUNCIL

RECEIVED
1 APR 1985 (PM)
PLANNING AND COMMUNICATIONS
DEPARTMENT
LONDON BOROUGH OF CAMDEN
ACK: REF. TO: