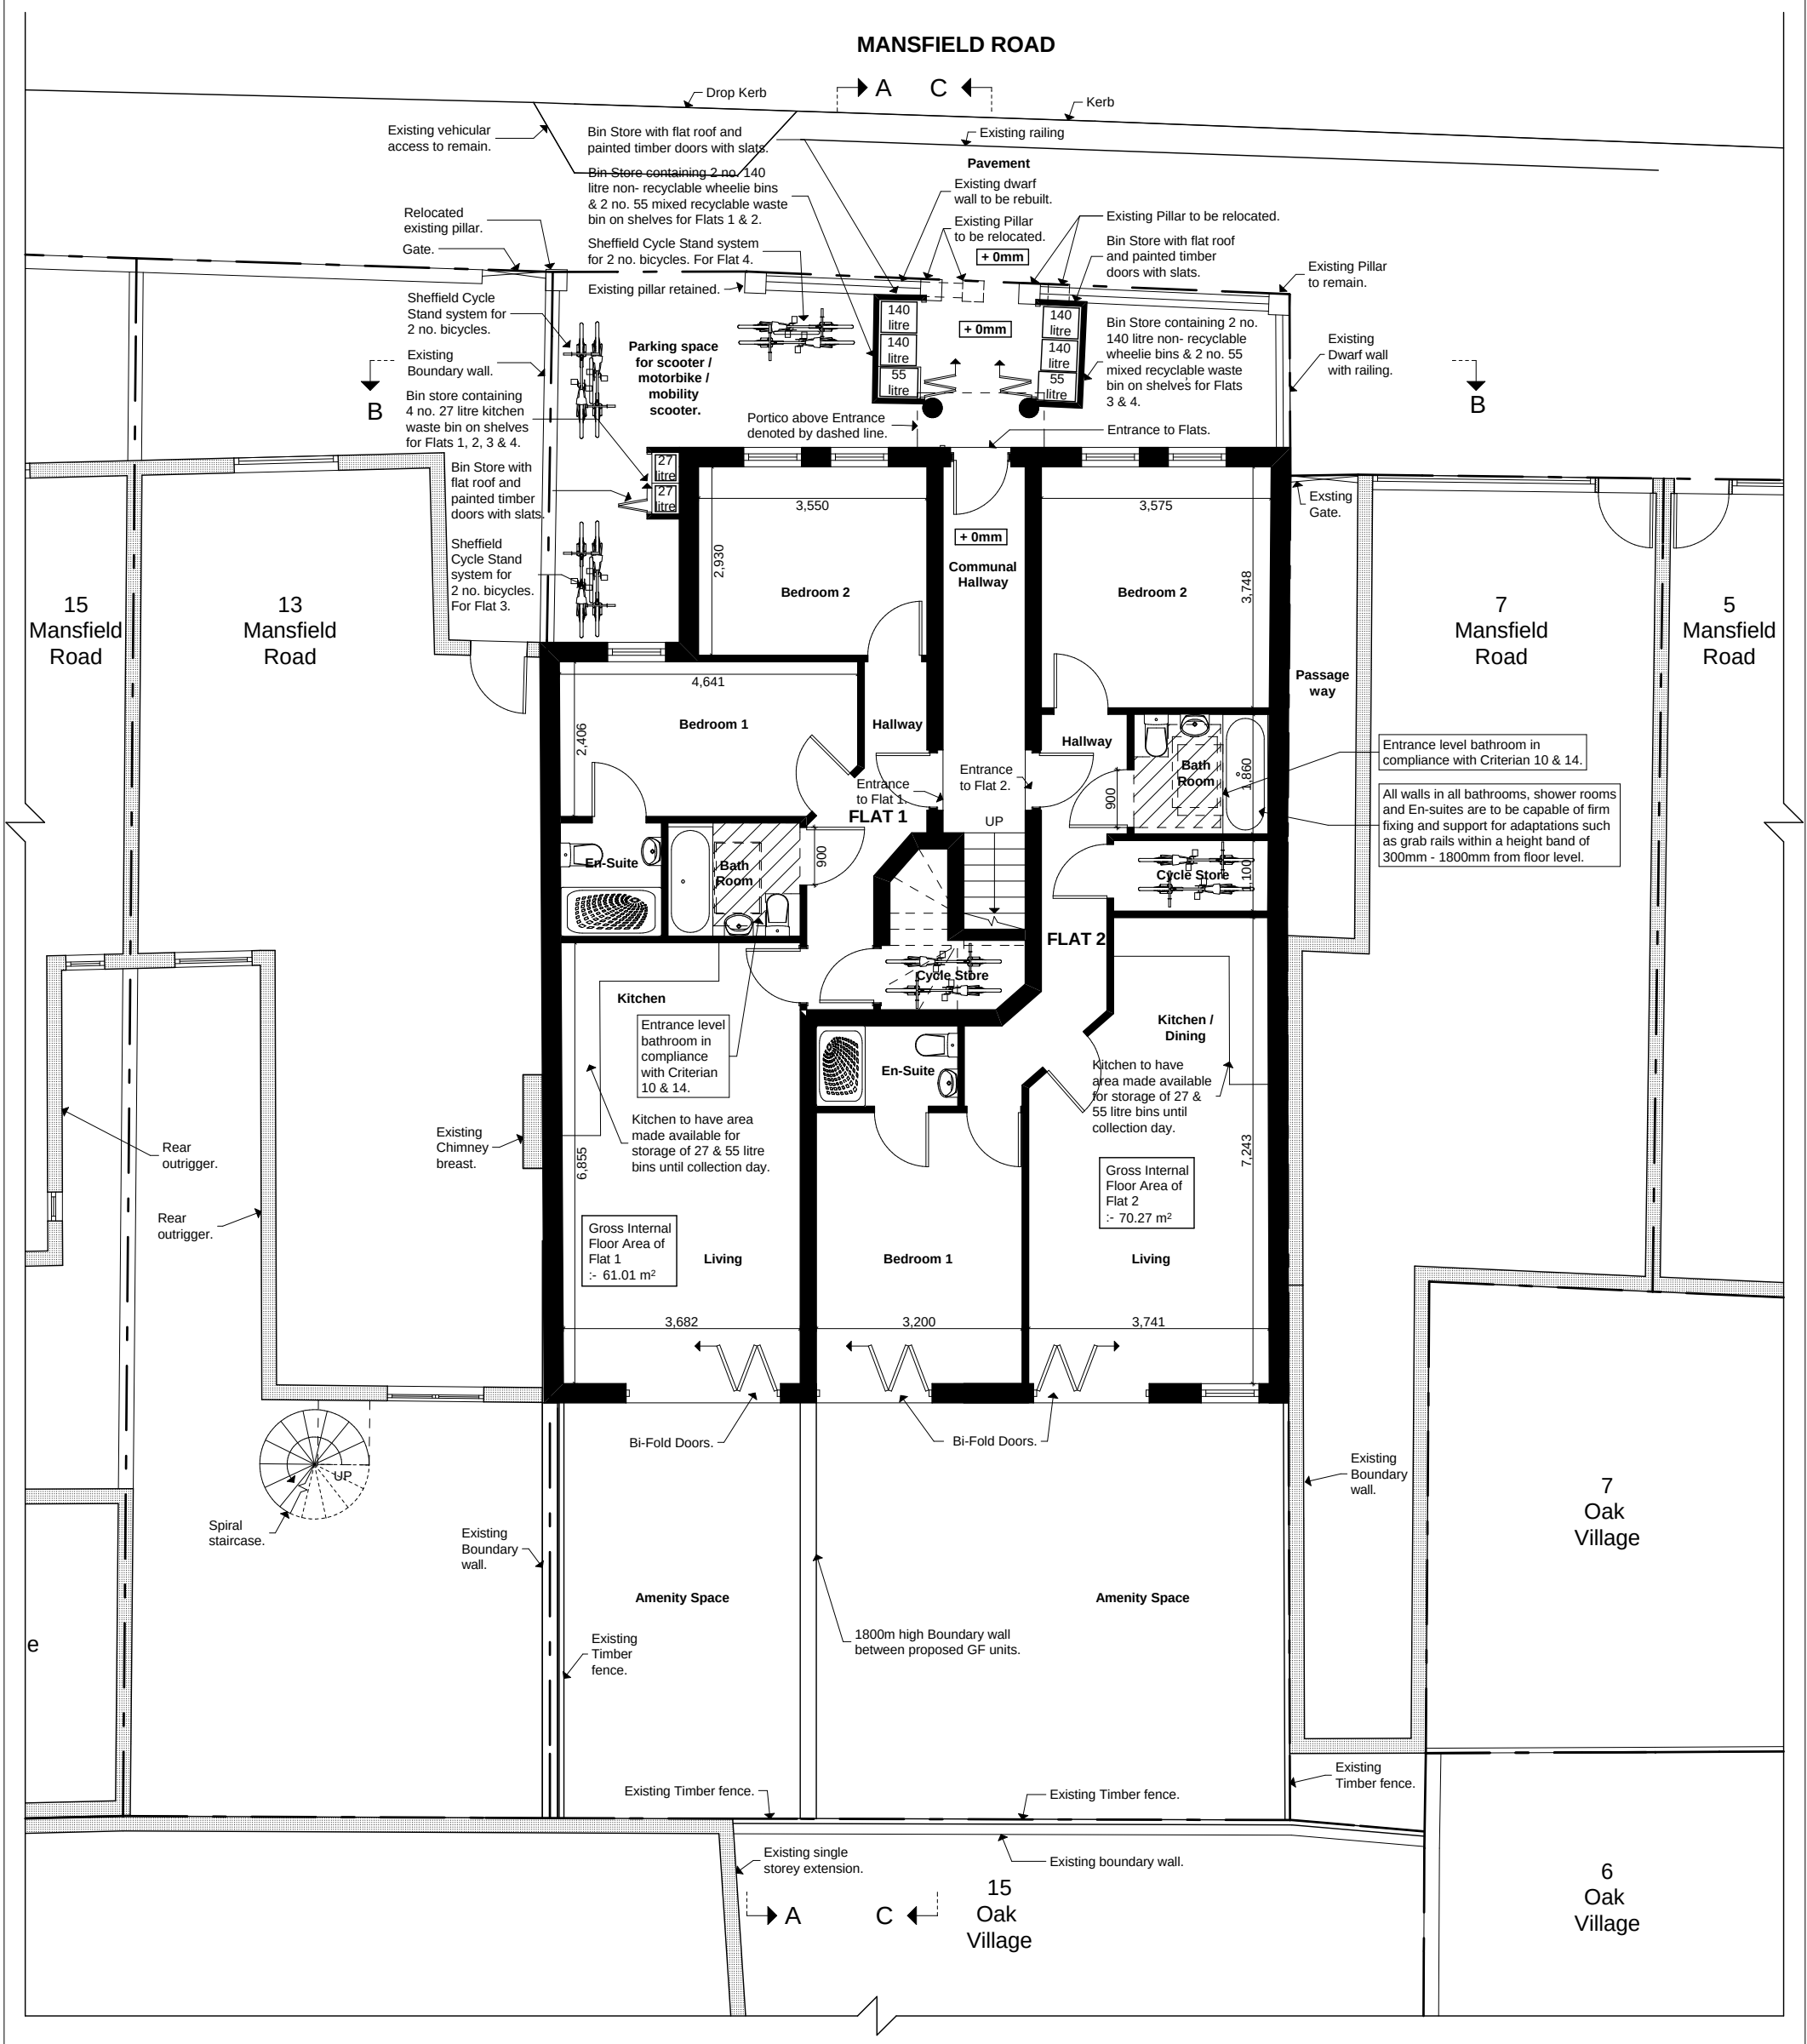

Key

- Existing walls to be retained.
- Existing walls to be removed.
- Proposed walls.

0 1m 5m 10m

N

Project 9-11 Mansfield Road		Reference Number 1110-BA-113 B	
Client Mr. & Mrs. Hauser	Date Dec 13	Scale 1:100	Drawing Size A3
Drawing Proposed Ground Floor Plan			

Preliminary	
Planning	■
Building Regs	
Tender	
Construction	
As Built	

Rev	Date	
A	04-03-14	Amendment to bin store.
B	25-03-14	Amendment to bin stores.

File Ref: 1110 - BA - Plans 4.pln

© Copyright

ARCHITECTS
DONALD SHEARER
CHARTERED ARCHITECTS
Scholar's House, Shottery Brook Office Park, Timothy's Bridge Road, Stratford-upon-Avon, Warwickshire, CV37 9NR
Tel: 01789 294 560
Fax: 01789 294 549
donald@ds-architects.demon.co.uk