


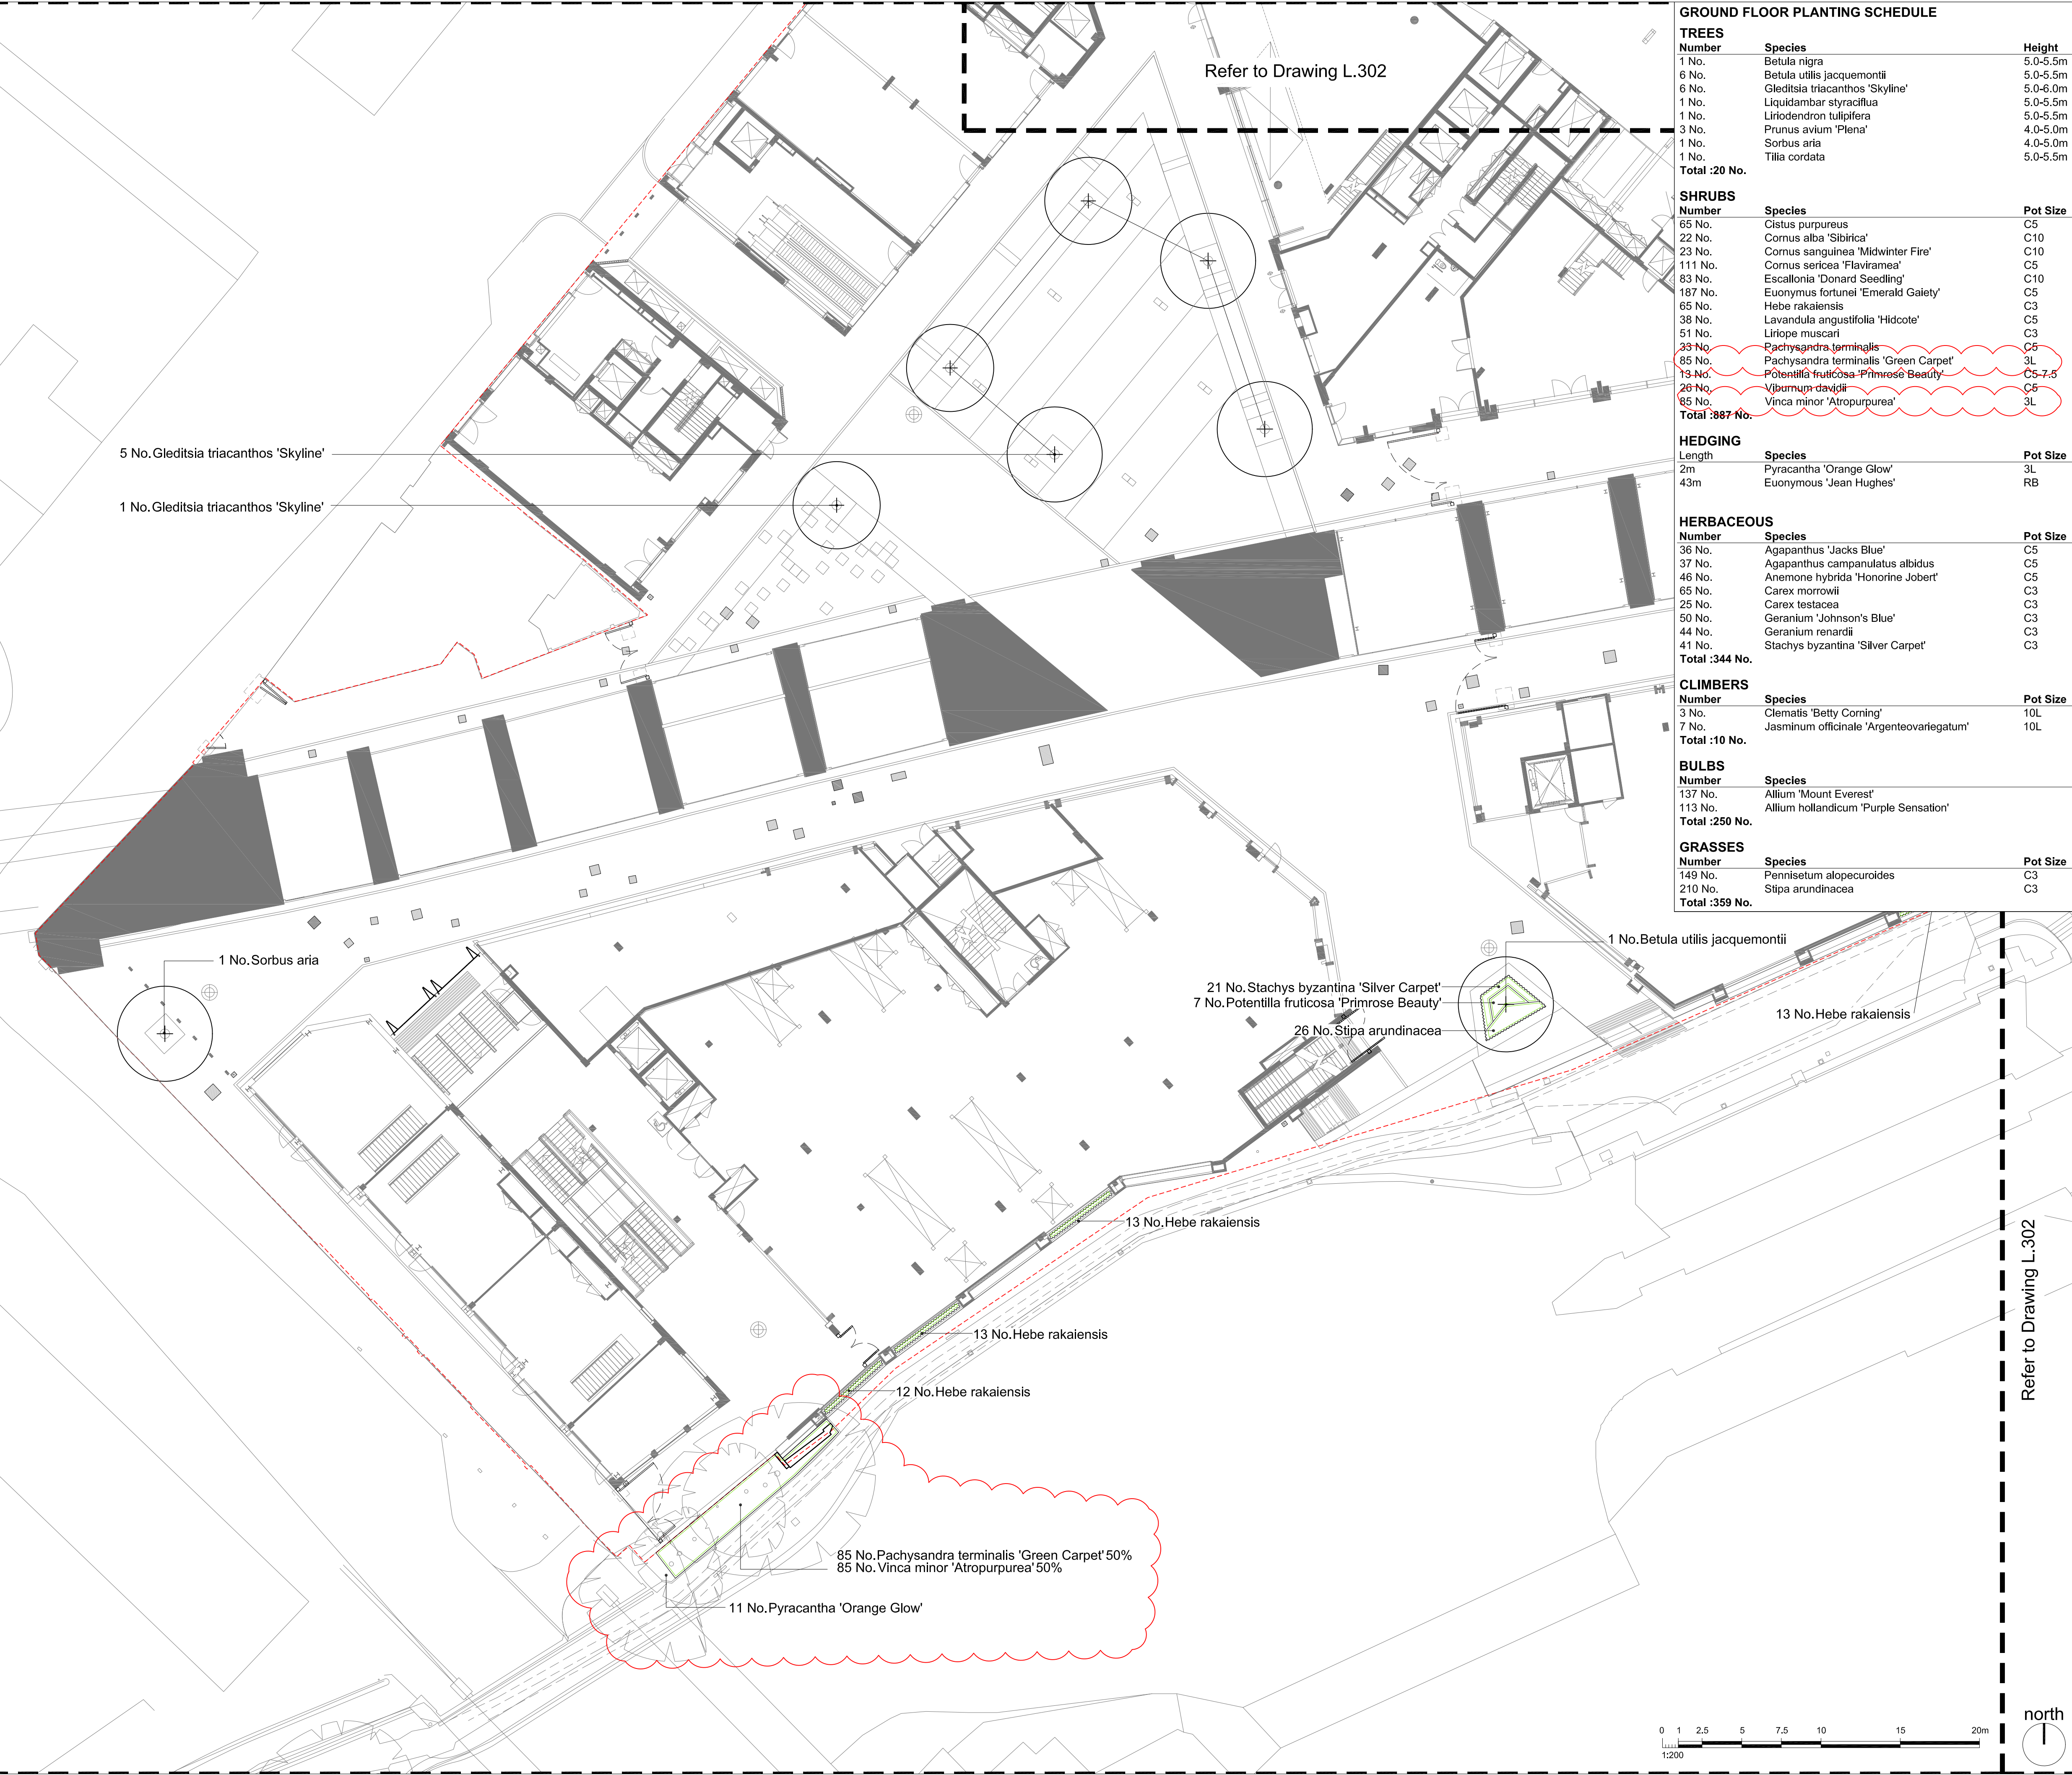

Refer to Drawing L.302

GROUND FLOOR PLANTING SCHEDULE

TREES					
Number	Species	Height	Girth	Density	Specification
1 No.	Betula nigra	5.0-5.5m	35-40cm	Counted	min 200cm clear stem :Semi-Mature :5x
6 No.	Betula utilis jacquemontii	5.0-5.5m	20-25cm	Counted	min 200cm clear stem :Semi-Mature :4x
6 No.	Gleditsia triacanthos 'Skyline'	5.0-6.0m	20-25cm	Counted	min 250cm clear stem :Semi-Mature :4x
1 No.	Liquidambar styraciflua	5.0-5.5m	35-40cm	Counted	min 200cm clear stem :Semi-Mature :5x
1 No.	Liriodendron tulipifera	5.0-5.5m	35-40cm	Counted	min 200cm clear stem :Semi-Mature :5x
3 No.	Prunus avium 'Plena'	4.0-5.0m	20-25cm	Counted	min 200cm clear stem :Semi-Mature :3x
1 No.	Sorbus aria	4.0-5.0m	20-25cm	Counted	min 200cm clear stem :Semi-Mature :4x
1 No.	Tilia cordata	5.0-5.5m	35-40cm	Counted	min 200cm clear stem :Semi-Mature :5x
Total :20 No.					

SHRUBS					
Number	Species	Pot Size	Height	Density	Specification
65 No.	Cistus purpureus	C5	40-60cm	5/m²	Bushy :5/6 brks
22 No.	Cornus alba 'Sibirica'	C10	60-80cm	2/m²	Branched
23 No.	Cornus sanguinea 'Midwinter Fire'	C10	60-80cm	2/m²	Branched
111 No.	Cornus sericea 'Flaviramea'	C5	40-60cm	5/m²	Branched
83 No.	Escallonia 'Donard Seedling'	C10	60-80cm	2/m²	Branched
187 No.	Euonymus fortunei 'Emerald Gaiety'	C5	60-80cm	5/m²	Branched
65 No.	Hebe rakaiensis	C3	30-40cm	7/m²	Bushy :5 brks
38 No.	Lavandula angustifolia 'Hidcote'	C5	30-40cm	5/m²	Bushy :7 brks
51 No.	Liriope muscari	C3	30-40cm	7/m²	Full pot
39 No.	Pachysandra terminalis	C5	30-40cm	7/m²	Several shoots
85 No.	Pachysandra terminalis 'Green Carpet'	3L	30-40cm	7/m²	
13 No.	Potentilla fruticosa 'Primrose Beauty'	C5-7.5	30-40cm	3/m²	Bushy :5 brks
26 No.	Viburnum davidii	C5	30-40cm	4/m²	Bushy :4 brks
85 No.	Vinca minor 'Atropurpurea'	3L	30-40cm	7/m²	
Total :887 No.					

HEDGING			
Length	Species	Pot Size	Specification
2m	Pyracantha 'Orange Glow'	3L	500x500x500mm Preformed Instant Hedge. Contractor to submit proposals for approval
43m	Euonymus 'Jean Hughes'	RB	

HERBACEOUS				
Number	Species	Pot Size	Density	Specification
36 No.	Agapanthus 'Jacks Blue'	C5	5/m²	Full Pot
37 No.	Agapanthus campanulatus albidus	C5	5/m²	Full Pot
46 No.	Anemone hybrida 'Honorine Jobert'	C5	7/m²	Full Pot
65 No.	Carex morrowii	C3	7/m²	Full Pot
25 No.	Carex testacea	C3	7/m²	Full Pot
50 No.	Geranium 'Johnson's Blue'	C3	7/m²	Full Pot
44 No.	Geranium renardii	C3	7/m²	Full Pot
41 No.	Stachys byzantina 'Silver Carpet'	C3	7/m²	Full Pot
Total :344 No.				

CLIMBERS				
Number	Species	Pot Size	Density	Specification
3 No.	Clematis 'Betty Corning'	10L	Counted	Several Shoots :3/4 brks
7 No.	Jasminum officinale 'Argenteovariegatum'	10L	Counted	Several Shoots :5 brks
Total :10 No.				

BULBS			
Number	Species	Density	Specification
137 No.	Allium 'Mount Everest'	12/m²	Plant in clumps
113 No.	Allium hollandicum 'Purple Sensation'	12/m²	Plant in clumps
Total :250 No.			

GRASSES				
Number	Species	Pot Size	Density	Specification
149 No.	Pennisetum alopecuroides	C3	7/m²	Full Pot
210 No.	Stipa arundinacea	C3	7/m²	Full Pot
Total :359 No.				

- Notes
- This drawing is the property of fabrik ltd. It must not be copied or reproduced without written consent.
 - Only figured dimensions are to be taken from this drawing. All contractors must visit site and be responsible for taking and checking all dimensions related to the works shown on the drawing.

P2	17.05.18	Updated following development of proposal of planting bed around existing MN	MB
P1	23.04.18	TPO trees. Issued for planning approval	MB
C2	28.07.17	Issued for planning approval	MB
C1	12.04.17	Issued for construction post VE	CB
No.	Date	Reason	Drawn
Revisions			Checked

- External References:
- 14045_VX_(00)_1200_iss4_revF01
 - 14045_CX_(00)_1200_iss5_revC01
 - 14045_AX_(00)_1200_iss6_revF03
 - 14045_AX_(00)_1190_iss7_revF04
 - 14045_EX_(00)_1200_iss8_revC02
 - 14045_WX_(00)_1200_iss13_revC04

fabrik

First Floor
4-8 Emerson Street
London
SE1 9DU

T : 0207 620 1453
E : london@fabrikuk.com
W : www.fabrikuk.com

Project

Camden Lock Village, Camden Town, London
for Mace

Drawing

Ground Floor- Detailed Soft Landscape General
Arrangement Plan - Sheet 1

Scale	Date	Checked	Drawn
1:200 @ A1	March '17	cb	pc
Drawing No.			Revision
D2456 L.301			P2

☐ Preliminary	☐ Issued for Design/Information
☒ Issued for Planning Approval	☐ Issued for Tender
☐ Issued for Construction	☐ As Built