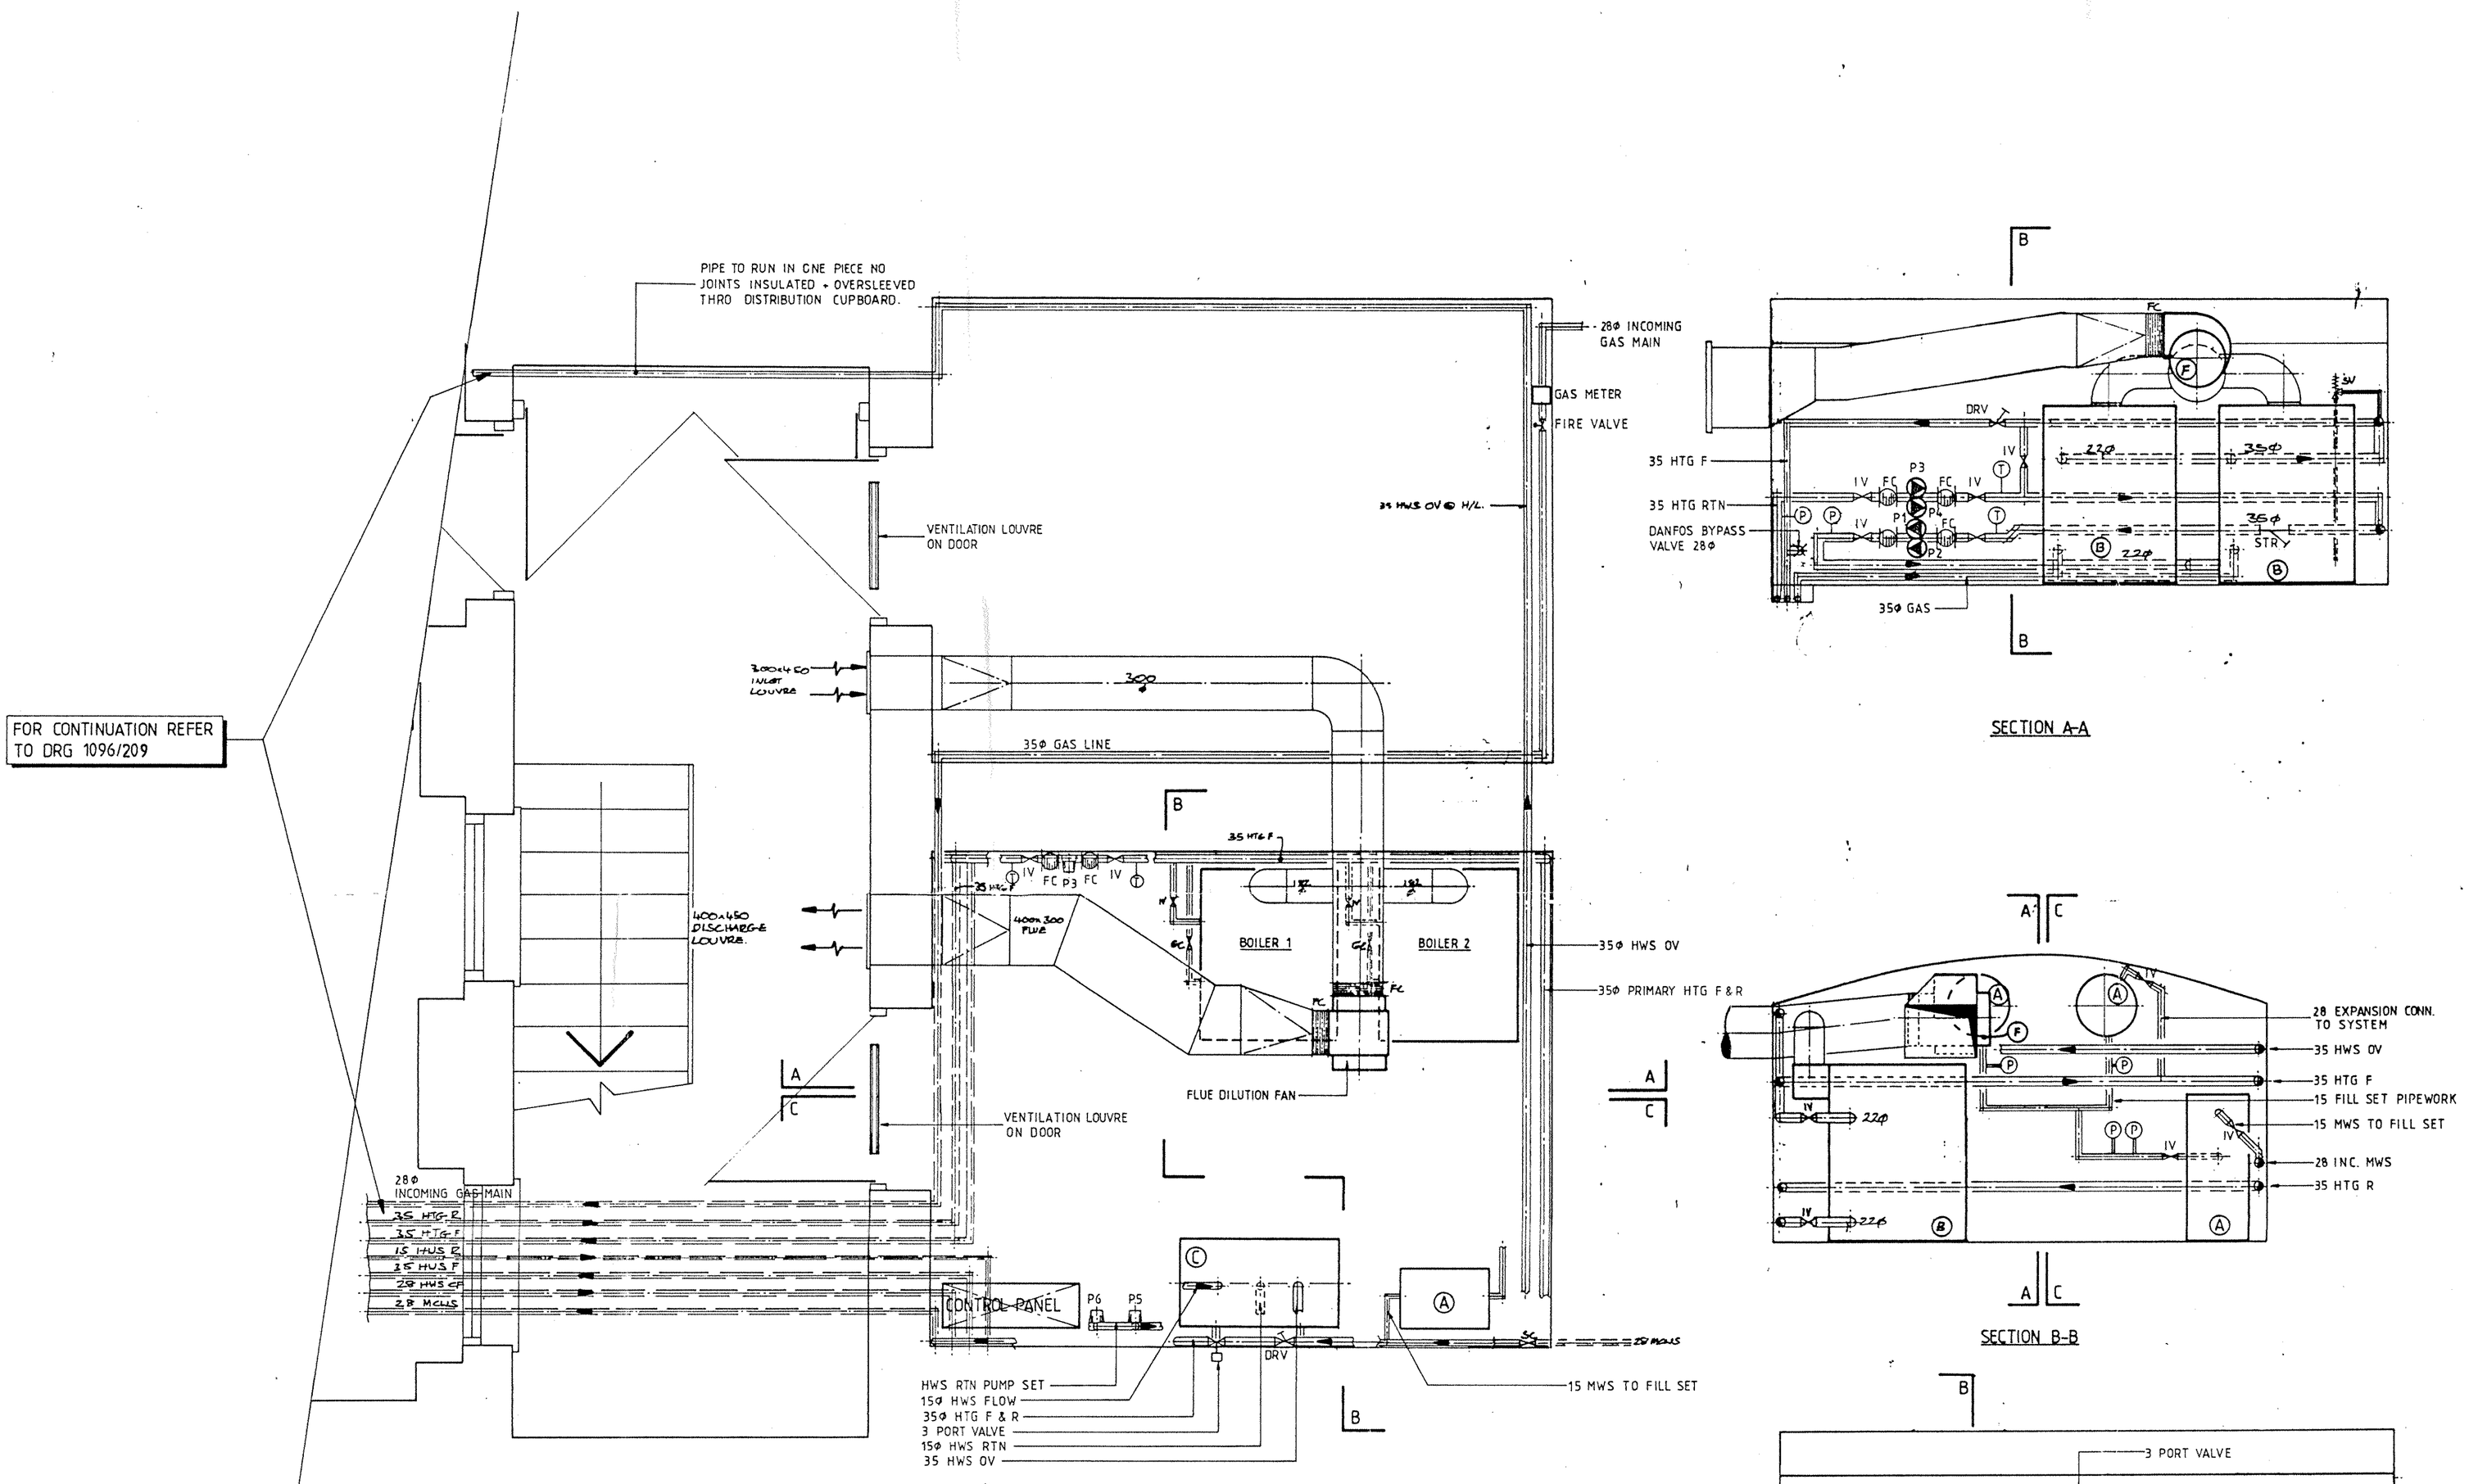

PLAN

Nº 6 BAYLEY STREET.

SECTION A-A

SECTION B-B

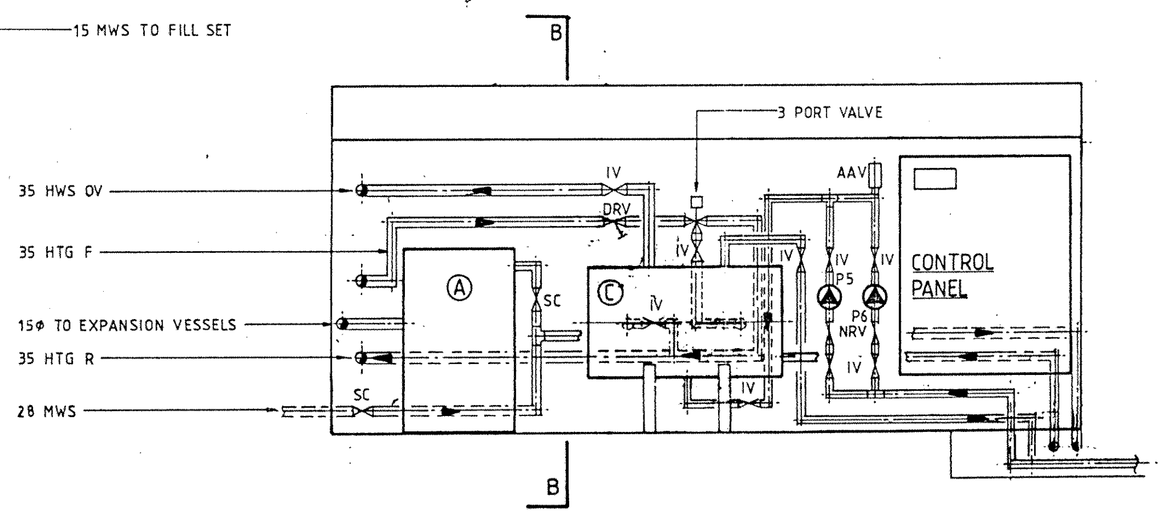

SECTION C-C

EQUIPMENT SCHEDULE:

- (A) AUTOMATIC FILL SET & EXPANSION VESSEL. BRECO FLEXFILLER STD. 2 No 50 LTR WALL MTD VESSELS, & CONNECTING GROUP.
- (B) GAS FIRED ATMOSPHERIC BOILER. HOVAL MODEL ATMOSGAS 45.
- (C) MANCHESTER TYPE HI HORIZONTAL CALORIFIER C/W MY1224 IMMERSION HEATER.
- (F) FLUE DILUTION FAN: AIDELLE AIRFLOW MODEL GBDF 3.

P1, P2 } GRUNDFOS UPSD50-120F PRIMARY, SINGLE PHASE TWIN HEAD PUMP.
P3 } GRUNDFOS UPED 40-80 F HEATING, SINGLE PHASE TWIN HEAD PUMP.
P4, P5 } GRUNDFOS UP20-07N SECONDARY, SINGLE PHASE SINGLE HEAD PUMP.

RECORD DRAWING

100mm Original size

Design & Installation
Air Conditioning
Electrical
Heating & Ventilation
Service & Maintenance

REVISIONS		
REV	DESCRIPTION	DATE

CLIENT
THE BEDFORD ESTATES

PROJECT
7 BAYLEY STREET
LONDON
WC1

TITLE
BASEMENT PLAN
BOILER ROOM DETAILS

DRAWING NUMBER
1097/314 RD

REVISION

DATE
JAN 1994

SCALE
1:20

Built Environment Engineering LIMITED
Unit 3
Wadsworth Business Centre
Bilton Way, Perivale
Middlesex, UB6 7HR
Tel: (0181) 537 2555
Fax: (0181) 537 2556

Copyright Reserved