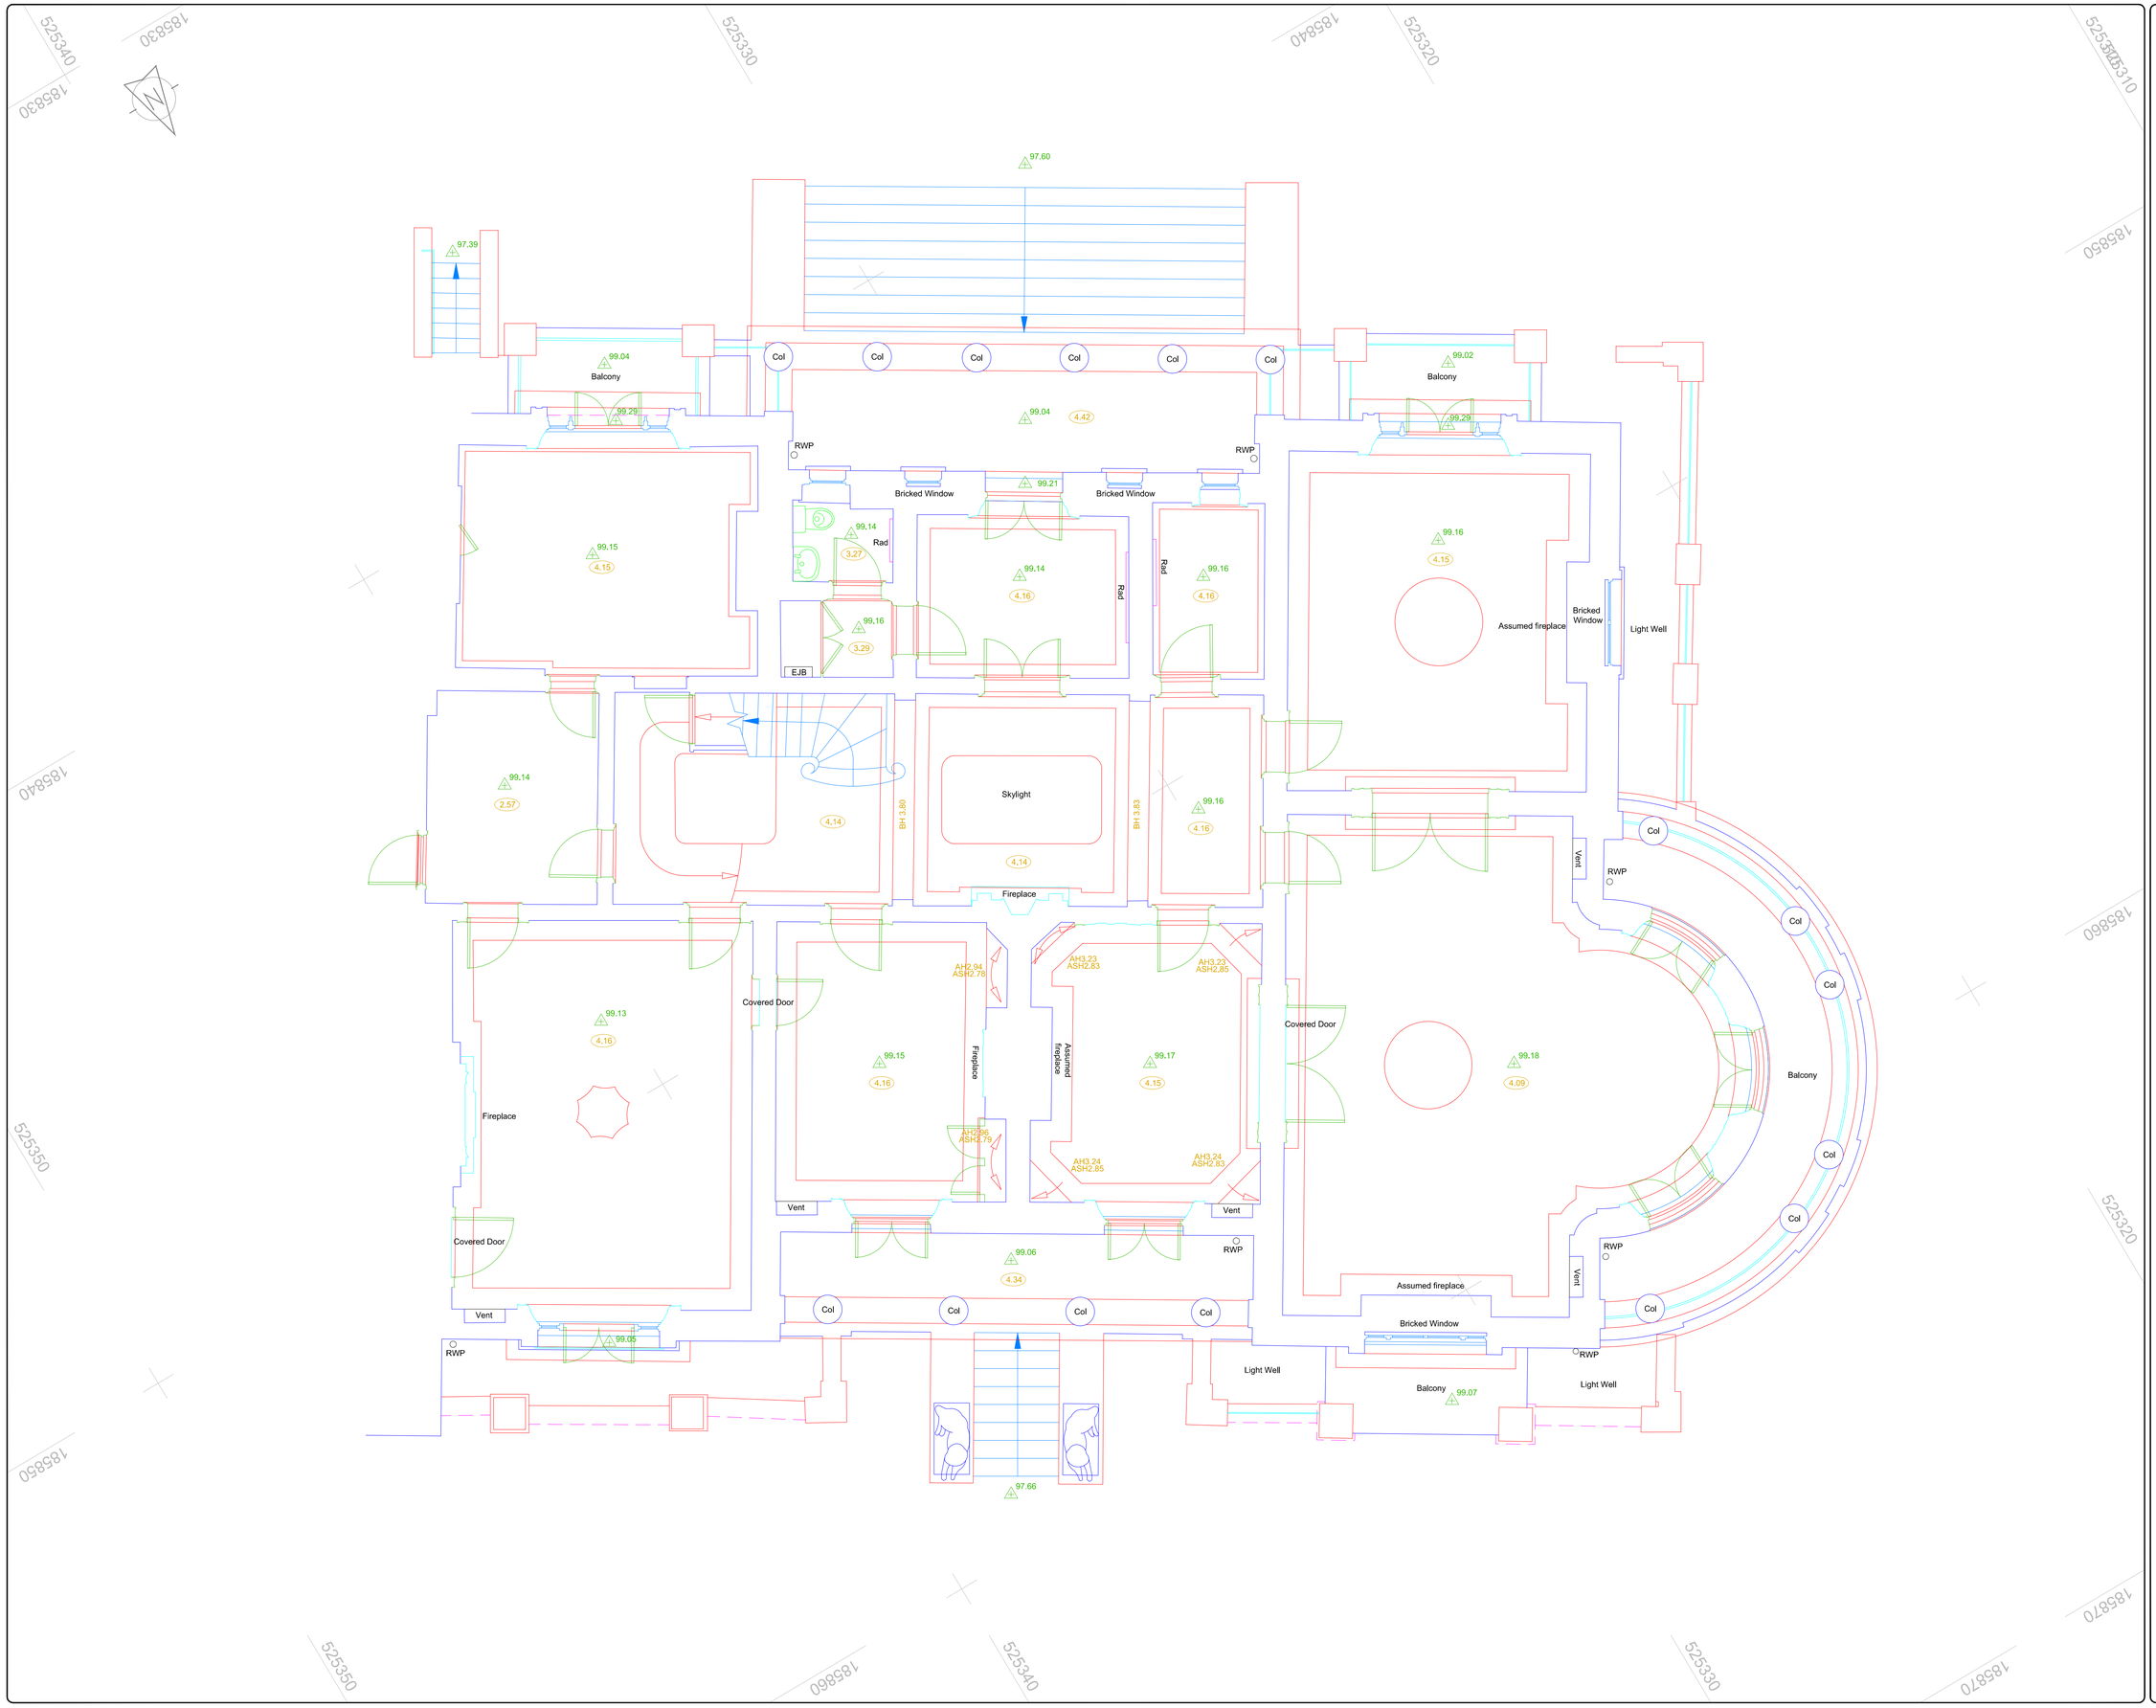

LEGEND

Built Features
Roads & Road Markings

- Building
- Wall
- 5.12 Edge of Road
- 5.12 Footpath
- 5.12 Kerb (bottom)
- 5.12 Kerb, (top)
- ARMCO Crash Barrier
- 5.12 Railway
- Line of Fence
- CONCB Concrete Base
- 5.12 Surface Change

Internal Survey Features

- SL Survey Station
- + 5.12 Hard Surface
- FL Floor Level
- EAVES Eaves Height
- PARAPET Parapet Height
- SOFF Underside of Soffit
- + 5.12 Top of Wall Level
- STPL 5.12 Step Level
- LD Land Drain
- Tree Coniferous
- Tree Deciduous
- BH 3.63 Beam Height
- DH 2.22 Door Height
- F-C 0.37 C/H 3.31 Floor to Cill Cill to Head
- h 0.9 Height
- FD Fire Door

- 20.00 Ceiling Level
- 20.00 Floor Level
- 2.70 Ceiling Height
- 2.700 False Ceiling Height
- Ceiling Slope Arrows point up unless on roofs
- Arched Ceiling
- Roof Access
- Window
- Sash Window
- Radiators
- Door
- Wardrobe Door
- Sliding Door
- Sink / Bath
- Toilets
- Showers

Description of Features

A/C	Air Conditioner	Flt	Floodlight
AH	Arch Height	F-C	Floor to Cill Height
AL	Arch Level	h	height
ASH	Arch Spring Height	HR	Handrail
ASL	Arch Spring Level	IC	Inspection Cover
B	Bollard	L	Light
BGP	Break Glass Point	Max	Maximum
BH	Beam Height	Min	Minimum
BSL	Beam Soffit Level	O/H	Overhead
C-H	Cill to Head Height	OSBM	Ordnance Survey Bench Mark
Conc	Concrete	Rad	Radiator
Cup	Cupboard	RDM	Recessed Door Mat
DH	Door Height	RSJ	Rolled Steel Joist
DP	Down Pipe	RWP	Rain Water Pipe
D/C	Drainage Channel	SBM	Site Bench Mark
ESG	Electrical Switchgear	SH	Spring Height
FA	Fire Alarm	SL	Skylight
FE	Fire Extinguisher	V	Vent
FH	Fire Hydrant	VP	Vent Pipe
FHR	Fire Hose Reel	WH	Water Heater
EJB	Electrical Junction Box		

Murphy Surveys Ltd. Disclaimer

The user or recipient of this survey data understands and acknowledges this data may be inaccurate or contain errors or omissions and the user or recipient assumes full responsibility for any risks or damages resulting from, arising from, or in connection with any use of or reliance upon data displayed herein. Although significant care has been exercised to produce surveys that satisfy survey accuracy standards, these surveys are only as accurate as the source data from which they were compiled. Although all reasonable steps have been taken to locate all features visible at the time of the survey, there is no guarantee that all will be shown on the drawing, as some above ground features may have obstructed the survey. Wherever possible, areas unable to be surveyed will be labelled as "UTS".

The Company shall not be liable for any inaccuracy of the data provided beyond the specified scale or accuracy, or for any matters resulting from their use for purposes other than that stated in the Contract. No liability shall attach to the Surveyor in respect of any consequential loss or damages suffered by the Client.

The Client must promptly notify the Company of any errors in mapping of which it becomes aware. If misleading, inaccurate or otherwise inappropriate information is brought to the Company's attention or the Company itself identifies any such imprecision or error in a survey, it shall use its reasonable endeavours to fix or remove it and if necessary in certain instances, the Company being on notice of any such misleading, inaccurate or otherwise inappropriate information, it will re-conduct the survey and reproduce the data to within the specified scale or accuracy.

North

Site Location

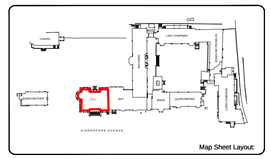

Map Sheet Layout:

Surveyed by : GB	Date: 22/07/2014	Datum :	OSGB
Drawn by : MP	Date: 19/09/2014	Grid System:	OSGB
Checked by : MSM	Date: 22/09/2014		

Revisions

No	Date	Description
A	22/09/2014	First Issue
B	13/10/2014	Drawing Flattened To 2d

No. 318

murphy SURVEYS
GLOBAL CONSULTING SURVEYORS

Topographic surveys, Measured Building Surveys, Setting-Out, As-Built Surveys, Hydrographic Surveys, Legal Mapping, Pipeline Surveys, Services Location, Ground Penetrating Radar, Laser Scanning, Rectified Photography

London Glasgow Belfast Cork Kildare

UK Head Office
9 Devonshire Square
London
EC2M 4YF

Phone: (+44) 020 3178 6644
Email:london@murphysurveys.co.uk

www.murphysurveys.co.uk

Client :	Mount Anvil
Project :	King's College London Kidderpore (Old) House
Date : 13/10/2014	Scale : 1:50@A1
Description :	Floor Plan - Ground Floor
Drawing Number :	MSL9992-OH-FPG-RevB

© Copyright 2014 MURPHY SURVEYS LTD