


SOFTWARES KEY

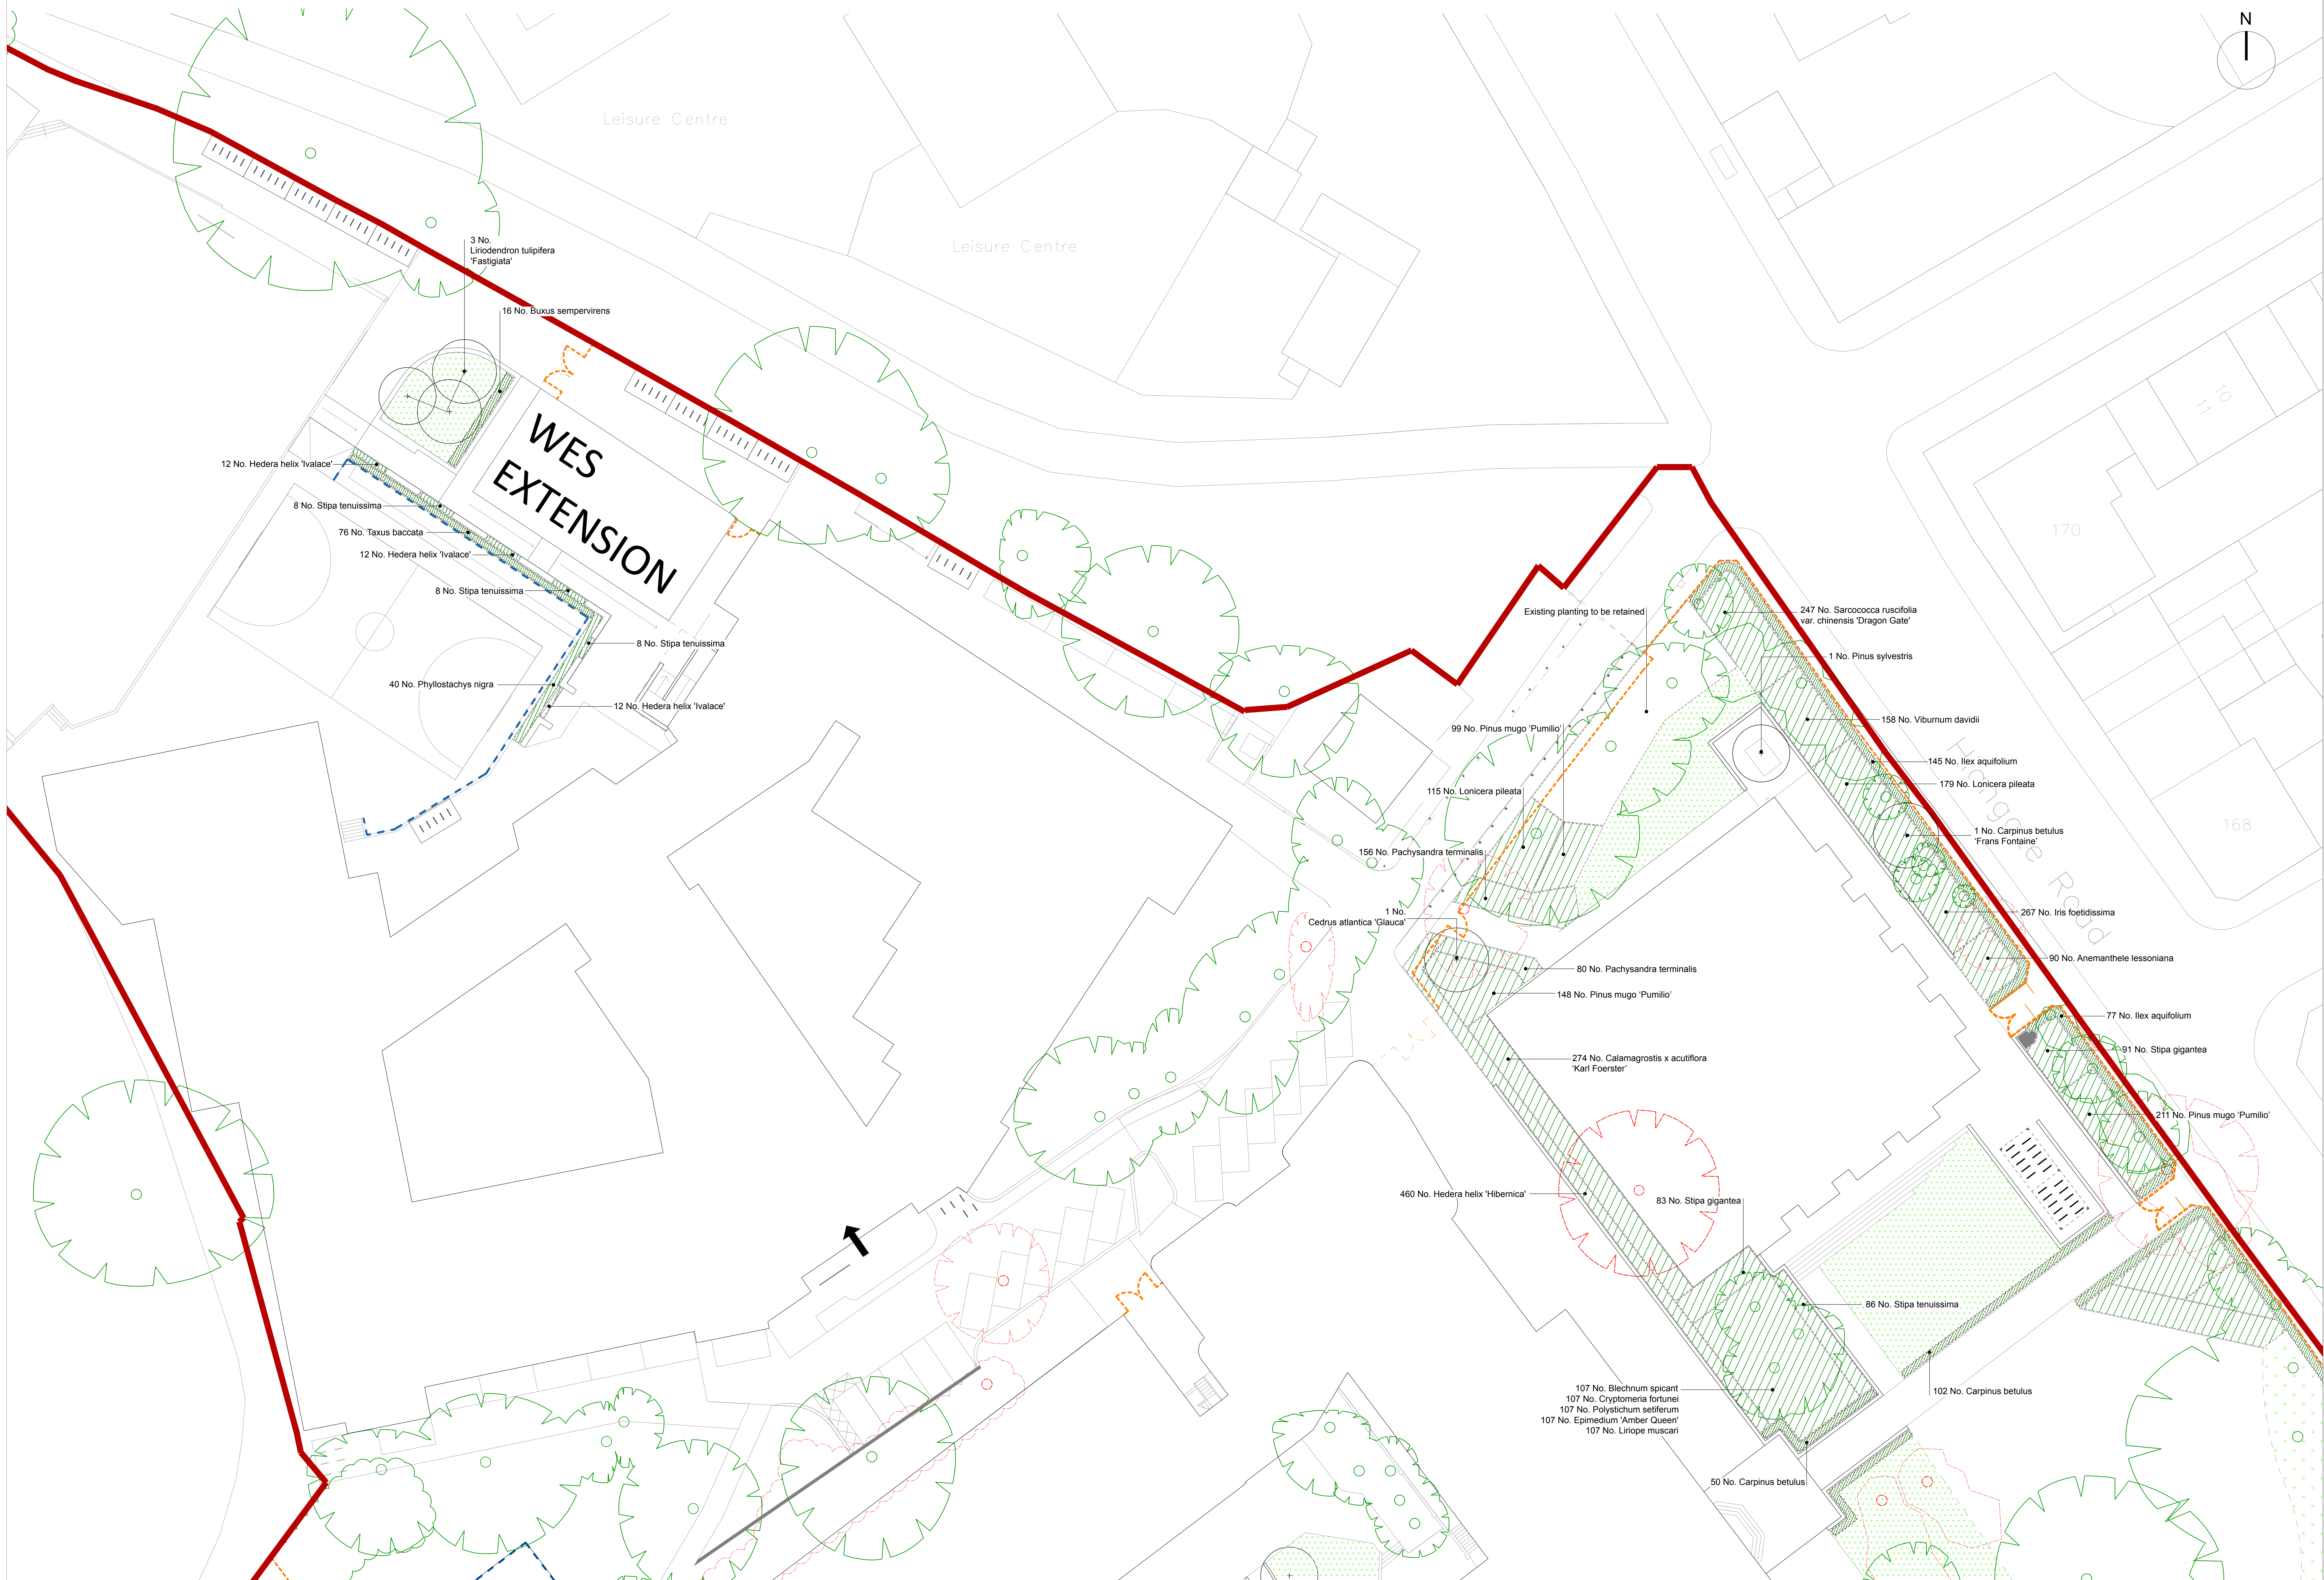

Revisions		
Rev	Date	Description
A	2018.10.12	General amendments
B	2018.11.23	Status changed to As Built
C	2018.11.26	Title block project changed to WES EXTENSION
D	2019.02.20	Quercus ilex changed to Pinus sylvestris. Addition of 1 No. Carpinus betulus 'Frans Fontaine', Cedrus atlantica 'Glauca' repositioned 1m further from building.

Notes	

49 Canonbie Road, London SE23 3AQ
07971 699 601 info@me-landscape.com

ME
ME Landscape Studio

Project	WES EXTENSION	Client	Farrans Construction
Drawing	Landscape Softworks_Sheet 1	Status	As Built
Project No.	0128	Drawing no.	0201
Scale	1:200 @A0	Date	04.12.2017
Drawn	EL	Checked	ML
Rev	D		