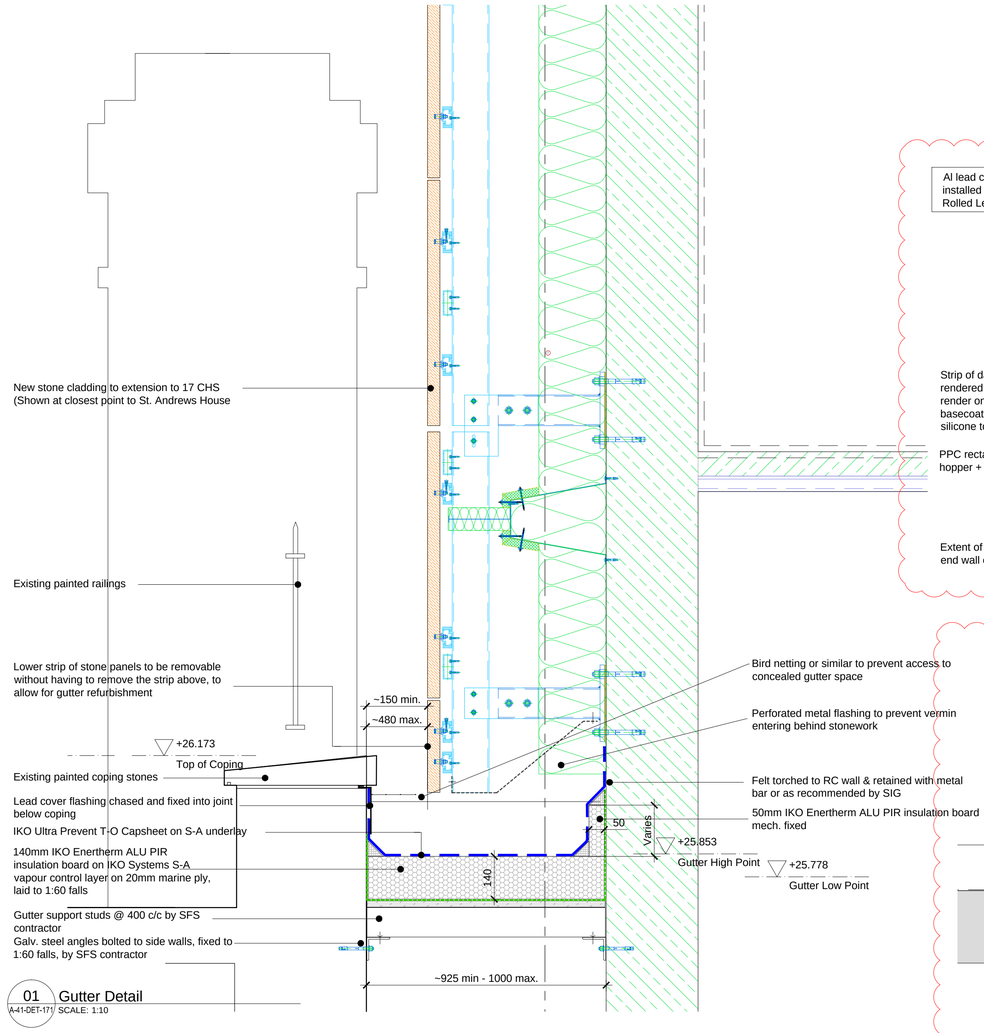

01 Gutter Detail
A-41-DET-171 SCALE: 1:10

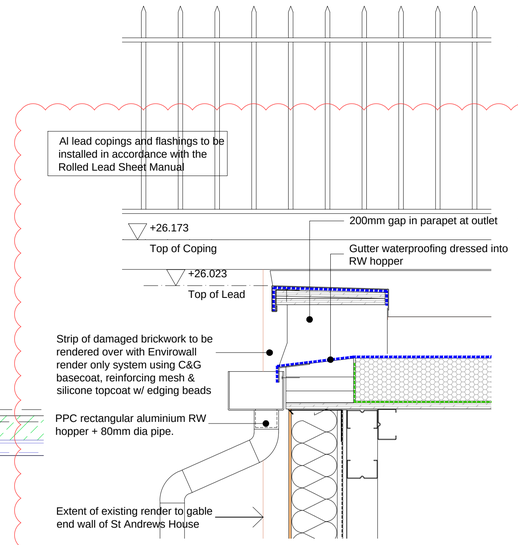

02 Gutter Detail at Hopper Outlet
A-41-DET-171 SCALE: 1:10

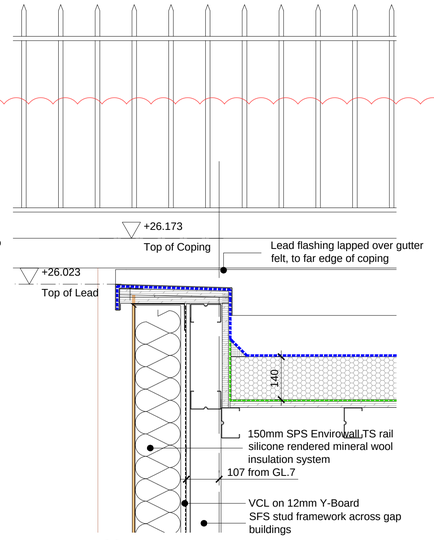

03 Gutter Detail
A-41-DET-171 SCALE: 1:10

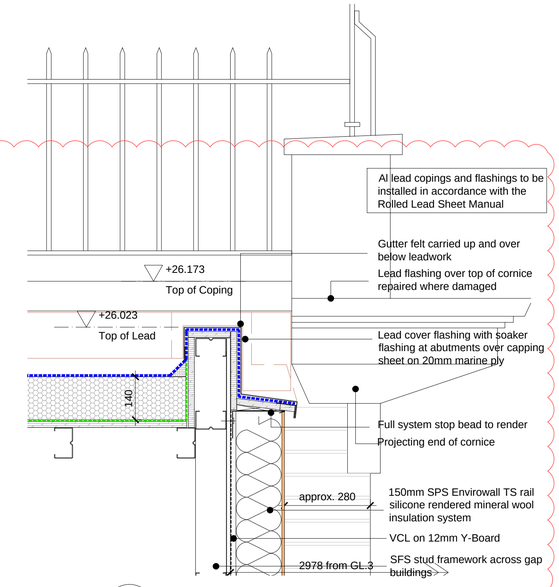

04 Gutter Detail
A-41-DET-171 SCALE: 1:10

C4
Details updated

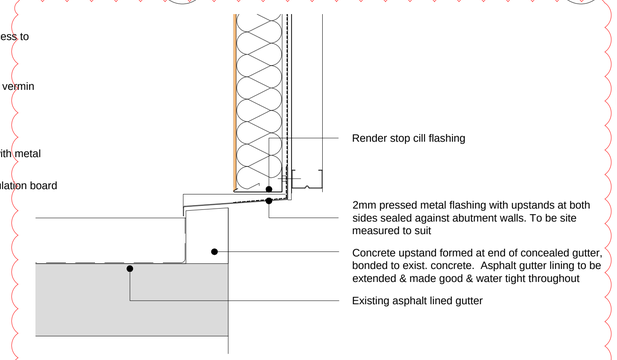

08 Junction w/ Exist Wall
A-41-DET-171 SCALE: 1:10

C3
Detail added

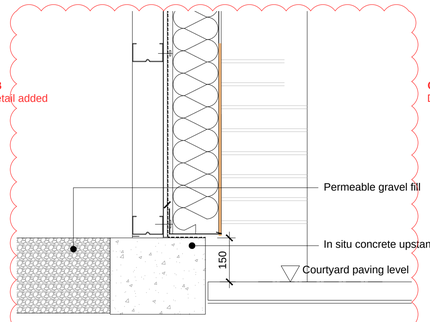

09 Junction w/ Courtyard Paving
A-41-DET-171 SCALE: 1:10

C4
Detail added

C3
Detail added

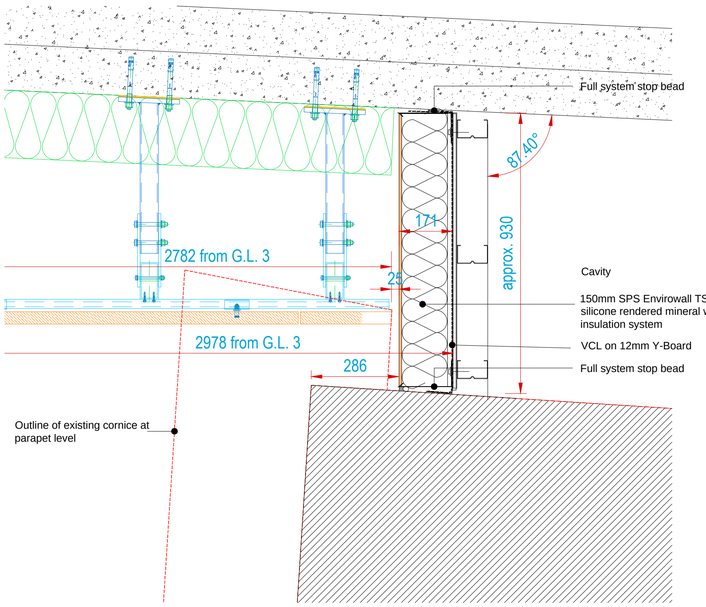

05 Wall Detail
A-41-DET-171 SCALE: 1:10

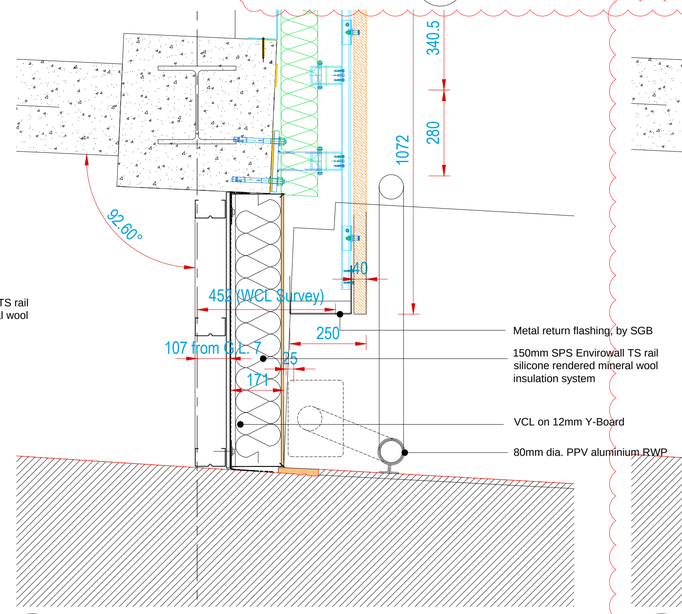

06 Wall Detail (Levels 1-3)
A-41-DET-171 SCALE: 1:10

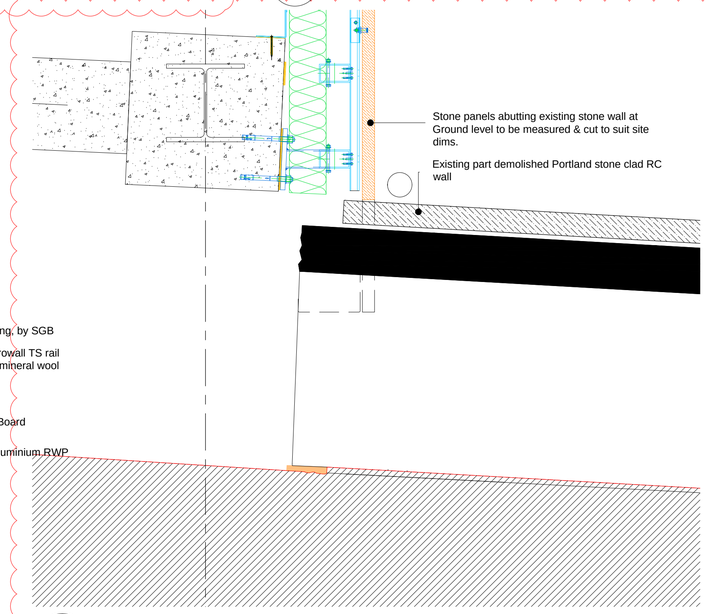

07 Wall Detail (Level G)
A-41-DET-171 SCALE: 1:10

Key Plan 1:2000

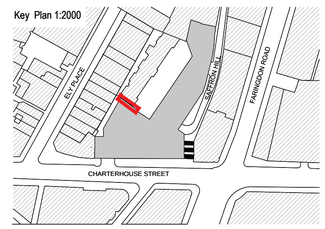

REV	DATE	PURPOSE OF ISSUE	BY
C4	01.05.19	DETAIL ADDED, DETAILS UPDATED	SR
C3	18.04.19	New details added	SR
C2	28.03.19	Construction Issue	SR

CLIENT: AA/DB
PROJECT: 17 CHARTERHOUSE ST. LONDON
DRAWING: GAP TO ST. ANDREWS HOUSE

SCALE: A1 @ XX
CAD FILE: A-41-DET-170, 171.dwg
DRAWN: MD
CHECKED: SR

STATUS:
- ☐ PRELIMINARY
- ☐ TENDER
- ■ CONSTRUCTION
- ☐ AS BUILT

DRAWING NO.: P17-082 (proj.) A (bld.) 41 (series.) DET (floor/type) 171 (no.) C4 (rev.)

MCM Architecture Limited T 020 7902 0900 F 020 7922 1233
71 Hopton Street London SE1 9LR www.mcm-uk.com