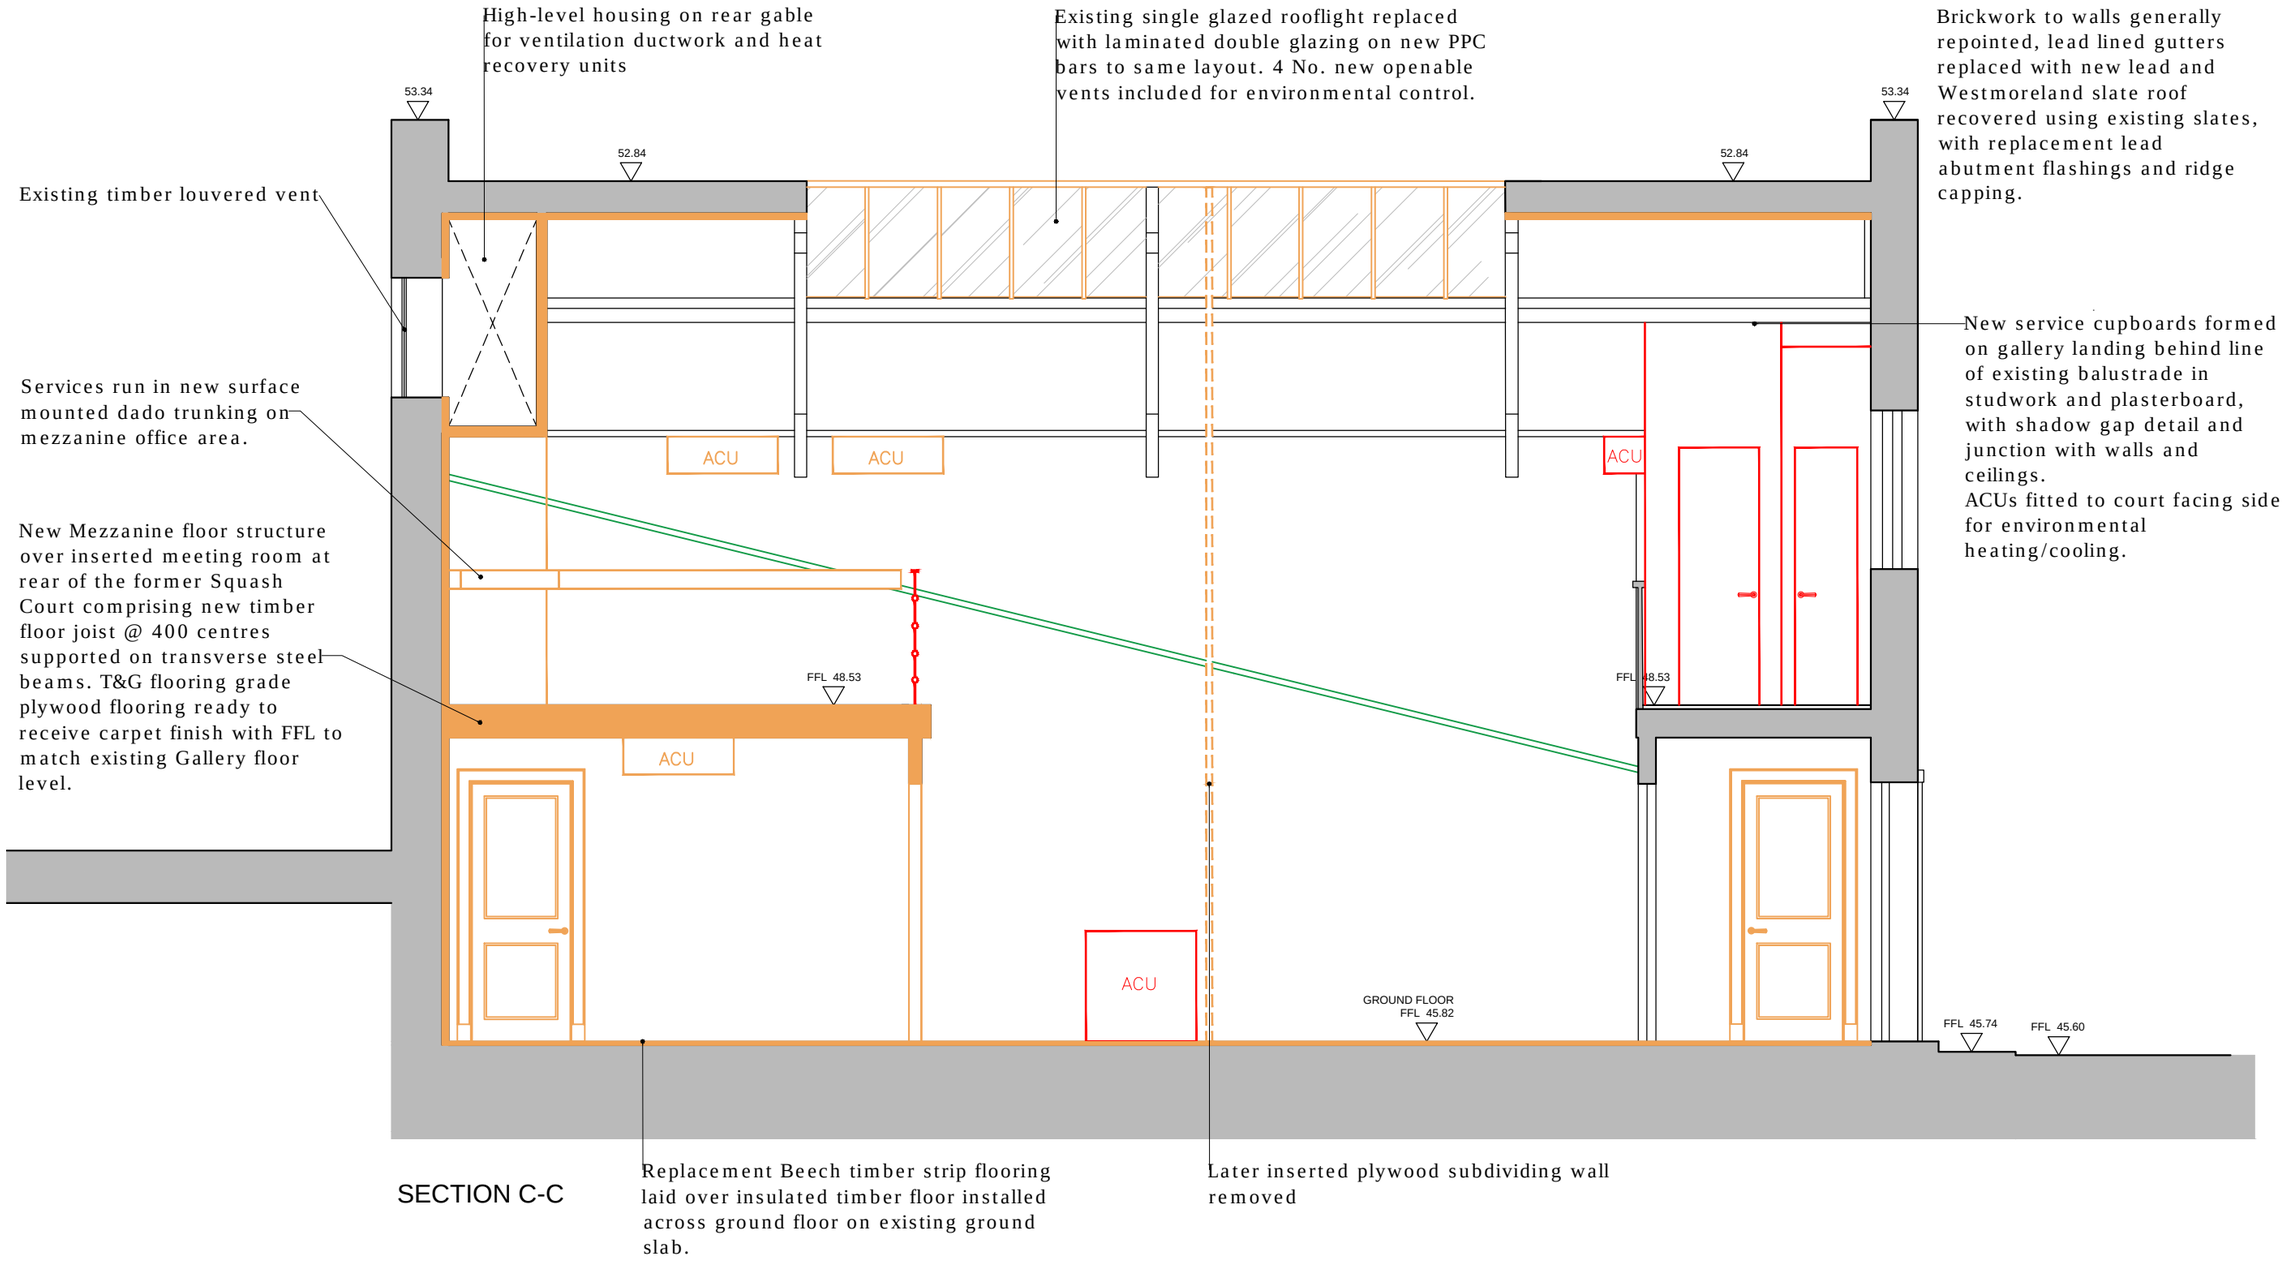

SECTION C-C

KEY

- EXISTING
- RETROSPECTIVE WORKS
- PROPOSED WORKS

0 1M 2M 3M 4M 5M

Rev	Date	Description	By
A	Sep 19	Amended Scheme	GT/VS

Client
HANLEY LIMITED

scott&twine
ARCHITECTS & INTERIOR DESIGNERS
The Old Power Station, Mortlake High Street
London SW14 8SN
T +44 (0) 20 3355 9699
www.scott-twine.co.uk

Issue
PLANNING
Preliminary / Planning / LBC / Tender / Construction / As Built

Project
Beechwood, London N6
Conversion of Former Squash Court

Title
Section C-C
As Proposed

Date	Scale
July 2017	1:50@A3
Drawn By: GT	Checked By: VS
Drawing Number: 2230-06/01/06	Revision: A

© Scott & Twine LLP 2013