

Materials Key:

1. White glazed brick - Flemish bond
2. White matt brick - Flemish bond
3. Casement windows, Aluminium
4. Dormer door to terrace
5. Roof tiles
6. Brick party wall chimney stack
7. Glass raised balustrade
8. Plant enclosure - louvered timber panels



**NOTE:**  
 Areas shown in GREEN - forms part of new planning application for HVAC.  
 Areas shown in BLUE - forms part of current planning application PP-08035286.

**01 Proposed Rear Elevations**  
 1:100 @ A3

Do not scale.  
 Use figured dimensions only.  
 All dimensions to be checked on site.

All drawings to be read in conjunction with other consultants' information: any discrepancies to be reported before work commences.

Rev	Date	Description	Drawn	Checked
G	19/12/2019	For Planning Approval	TMA	BHE
F	13/12/2019	Gridlines & plant enclosure added	TMA	BHE
E	01/11/2019	For Tender	TMA	BHE
D	29/10/2019	For Planning Approval	TMA	BHE
C	24/10/2019	Co-ordinated with structural requirements/for client approval	TMA	BHE
B	26/07/2019	For Planning Approval	TMA	SKE
A	03/07/2019	For Client Approval	TMA	SKE

General notes


	Existing
	New elements/part wall to be added shown in BLUE
	In Abeyance
	Revision

Owen Architects

46 Britton Street London EC1M 5UJ United Kingdom  
 t +44 (0)20 7608 2889  
 e office@owenarchitects.co.uk  
 w owenarchitects.co.uk



Status	For Planning Approval
Date	03/07/2019
Scale	1:100 @ A3

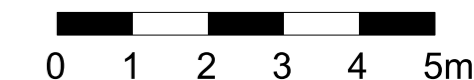

Project title		
14 & 15 Great James Street London WC1N 3DP		
Drawing title		
Proposed Rear Elevations		
Drawing No		
Project No	Drawing No	Rev
406	3101	G