


2 SECTION THROUGH ROOF
1: 100

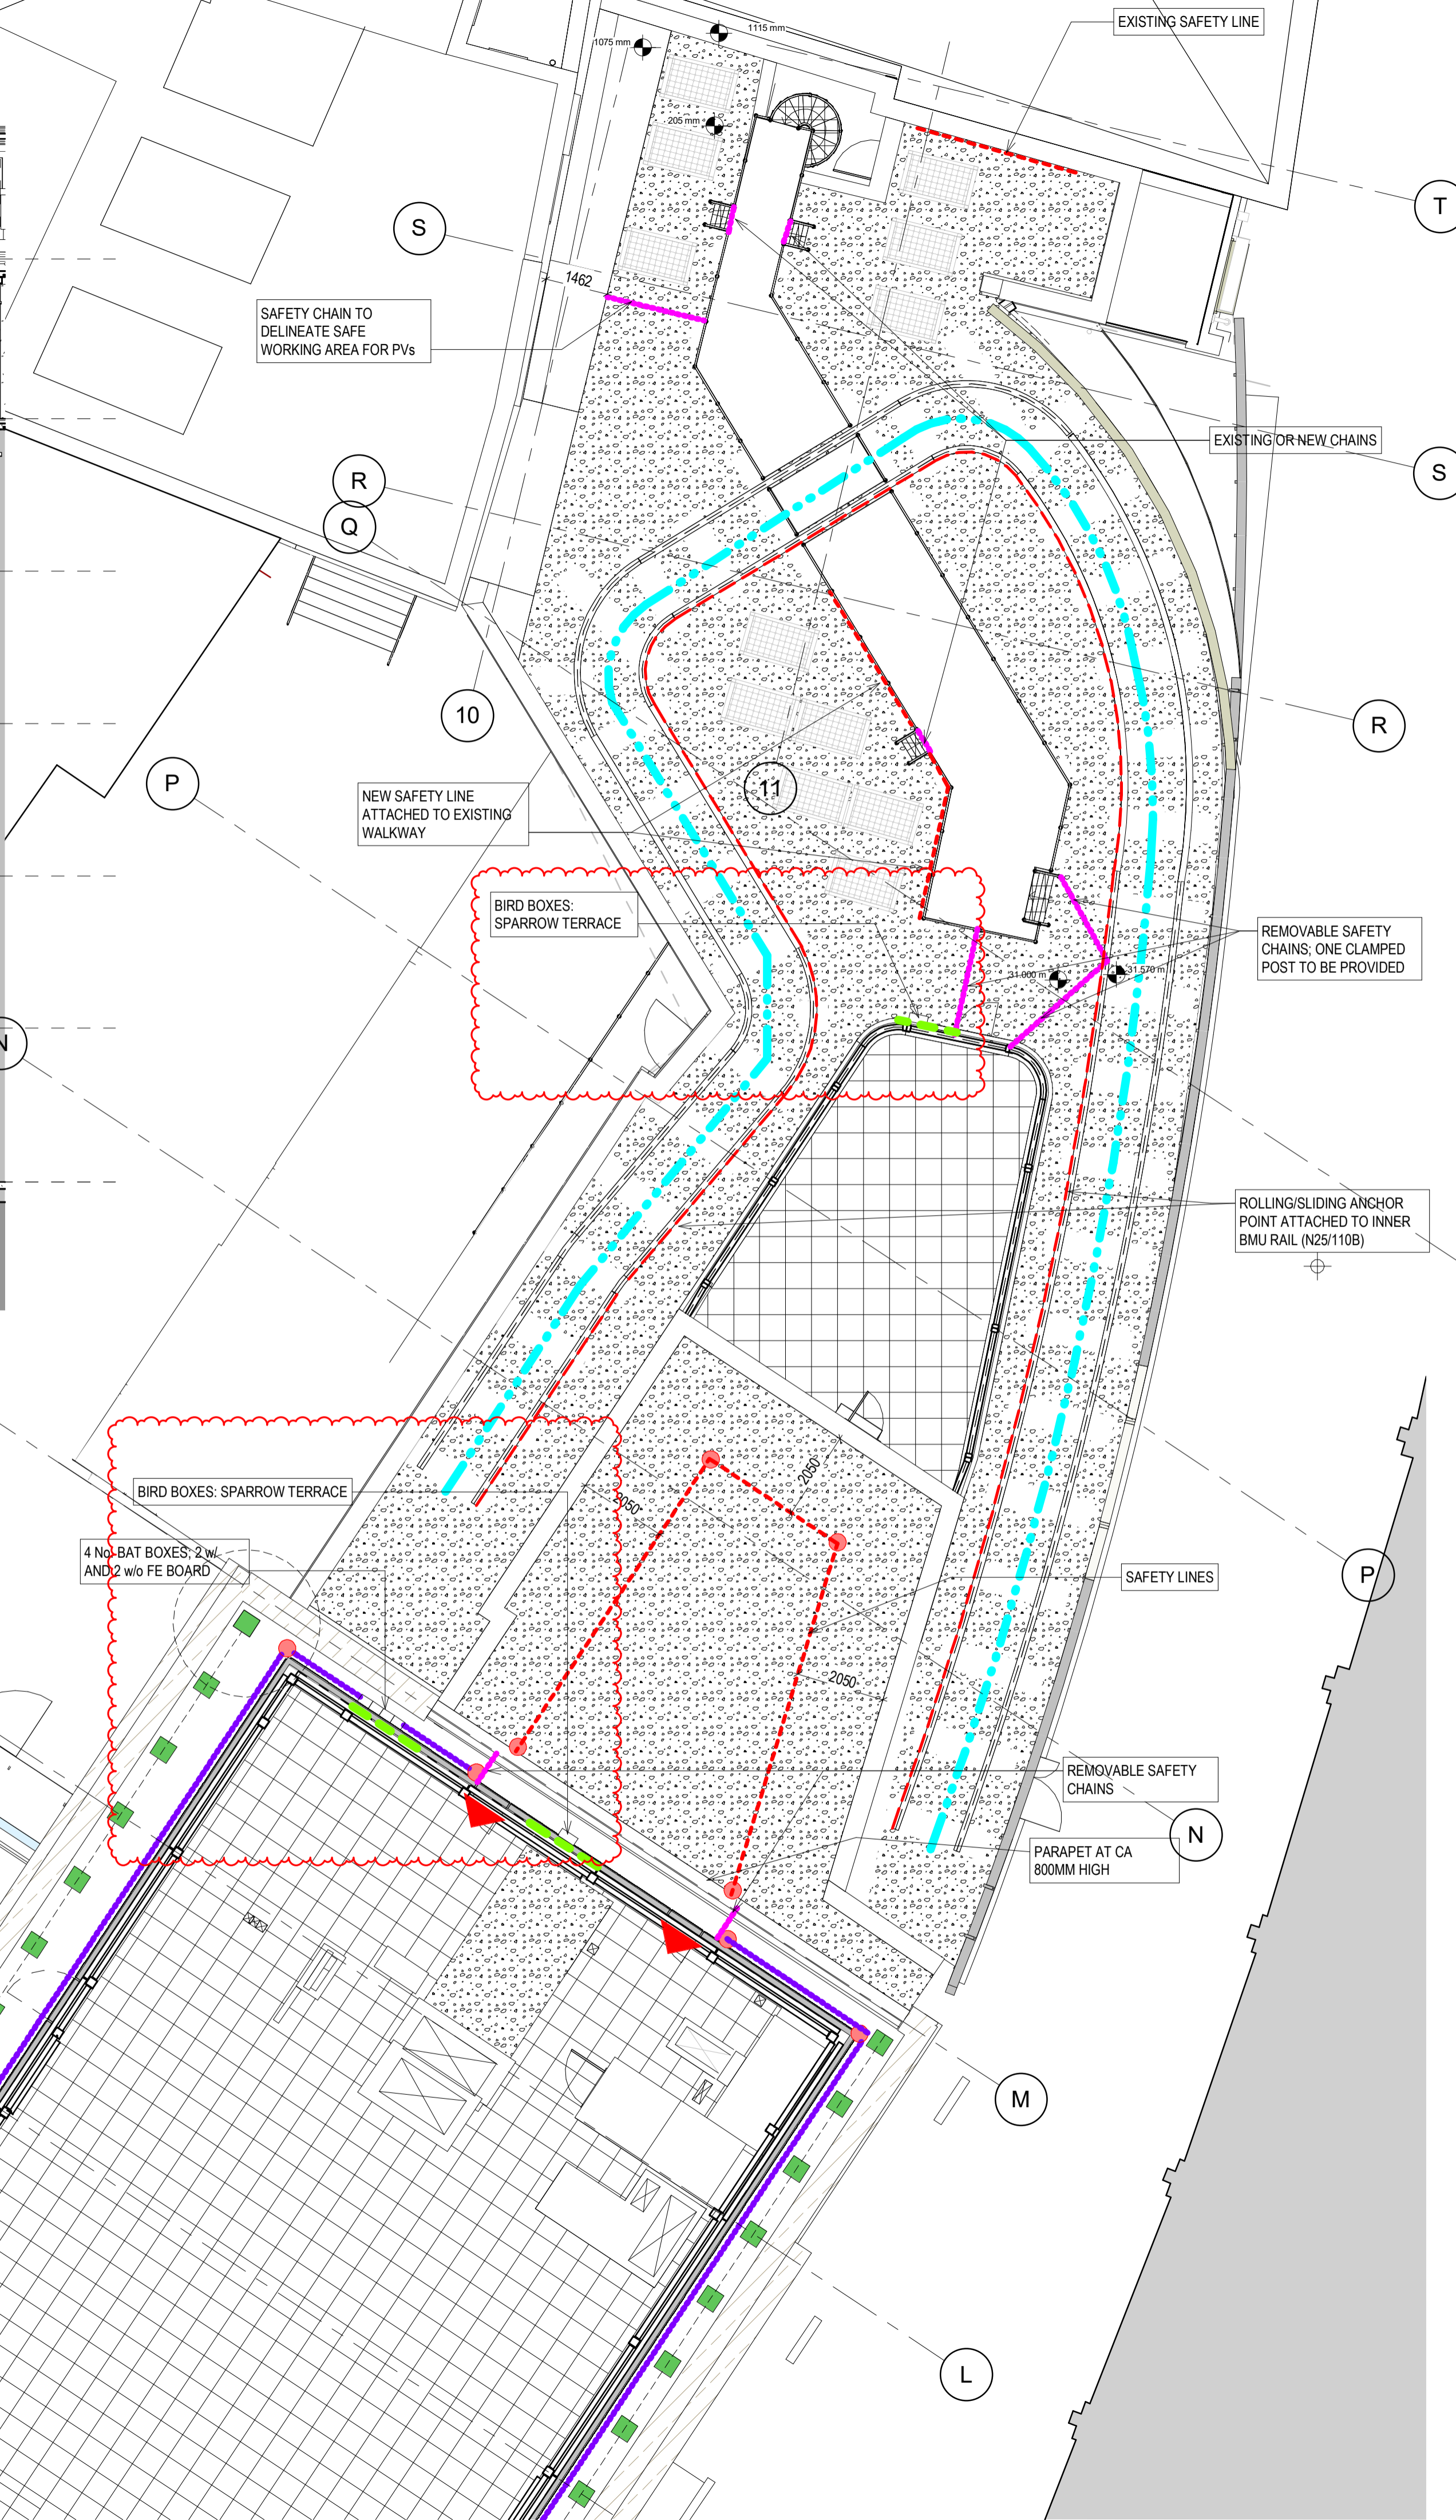

- SYMBOLS KEY**
- HANDRAIL REACHING 1100MM HEIGHT
 - REMOVABLE SAFETY CHAINS
 - - - FALL RESTRAINT SYSTEM (CFP ON FLOOR) 2050MM OFF SET FROM THE FALL HAZARD
 - - - FALL RESTRAINT SYSTEM (CFP ON WALLS) 2050MM OFF SET FROM THE FALL HAZARD
 - REACH OF FALL RESTRAIN SYSTEMS
 - OVERHEAD FALL ARREST SYSTEM (2M FROM FFL) 2050MM LENGTH OF LANYARD AND PERSONAL FALL LIMITER
 - - - FALL RESTRAINT SYSTEM (CFP UNDER BMU TRACKS OR AT FLOOR LEVEL TO BOTH SIDES OF WALKWAY, LENGTH OF BOTH LANYARDS TBC WITH ROOF FALL PROTECTION SUBCONTRACTOR
 - CONSTANT FORCE POST, NUMBER TBC WITH ROOF FALL PROTECTION SUBCONTRACTOR WHEN APPOINTED
 - ▲ ACCESS POINTS TO ROOF TBC
 - BOILER FLUE
 - - - BMU TRACK
 - DAVIT PLINTHS
 - WEATHER AND UV PROTECTION CABINET WITH MOUNTING BOARDS, CONTAINING TWO FULL HARNESSES
 - - - POTENTIAL LOCATION OF STEP OVERS, TBC WITH MEP SERVICES ENGINEER
 - GALVANIZED STEEL METAL LADDER
 - WATER POINT FOR FACADE CLEANING
 - SOCKETS FOR BMU
- NOTES:
- CLIENT INTENTION IS TO MAINTAIN CURRENT FACADE AND ROOF ACCESS STRATEGY. THIS IS TO BE CONFIRMED WITH THE CDM COORDINATOR
- - - BIRD/BAT BOX LOCATION

DO NOT SCALE ANY DIMENSIONS OFF THIS DRAWING. ANY DISCREPANCIES BETWEEN THIS DRAWING AND OTHER INFORMATION ARE TO BE REFERRED TO MCM ARCHITECTURE LIMITED. WHERE THE DRAWING RELATES TO AN EXISTING BUILDING OR COMPLETED CONSTRUCTION THE CONTRACTOR IS RESPONSIBLE FOR CHECKING THAT THERE IS NO CONFLICT BETWEEN ACTUAL BUILDING DIMENSIONS AND DRAWING DIMENSIONS. IN THE EVENT OF DISCREPANCIES BETWEEN THIS DRAWING AND SUBCONTRACTORS APPROVED WORKING DRAWINGS FOR RELEVANT BUILDING COMPONENTS, THE SUBCONTRACTORS DRAWINGS SHALL TAKE PRECEDENCE. ANY CONFLICTS ARISING OUT OF INFORMATION AS NOTED ABOVE MUST BE REPORTED IMMEDIATELY TO MCM ARCHITECTURE LIMITED. THIS DRAWING IS THE COPYRIGHT OF MCM ARCHITECTURE LIMITED. ALL DIMENSIONS ARE IN MILLIMETRES UNLESS OTHERWISE STATED.

CDM REGULATION			
HAZARDS	DATE ADDED	DATE MITIGATED	RISK ASSESSMENT DATE
P3	10.12.19	FOR PLANNING	SP
P2	06.11.19	ISSUED FOR PLANNING	SP
C2	30.10.19	CONSTRUCTION ISSUE	SP
P1	09.09.19	ISSUED FOR PLANNING	SP
C1	18.01.19	CONSTRUCTION ISSUE	SP
T4	14.11.18	STRUCTURE & BID-BOX LOCATION ADDED TO DRAWING	SP
T3	26.04.18	STAGE 4 ENVELOPE UPDATE	LS
T2	27.03.18	STAGE 4 ENVELOPE UPDATE	DM
T1	05.03.18	STAGE 4 ENVELOPE UPDATE	SP
REV	DATE	PURPOSE OF ISSUE	

CLIENT AA & DB
PROJECT 17 CHARTERHOUSE ST.
DRAWING SAFFRON HILL EXTENSION ROOF

SCALE: 1:100 @A1
1:200 @A3
DRAWN LS
CHECKED SP

STATUS: PRELIMINARY
 TENDER
 CONSTRUCTION
 AS BUILT

DRAWING NO. P17-082 A-27-07-02 P3

MCM.
MCM Architecture Limited
71 Hopton Street London SE1 9LR
T 020 7902 0900
www.mcm-uk.com