SHOPFRONT VISUAL

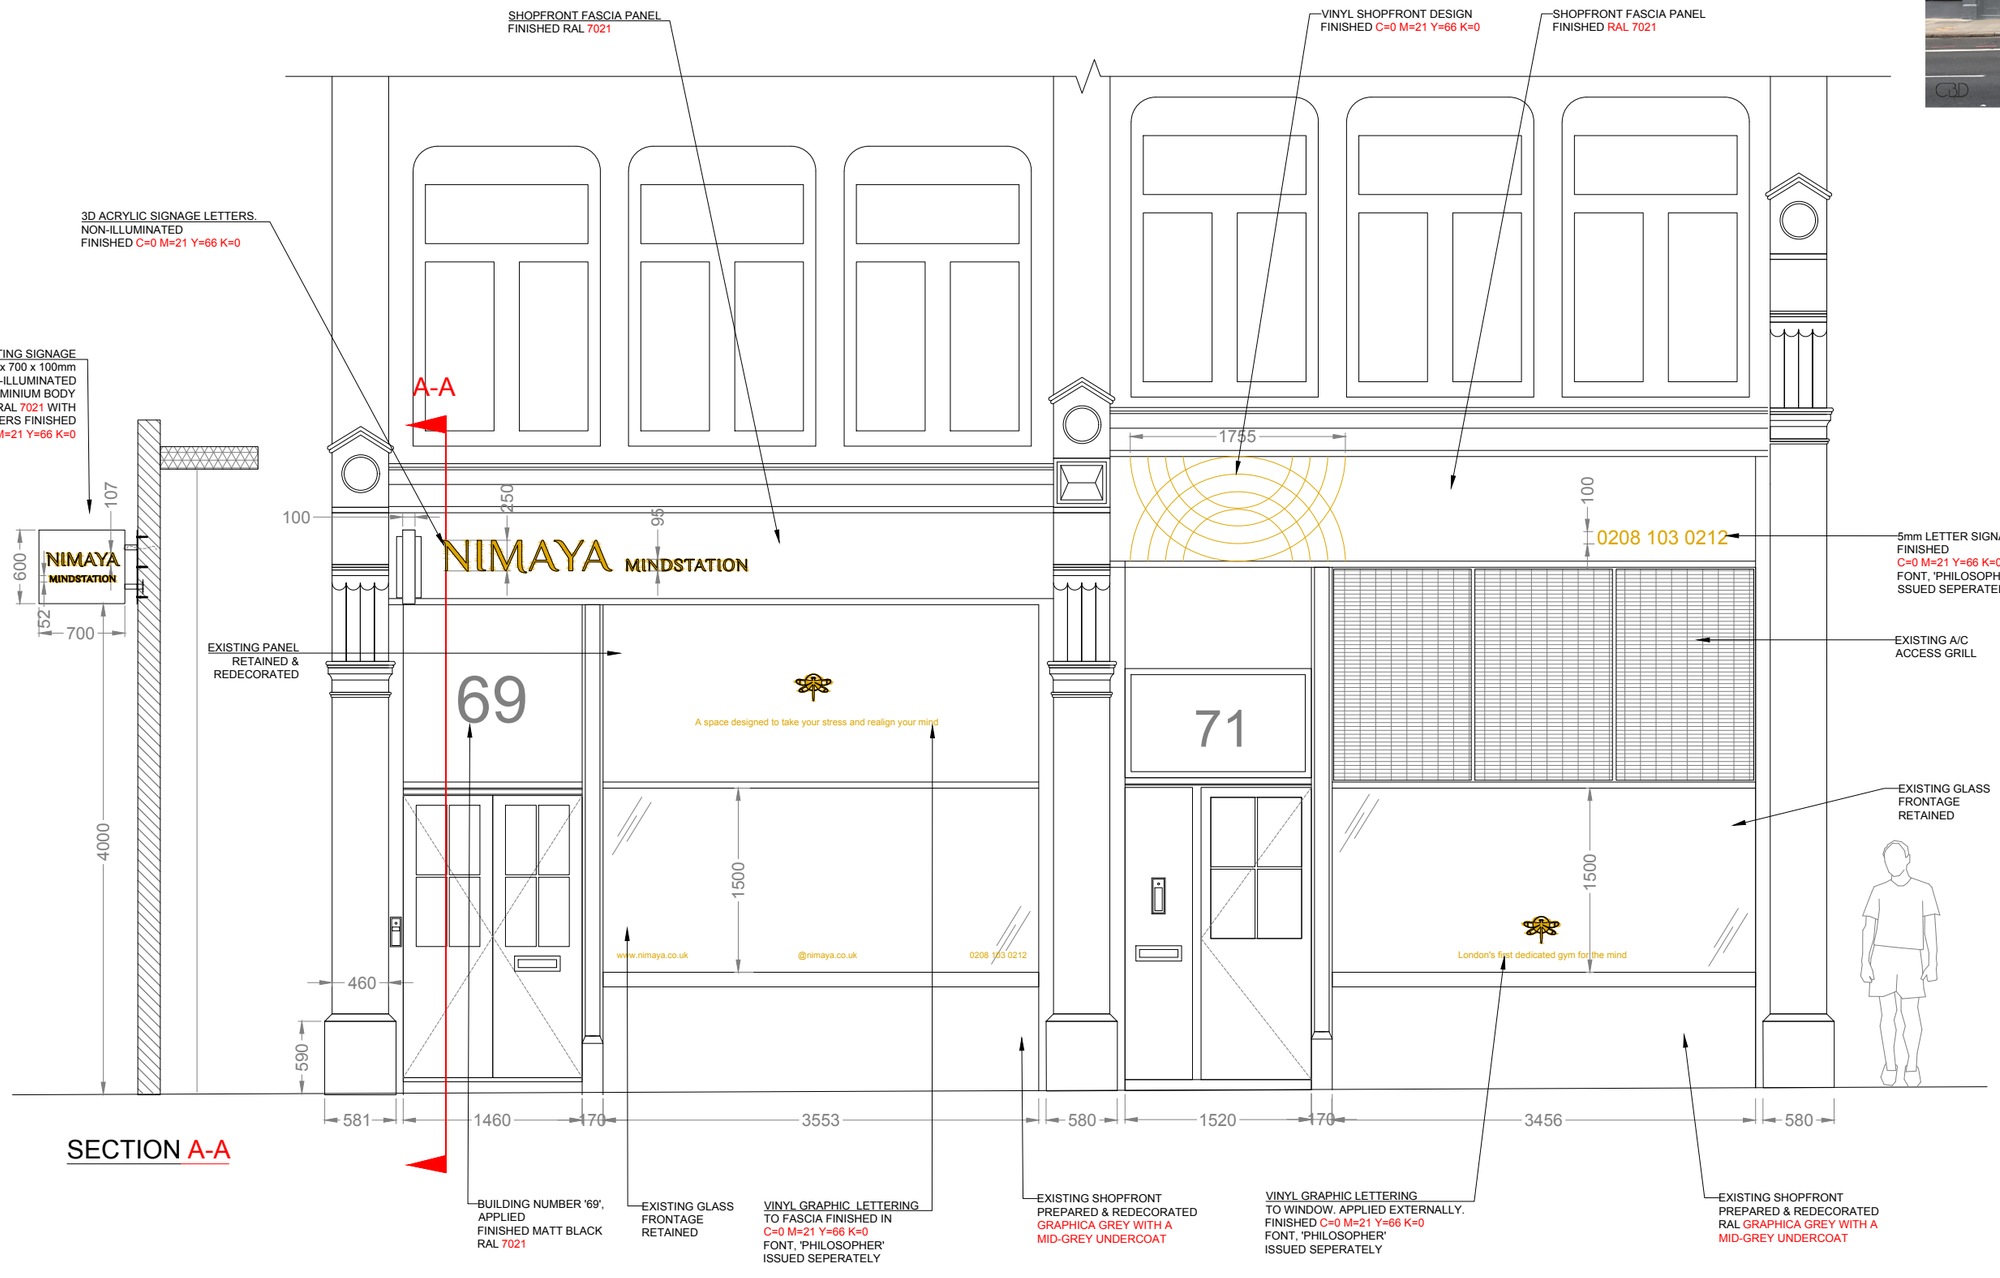

SHOPFRONT

Scale bar

0 — 1 mts — 5 mts — 10 mts

REV	DESCRIPTION	DATE
A	Signage change	04.02.20

CBD DESIGN

Chris Bromfield Design

T: 0787 205 1022
E: chris@chrisbromfielddesign.co.uk
W: www.chrisbromfielddesign.co.uk

Interior Architect | Retail Design | Fitness & Wellness

Project: Nimaya
69-71
Farringdon Road
London EC1

As Built
Shopfront Plan

Scale: 1:50@A3 Date: 06.12.19
Drawn: CB

IMPORTANT
This drawing is the property of Chris Bromfield Design and is not to be copied, reproduced, retained or disclosed to any unauthorised person either wholly or in part without prior consent.
Do not scale from this drawing. Use all figured dimensions only.
All figured dimensions to be checked on site prior to construction. All discrepancies, errors and omissions to be reported to CBD/the architect prior to construction. Layout and dimensions of existing building to be checked on site. If in doubt ask

DWG NO: 07 / A