GENERAL NOTES

1. THIS DRAWING IS CONFIDENTIAL AND IS THE EXCLUSIVE PROPERTY OF FULKERS . NO UNAUTHORISED USE, COPY OR DISCLOSURE IS TO BE MADE, AND IS TO BE RETURNED UPON REQUEST.
2. CONSTRUCTION TO COMPLY FULLY WITH BS EN 12811-1 USING NASC TECHNICAL GUIDANCE TG20:13.
3. SCAFFOLD ERECTION AND DISMANTLING TO CONFORM WITH SG 4 : 15
4. SCAFFOLD BUILT FROM TUBULAR MATERIALS CONFORMING TO BS 1139 OR TYPE 4 TUBE TO BS EN 39. ALL TUBE TO BE IN 'AS NEW' CONDITION.
5. FITTINGS TO COMPLY WITH BS 1139 OR BS EN 74 CLASS A OR CLASS B.
6. SCAFFOLD BOARDS TO COMPLY WITH BS2482 : 2009 (38MM X 225MM).
7. THIS DRAWING HAS BEEN PREPARED FROM DETAILS SUPPLIED BY THE CLIENT, WHO SHOULD CHECK THAT WE HAVE CORRECTLY INTERPRETED THEIR REQUIREMENTS. THE CLIENT SHOULD CHECK THAT ALL LOADINGS, DIMENSIONS, DETAILS, ERECTION AND DISMANTLING SEQUENCES ARE CORRECT AND PRACTICABLE. NO ALTERATION OF LIVE LOAD MAY BE MADE WITHOUT PRIOR WRITTEN CONSENT.
8. ALL STANDARDS TO BE BASED ON MILD STEEL BASE PLATES AND 38MM SOLE BOARDS UNLESS STATED OTHERWISE.
9. NO SHEETING, SIGNBOARDS OR HOARDINGS, UNLESS ALREADY SHOWN, SHOULD BE ADDED TO THE SCAFFOLD WITHOUT PRIOR WRITTEN CONSENT.
10. IT IS THE RESPONSIBILITY OF THE CLIENT TO ENSURE THAT ADEQUATE FACILITIES FOR TYING THE SCAFFOLD ARE MADE AVAILABLE AND THAT THE BUILDING OR STRUCTURE IS CAPABLE OF WITHSTANDING THE LOADS APPLIED TO IT BY THE SCAFFOLD.
11. NO TIES OR BRACES ARE TO BE REMOVED OR ANY MODIFICATION TO BE MADE TO THE SCAFFOLD WITHOUT PRIOR WRITTEN CONSENT.
12. THE CLIENT MUST ENSURE THAT ALL LOADINGS ARE SUFFICIENT, THAT THE STATED LIVE LOADS ARE NOT EXCEEDED AND ENSURE FOUNDATIONS AND/OR SUPPORTS ARE CAPABLE OF SUPPORTING THE LOADS IMPOSED UPON THEM BY THE SCAFFOLD.
13. ALL DIMENSIONS ARE AS STATED OR AS CALCULATED. WRITTEN DIMENSIONS SHALL TAKE PRECEDENCE OVER SCALED DIMENSIONS. DIMENSIONS IN MM UNLESS STATED OTHERWISE.
14. THIS DRAWING HAS BEEN PREPARED ON THE ASSUMPTION THAT ALL LOADS WILL BE APPLIED AXIALLY TO THE TUBES UNLESS SPECIFICALLY STATED.

DIM — DENOTES DIMENSIONS BETWEEN CENTRES OF STANDARDS/TUBES

DIM* — DENOTES CLEARANCE/SET-OUT DIMENSIONS

IDENTIFICATION OF RESIDUAL HAZARDS

⚠ A1 — THIS SYMBOL DENOTES WHERE RESIDUAL HAZARDS REMAIN ON THE SCAFFOLD. SYMBOL CODE (ie. A1, B3, C3 etc.) DENOTES THE RISK ASSESSMENT REFERENCE NUMBER

DESIGN ORGANISATION
48.3

DESIGN CHECK ORGANISATION
TBC.

THE FOLLOWING DESIGN CHECK CATEGORY HAS BEEN ASSIGNED BY THE TEMPORARY WORKS CO-ORDINATOR (TWC) IN ACCORDANCE WITH BS 5975:2008 + A1:2011

TBC — CATEGORY UNASSIGNED BY TWC AT THE TIME OF DESIGN. SUGGESTED CHECK CATEGORY BY 48.3: **TBC.** TO BE CONFIRMED BY TWC.

ERECTION TOLERANCES

ALLOWABLE VERTICAL AND HORIZONTAL TOLERANCES IN ANY GIVEN BAY.	
LIFT HEIGHT	VERTICAL TO WITHIN ± **100**mm IN **2000**mm
BAY LENGTH	HORIZONTAL TO WITHIN ± **200**mm
NODE	150mm BETWEEN COUPLER CENTRES
BRACING	300mm FROM NODE

SCAFFOLD ERECTION PERIOD

ALL DRAWINGS ISSUED ARE VALID ONLY FOR THE ERECTION PERIOD STATED. FOR USE OF THE SCAFFOLD BEYOND THE ERECTION PERIOD WRITTEN CONFIRMATION MUST BE OBTAINED FROM 48.3 SCAFFOLD DESIGN.

MONTH OF ERECTION	TBC.
ERECTION PERIOD	TBC.

IMPOSED AND PERMITTED LOADS

THE CLIENT MUST ENSURE THAT STATED LOADINGS ARE SUFFICIENT FOR INTENDED USE, THAT LIVE LOADS SPECIFIED ARE NOT EXCEEDED AND THAT FOUNDATIONS AND OR SUPPORT ARE SUITABLE FOR RESISTING STATED LOADS.

LOAD CLASS / DESIGNATION	TBC.
MAXIMUM UDL (MAIN PLATFORM)	TBC. kN/m²
MAXIMUM UDL (INSIDE BOARDS)	TBC. kN/m²
LOADED PLATFORMS	TBC.
WIND LOAD (qs)	TBC. kN/m²
SNOW LOAD	TBC. kN/m²
MAXIMUM AXIAL LOAD IN STD.	TBC. kN
NUMBER OF TIES	TBC.
MAXIMUM TIE LOAD	TBC. kN
TIE TEST LOAD (1.25:1 F.O.S.)	TBC. kN

REV	DATE	DESCRIPTION	STATUS	DRN	CHKD
00	03/01/20	DRAWINGS ISSUED FOR COMMENT	C	HT	MG

483
DRIVING THE EVOLUTION OF SCAFFOLDING

CLIENT
FulkersBaileyRussell

PROJECT
ACCESS SCAFFOLD WITH TEMPORARY ROOF

SITE
THE SLADE SCHOOL OF ARTS, UCL

DRG. TITLE
SECTION B-B WITH SECTION C-C & SECTION D-D

STATUS
FOR COMMENT

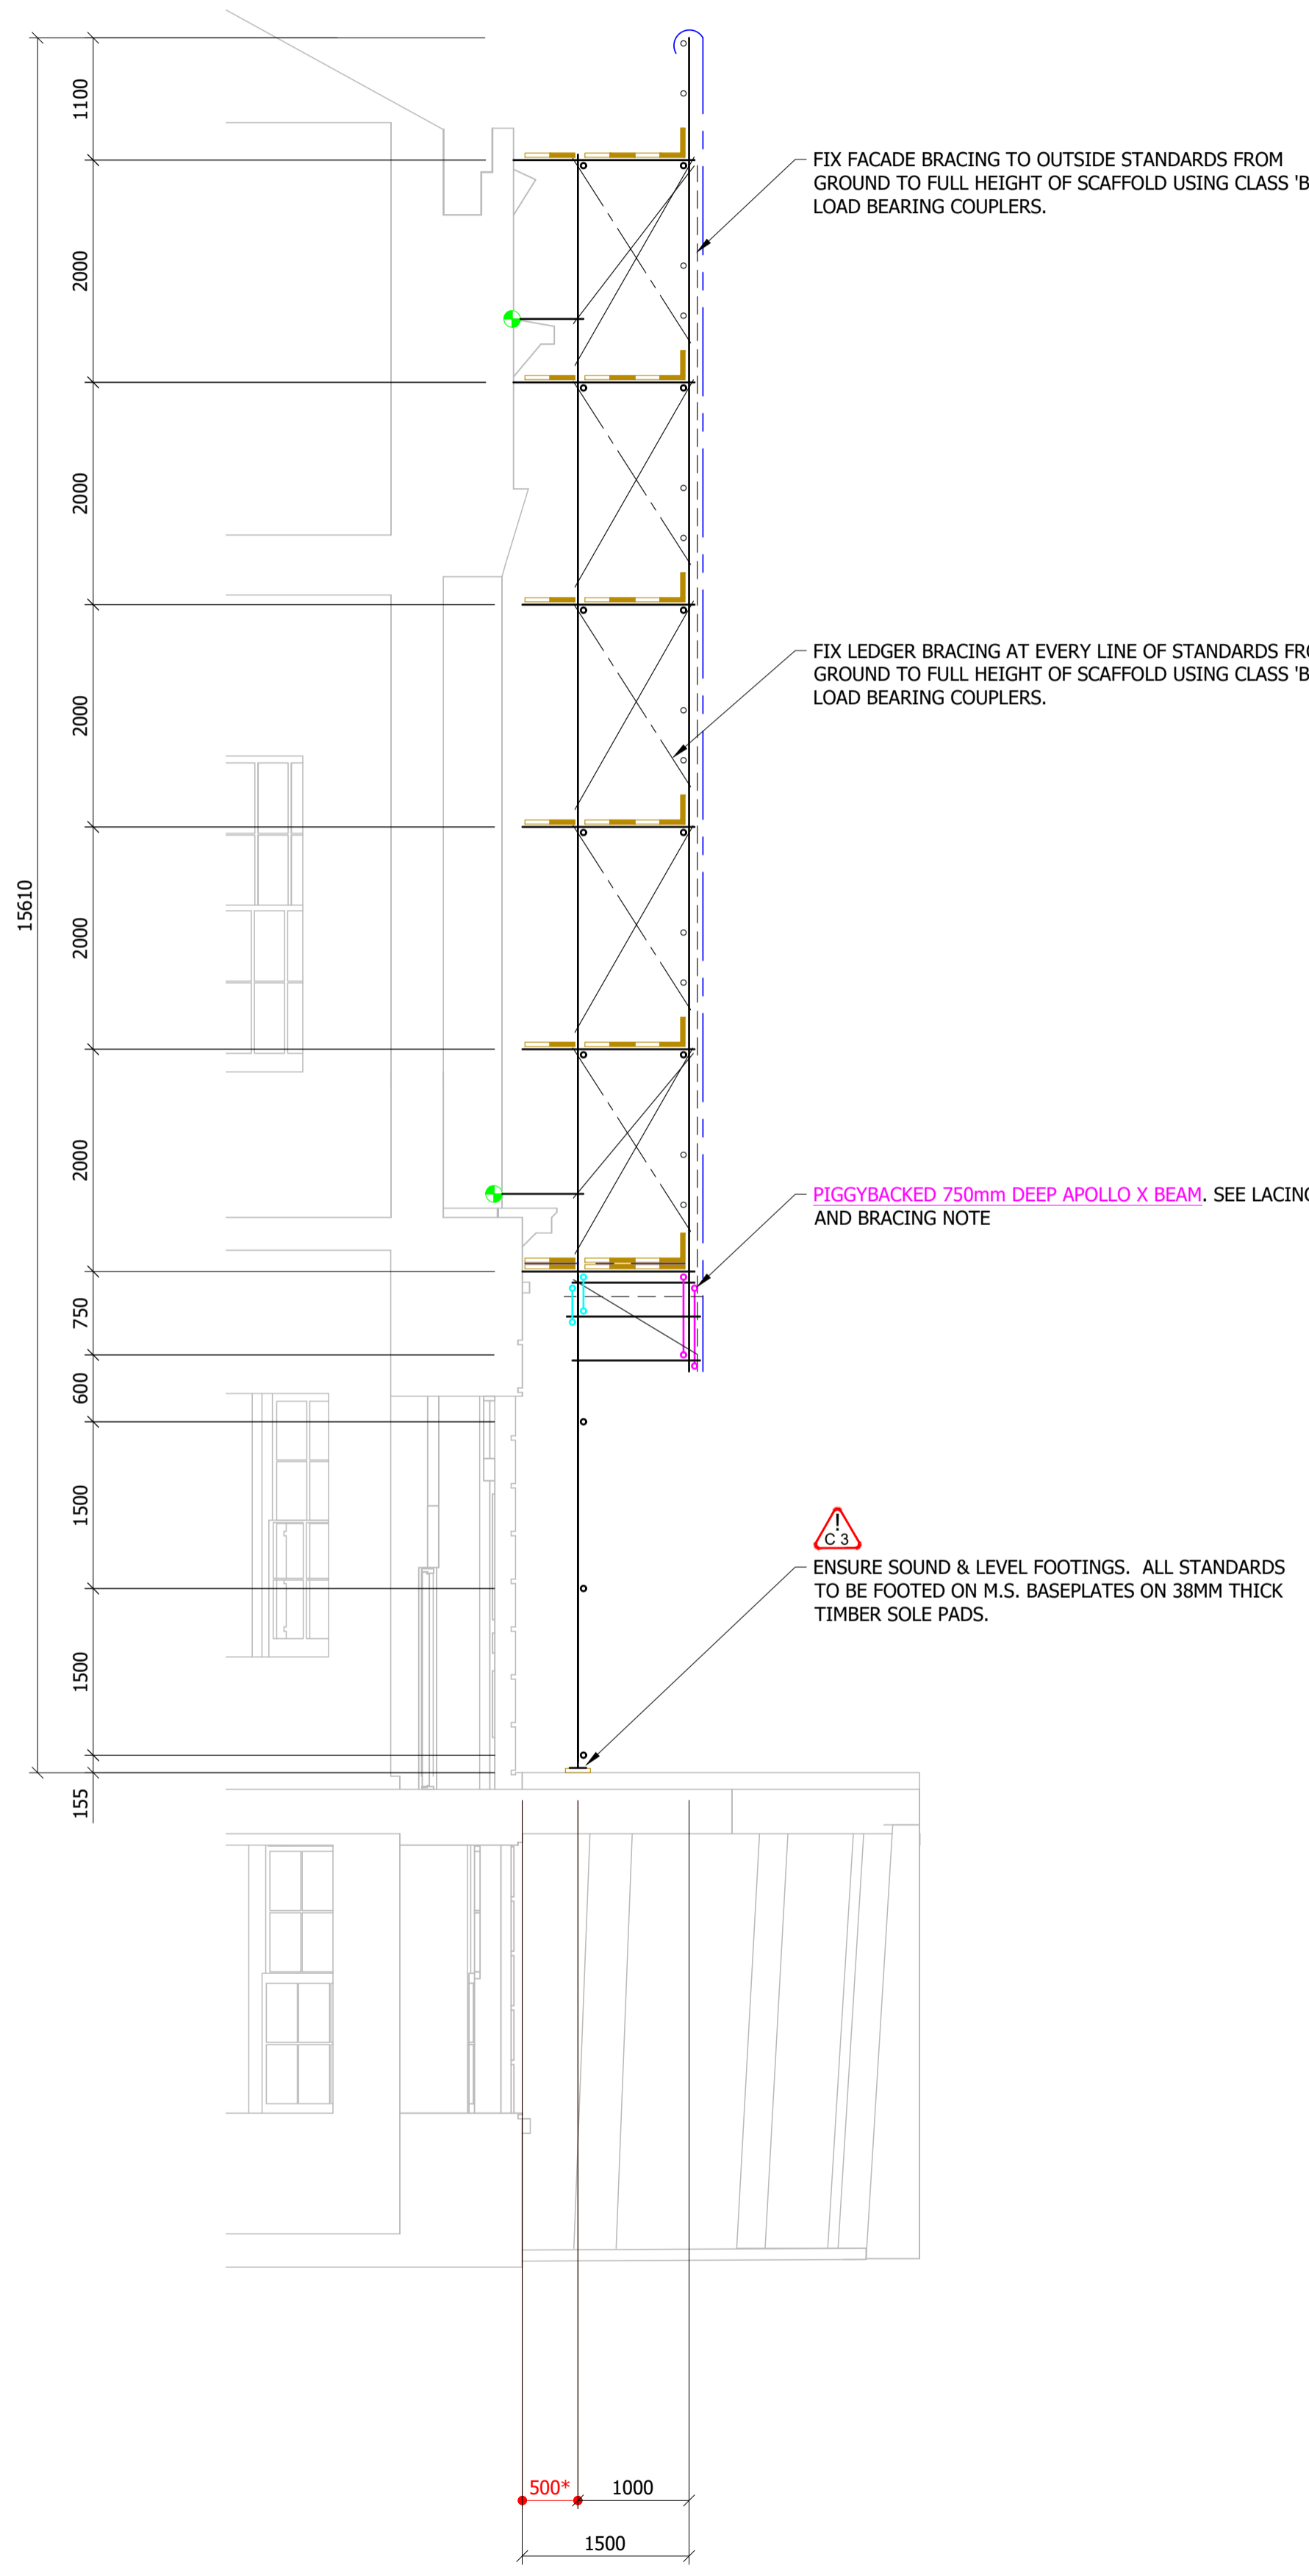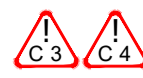|			
CLIENT CODE	FKR	DRAWN	HT
PROJECT NO.	3988	CHECKED	MG
CONTRACT	01	ORIGINAL	A1
DATE	03/03/2020	SHEET NO.	4 OF 8

DRG. NO. — FKR-3988-01-DR-04 — REV. 00

750mm DEEP APOLLO X BEAM LACING AND BRACING NOTE

1. FIX ROW OF PLAN BRACING DIRECTLY BELOW TOP CHORD OF BEAM ALONG FULL LENGTH.
2. FIX LATERAL BRACING FROM TOP CHORD TO BOTTOM CHORD AT 2000mm CENTRES MAX. AND AT EVERY STANDARD / PUNCHEON LOCATION.
3. FIX LACING TUBE ACROSS TOP CHORD AT 1000mm CENTRES MAX.
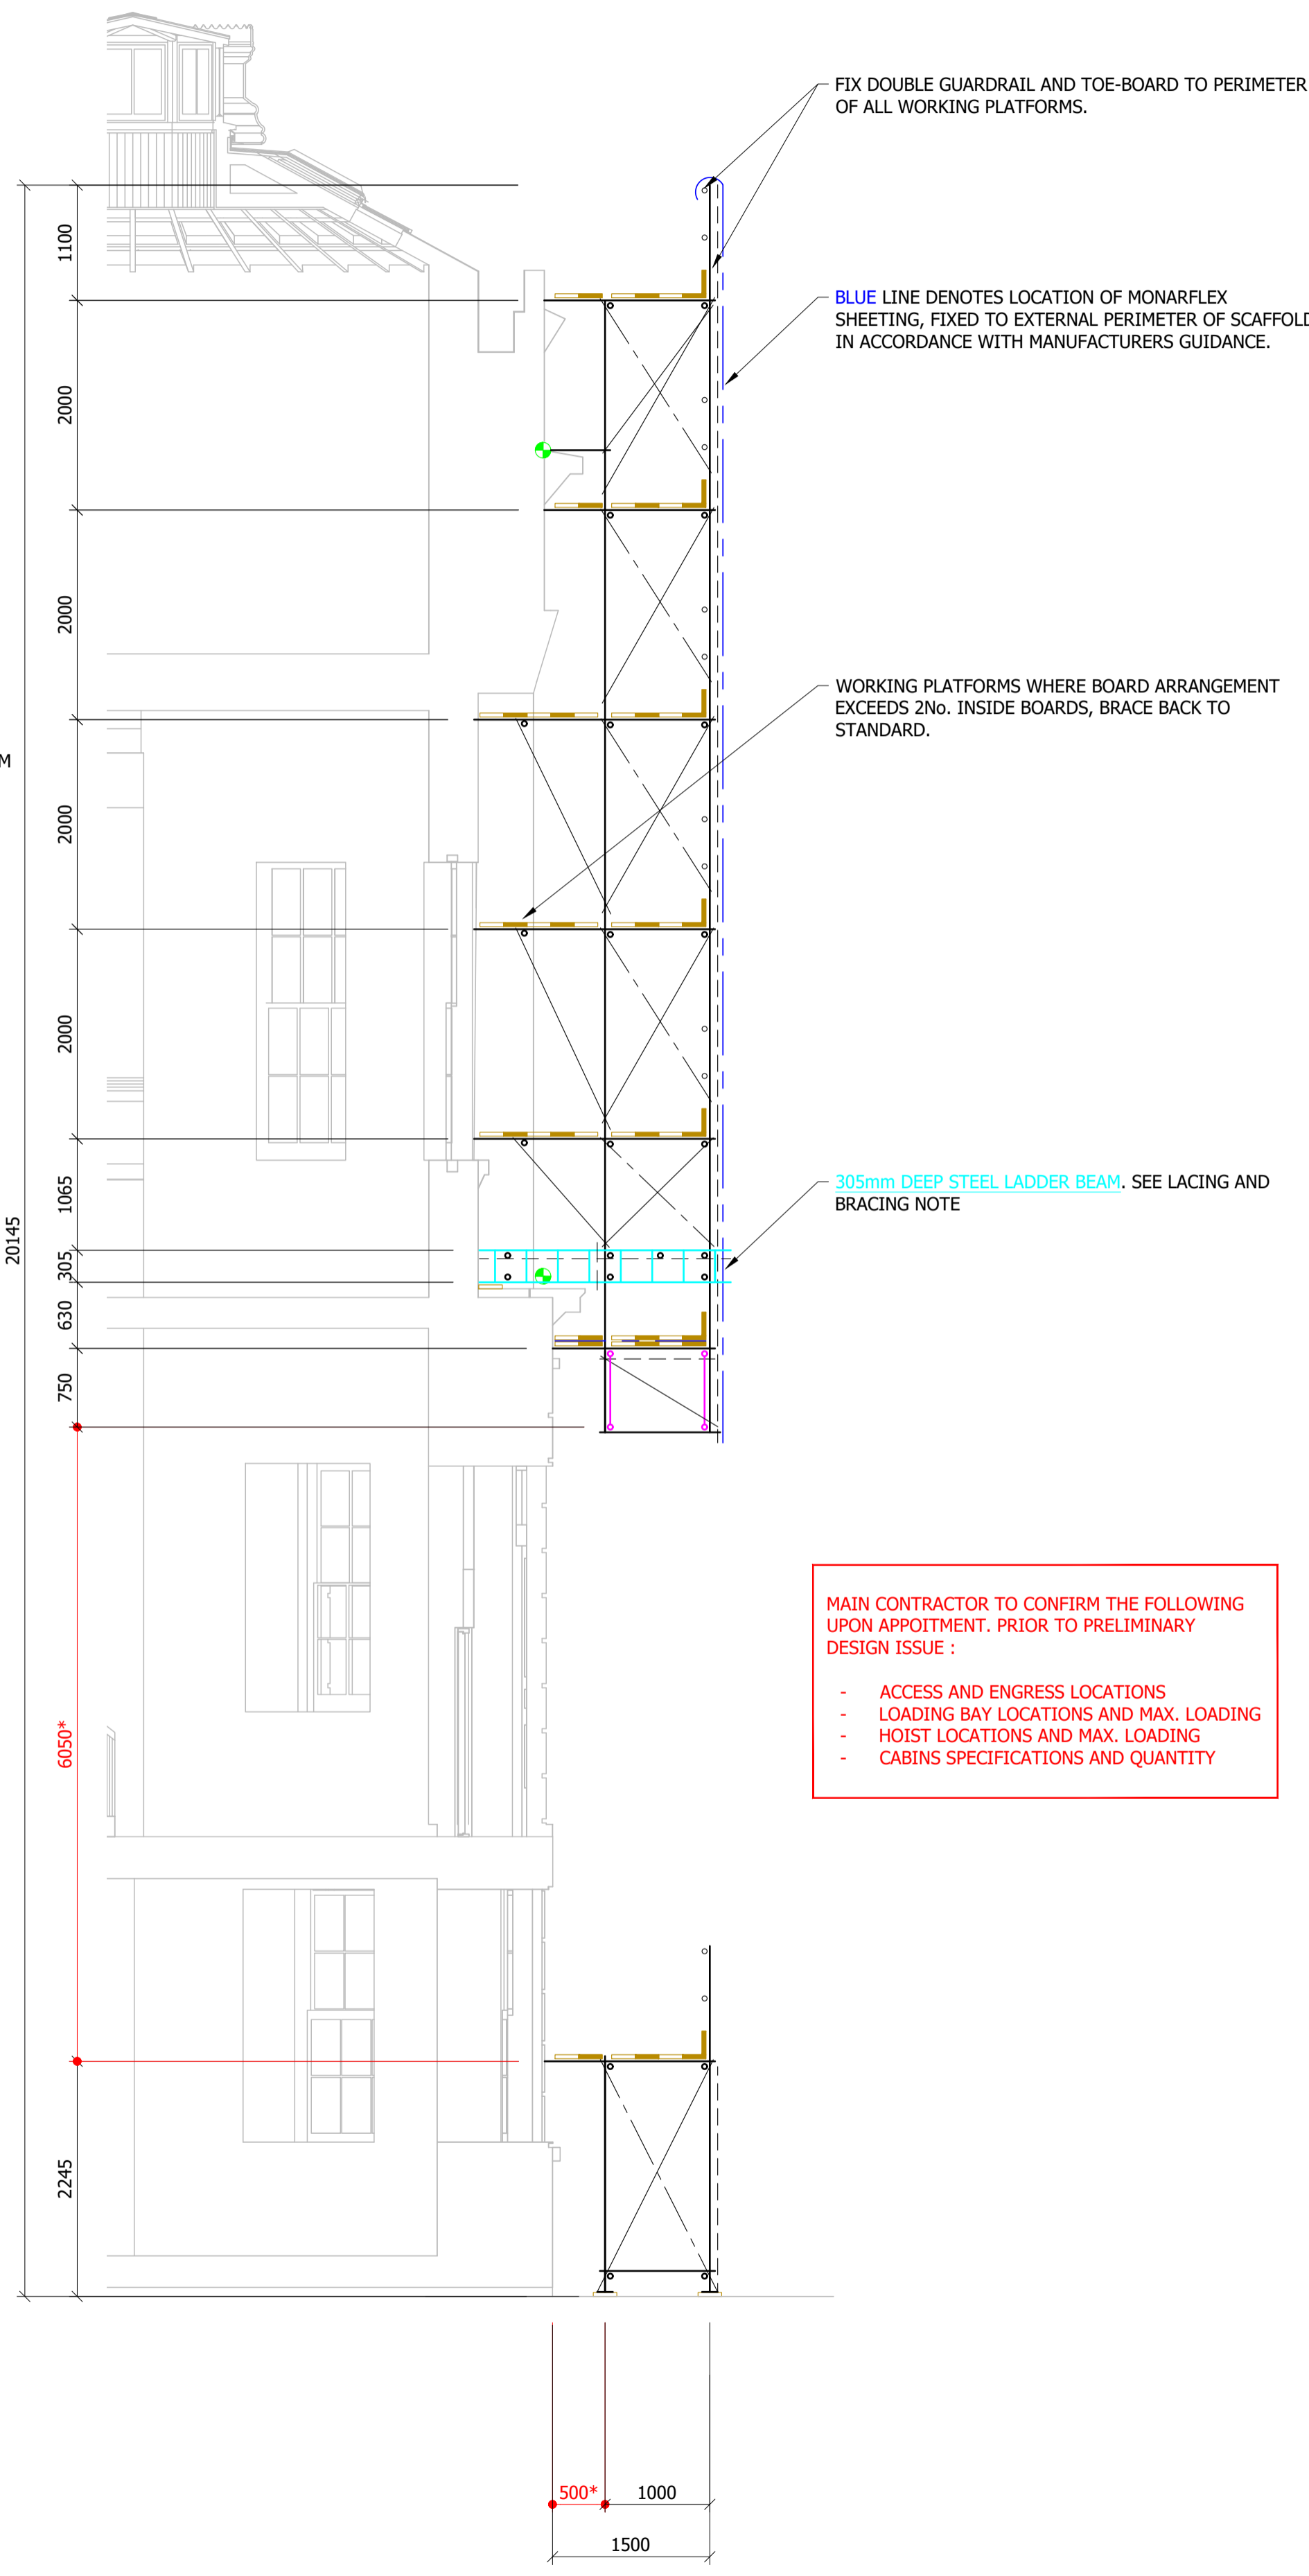4. FIX LACING TUBE ACROSS BOTTOM CHORD AT 2000mm CENTRES MAX.

FIX ALL LACING AND BRACING WITH CLASS 'B' LOAD BEARING COUPLERS.

305mm DEEP STEEL LADDER BEAM LACING AND BRACING NOTE

1. FIX ROW OF PLAN BRACING DIRECTLY BELOW TOP CHORD OF BEAM ALONG FULL LENGTH.
2. FIX LATERAL BRACING FROM TOP CHORD TO BOTTOM CHORD AT 2000mm CENTRES MAX. AND AT EVERY STANDARD / PUNCHEON LOCATION.
3. FIX LACING TUBE ACROSS TOP CHORD AT 1000mm CENTRES MAX.
4. FIX LACING TUBE ACROSS BOTTOM CHORD AT 2000mm CENTRES MAX.

FIX ALL LACING AND BRACING WITH CLASS 'B' LOAD BEARING COUPLERS.

⚠ C3 ⚠ C4 — MAIN CONTRACTOR TO ENSURE EXISTING STRUCTURE IS CAPABLE OF WITHSTANDING LOADS IMPOSED BY SCAFFOLD STANDARDS, TIES AND BUTTING TUBES.
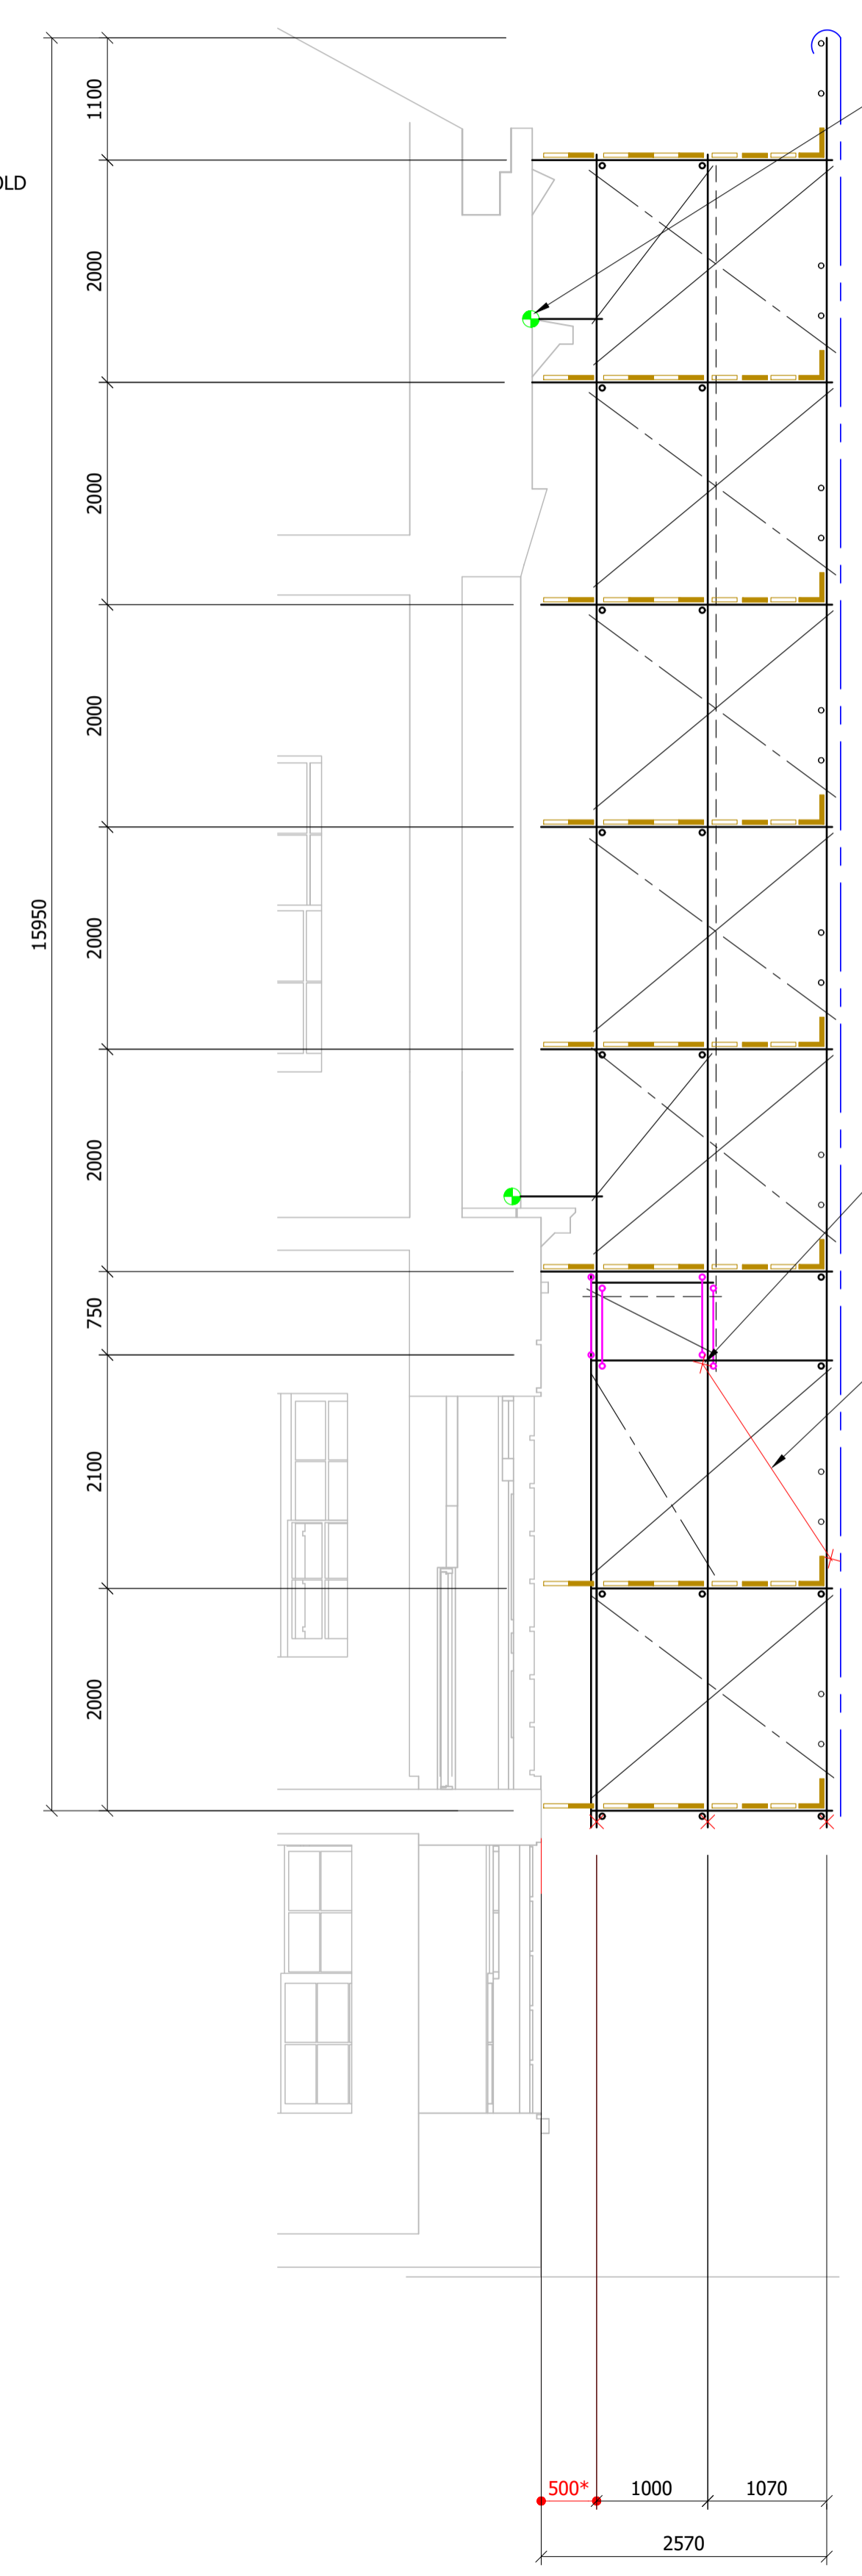
FIX FACADE BRACING TO OUTSIDE STANDARDS FROM GROUND TO FULL HEIGHT OF SCAFFOLD USING CLASS 'B' LOAD BEARING COUPLERS.

FIX LEDGER BRACING AT EVERY LINE OF STANDARDS FROM GROUND TO FULL HEIGHT OF SCAFFOLD USING CLASS 'B' LOAD BEARING COUPLERS.

PIGGYBACKED 750mm DEEP APOLLO X BEAM. SEE LACING AND BRACING NOTE

⚠ C3 — ENSURE SOUND & LEVEL FOOTINGS. ALL STANDARDS TO BE FOOTED ON M.S. BASEPLATES ON 38MM THICK TIMBER SOLE PADS.

FIX DOUBLE GUARDRAIL AND TOE-BOARD TO PERIMETER OF ALL WORKING PLATFORMS.

BLUE LINE DENOTES LOCATION OF MONARFLEX SHEETING, FIXED TO EXTERNAL PERIMETER OF SCAFFOLD IN ACCORDANCE WITH MANUFACTURERS GUIDANCE.

WORKING PLATFORMS WHERE BOARD ARRANGEMENT EXCEEDS 2No. INSIDE BOARDS, BRACE BACK TO STANDARD.

305mm DEEP STEEL LADDER BEAM. SEE LACING AND BRACING NOTE

MAIN CONTRACTOR TO CONFIRM THE FOLLOWING UPON APPOITMENT. PRIOR TO PRELIMINARY DESIGN ISSUE :
- ACCESS AND ENGRESS LOCATIONS
- LOADING BAY LOCATIONS AND MAX. LOADING
- HOIST LOCATIONS AND MAX. LOADING
- CABINS SPECIFICATIONS AND QUANTITY

⚠ C4 — GREEN TIE SYMBOL DENOTES WELDED BUTT TUBE. SEE TIE DETAIL ON DR-02.

RED 'X' DENOTES LOCATION OF CLASS 'B' SUPPLEMENTARY COUPLER FIXED DIRECTLY BELOW EACH SIDE OF BRACE TO STANDARD LOCATION.

RED LINE DENOTES BRACING AT SCAFFOLD LOCATION WHERE EXISITING BUILDING STEPS OUT.

SECTION B-B
1:50

SECTION D-D
1:50

SECTION C-C
1:50