


| Rev. | Date | By |
|------|------|----|
|------|------|----|

| Rev. | Date | By |
|------|------|----|
|------|------|----|

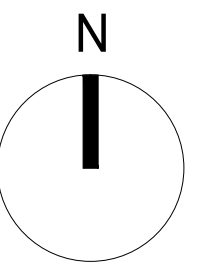

IONS TO BE CHECKED ON SITE  
FIGURED DIMENSIONS ONLY  
REPARANCIES TO THE ARCHITECT  
CE BEFORE PROCEEDING

ALL DIMENSIONS TO BE CHECKED ON SITE  
WORK TO FIGURED DIMENSIONS ONLY  
REPORT DISCREPANCIES TO THE ARCHITECT  
AT ONCE BEFORE PROCEEDING

46 Great Marlborough Street  
London  
W1F 7JW  
Telephone: 020 7494 9000 Fax: 020 7494 4944

Client

65 HOLMES ROAD LTD

Project Title

B8/WAREHOUSE CONVERSION TO  
B1 OFFICE AND STUDIO SPACES  
67 - 69 HOLMES ROAD, LONDON NW5 3AN

Drawing Title  
AS BUILT PLAN  
LOWER BASEMENT

Scale 1: 100@A0 NTS@A3 Date JUNE 2020

|       |    |         |    |
|-------|----|---------|----|
| Drawn | EA | Checked | CT |
|-------|----|---------|----|




|             |      |
|-------------|------|
| Drawing No. | Rev. |
|-------------|------|

A(SO)080

CAD plot date:



| REVISIONS |      |    |
|-----------|------|----|
| Rev.      | Date | By |
|           |      |    |

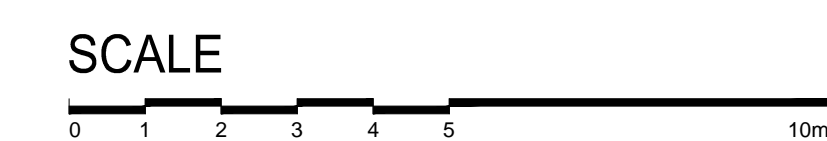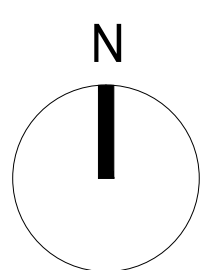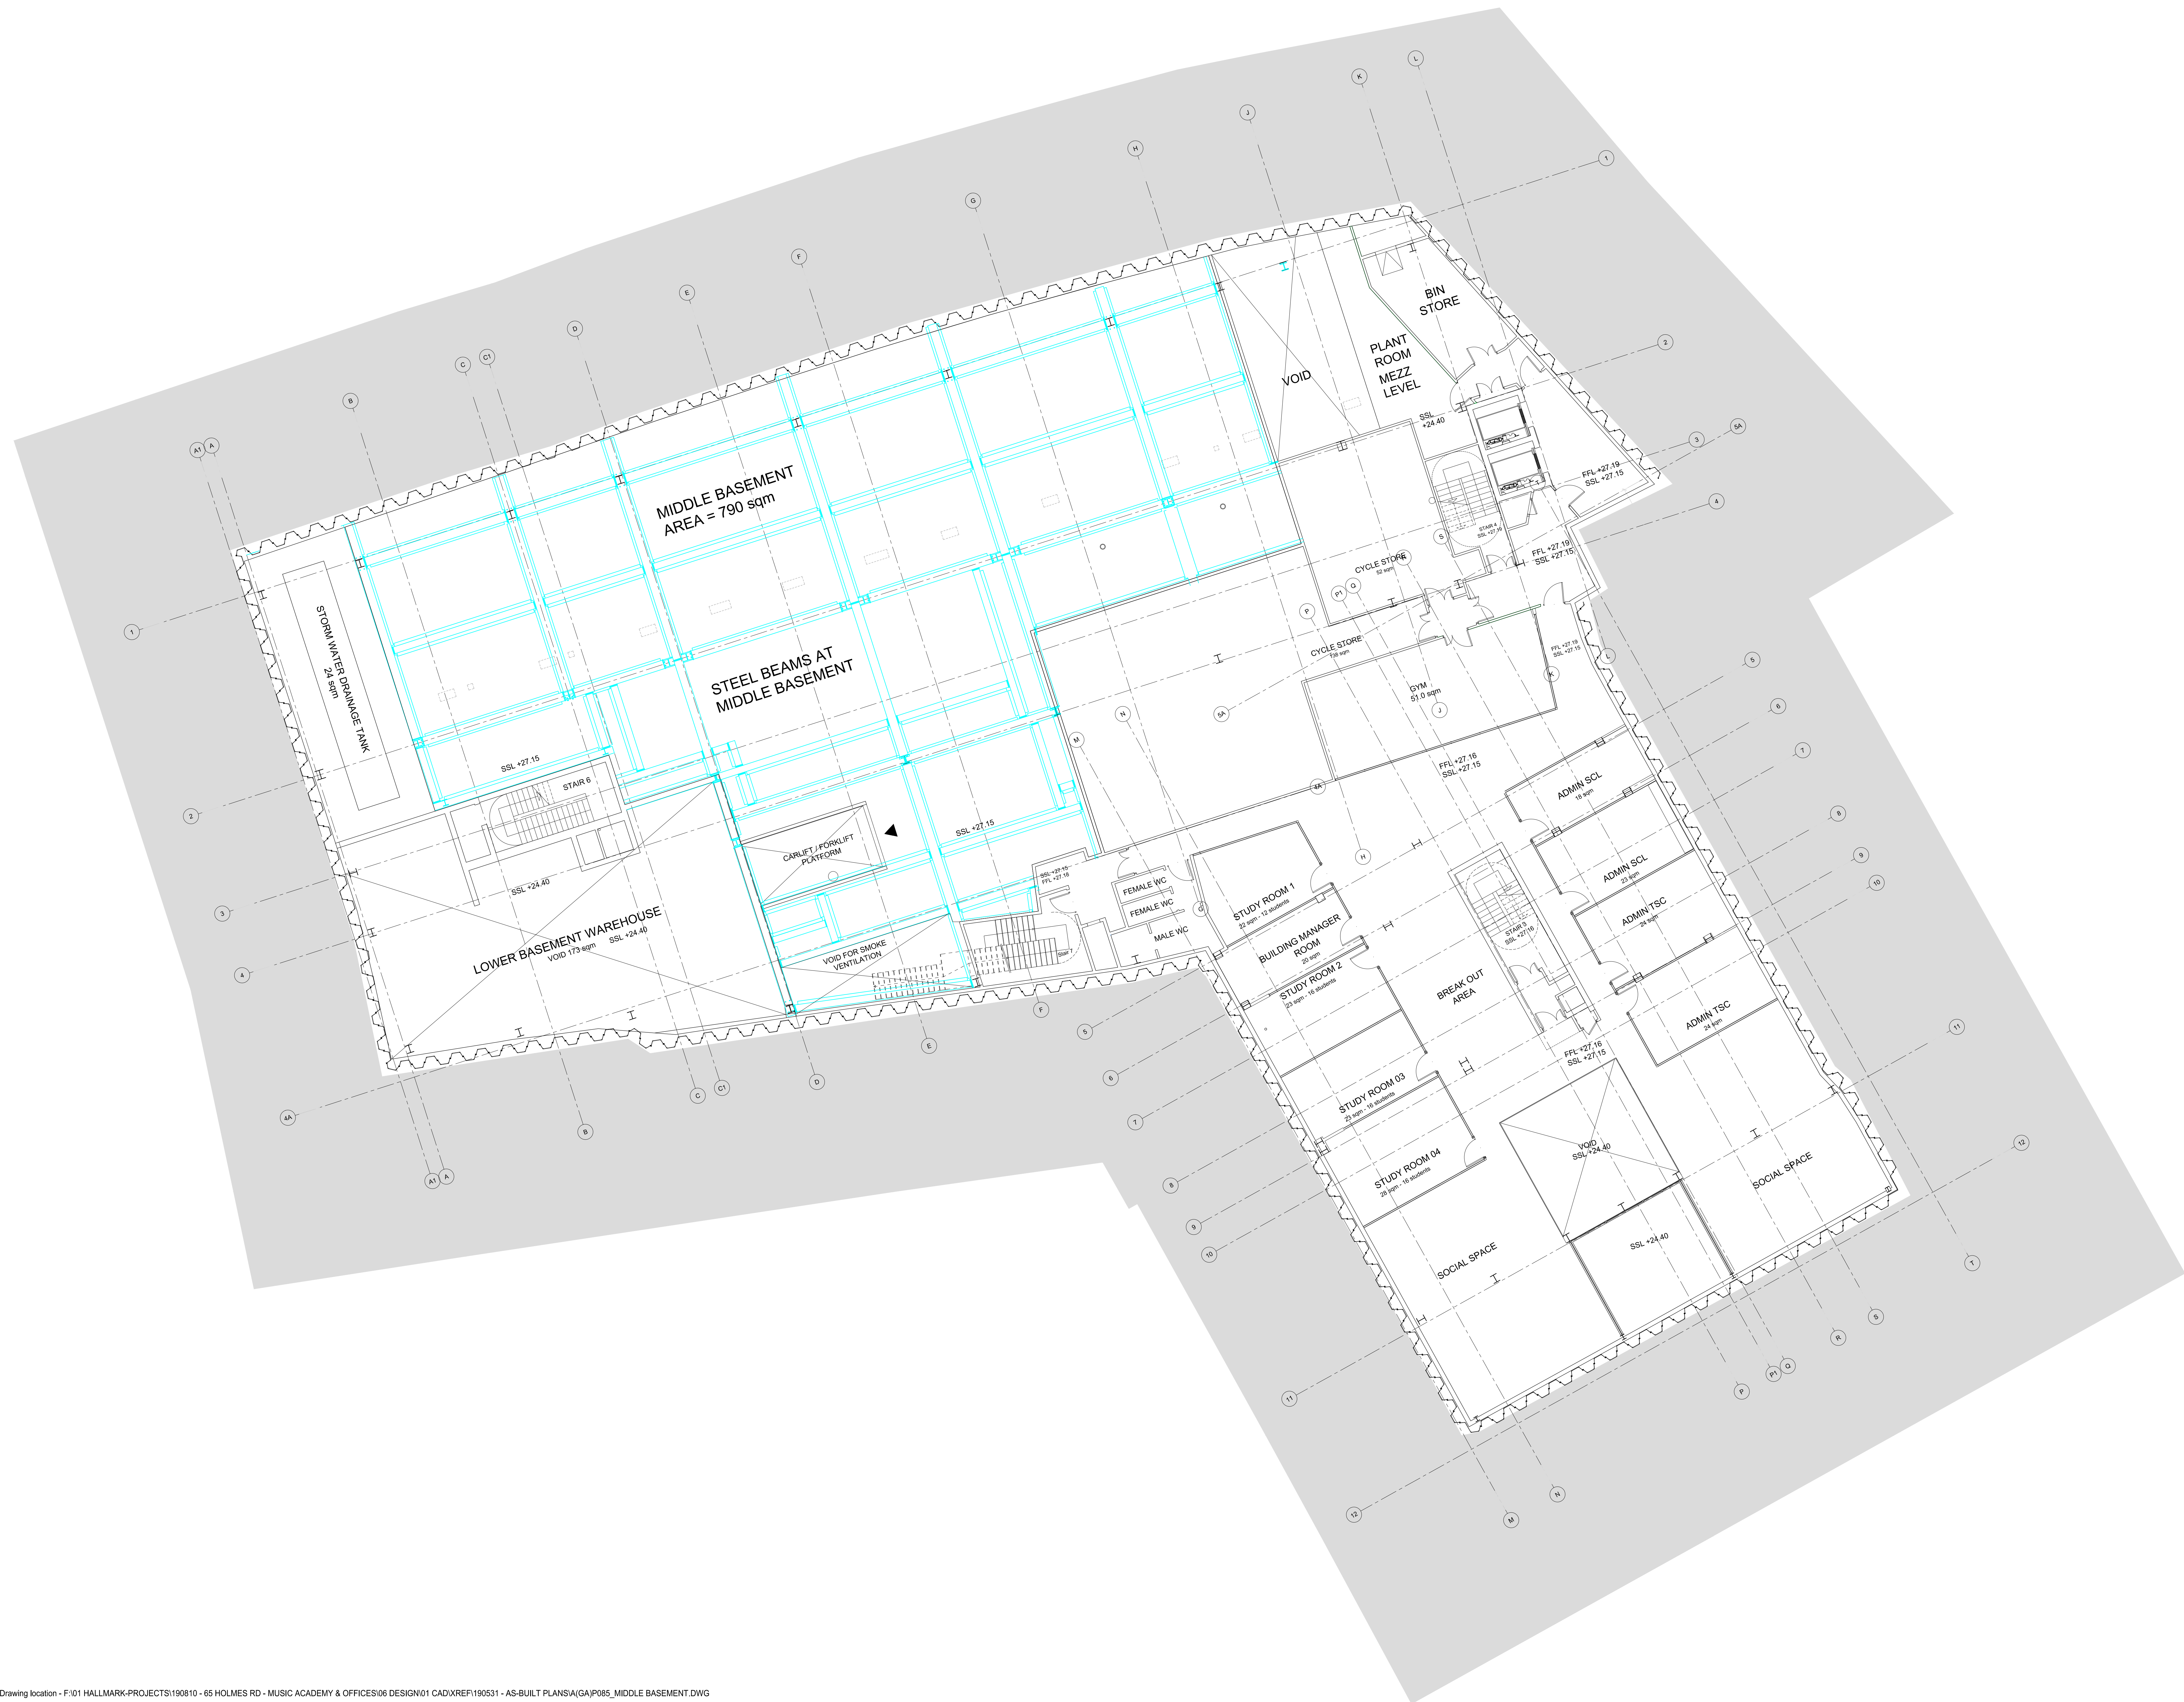

AS BUILT

ALL DIMENSIONS TO BE CHECKED ON SITE  
WORK TO FIGURED DIMENSIONS ONLY  
REPORT DISCREPANCIES TO THE ARCHITECT  
AT ONCE BEFORE PROCEEDING

Contemporary Design Solutions

46 Great Marlborough Street  
London  
W1F 7JW  
Telephone: 020 7494 9000 Fax: 020 7494 4944

Client

65 HOLMES ROAD LTD

Project Title

B&WAREHOUSE CONVERSION TO  
B1 OFFICES AND STUDIO SPACES  
67-69 HOLMES ROAD, LONDON NW5 3AN

Drawing Title

AS BUILT PLAN  
MEZZANINE LEVEL

|             |           |         |      |           |
|-------------|-----------|---------|------|-----------|
| Scale       | 1: 100@A0 | NTS@A3  | Date | JUNE 2020 |
| Drawn       | EA        | Checked | CT   |           |
| Drawing No. | A(SO)085  |         |      |           |
| Rev.        |           |         |      |           |

CAD plot date:






# REVISIONS

| Rev. | Date | By |
|------|------|----|
|      |      |    |

SCALE


0 1 2 3 4 5 10m

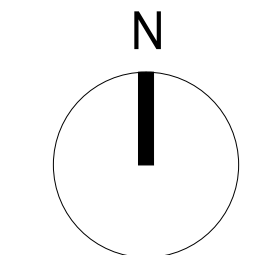

## AS BUILT

ALL DIMENSIONS TO BE CHECKED ON SITE  
WORK TO FIGURED DIMENSIONS ONLY  
REPORT DISCREPANCIES TO THE ARCHITECT  
AT ONCE BEFORE PROCEEDING

## Contemporary Design Solutions

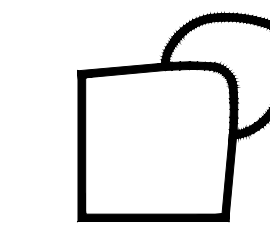

46 Great Marlborough Street  
London  
W1F 7JN  
Telephone: 020 7494 8000 Fax: 020 7494 4944

## Client

65 HOLMES ROAD LTD

## Project Title

B8/WAREHOUSE CONVERSION TO  
B1 OFFICE AND STUDIO SPACES  
67-69 HOLMES ROAD, LONDON NW5 3AN

## Drawing Title

AS BUILT PLAN  
UPPER BASEMENT

|             |           |         |      |           |
|-------------|-----------|---------|------|-----------|
| Scale       | 1: 100@A0 | NTS@A3  | Date | JUNE 2020 |
| Drawn       | EA        | Checked | CT   |           |
| Drawing No. |           | Rev.    |      |           |



A(SO)090

CAD plot date:



REVISIONS


| Rev. | Date | By |
|------|------|----|
|      |      |    |

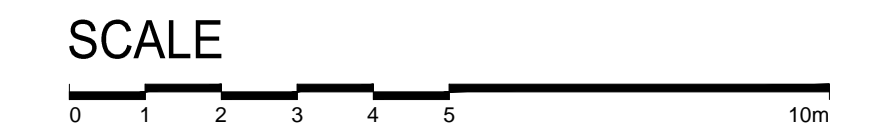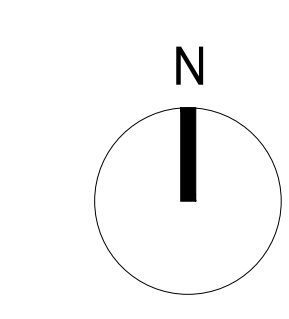

AS BUILT

ALL DIMENSIONS TO BE CHECKED ON SITE  
WORK TO FIGURED DIMENSIONS ONLY  
REPORT DISCREPANCIES TO THE ARCHITECT  
AT ONCE BEFORE PROCEEDING

Contemporary Design Solutions

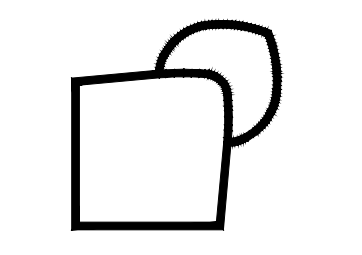

46 Great Marlborough Street  
London  
W1F 7JW  
Telephone: 020 7494 9000 Fax: 020 7494 4944

Client

65 HOLMES ROAD LTD

Project Title

B8/WAREHOUSE CONVERSION TO  
B1 OFFICE AND STUDIO SPACES  
67 - 69 HOLMES ROAD, LONDON NW5 3AN

Drawing Title

AS BUILT PLAN  
GROUND FLOOR

|             |           |         |      |           |
|-------------|-----------|---------|------|-----------|
| Scale       | 1: 100@A0 | NTS@A3  | Date | JUNE 2020 |
| Drawn       | EA        | Checked | CT   |           |
| Drawing No. | Rev.      |         |      |           |

A(SO)100

CAD plot date: