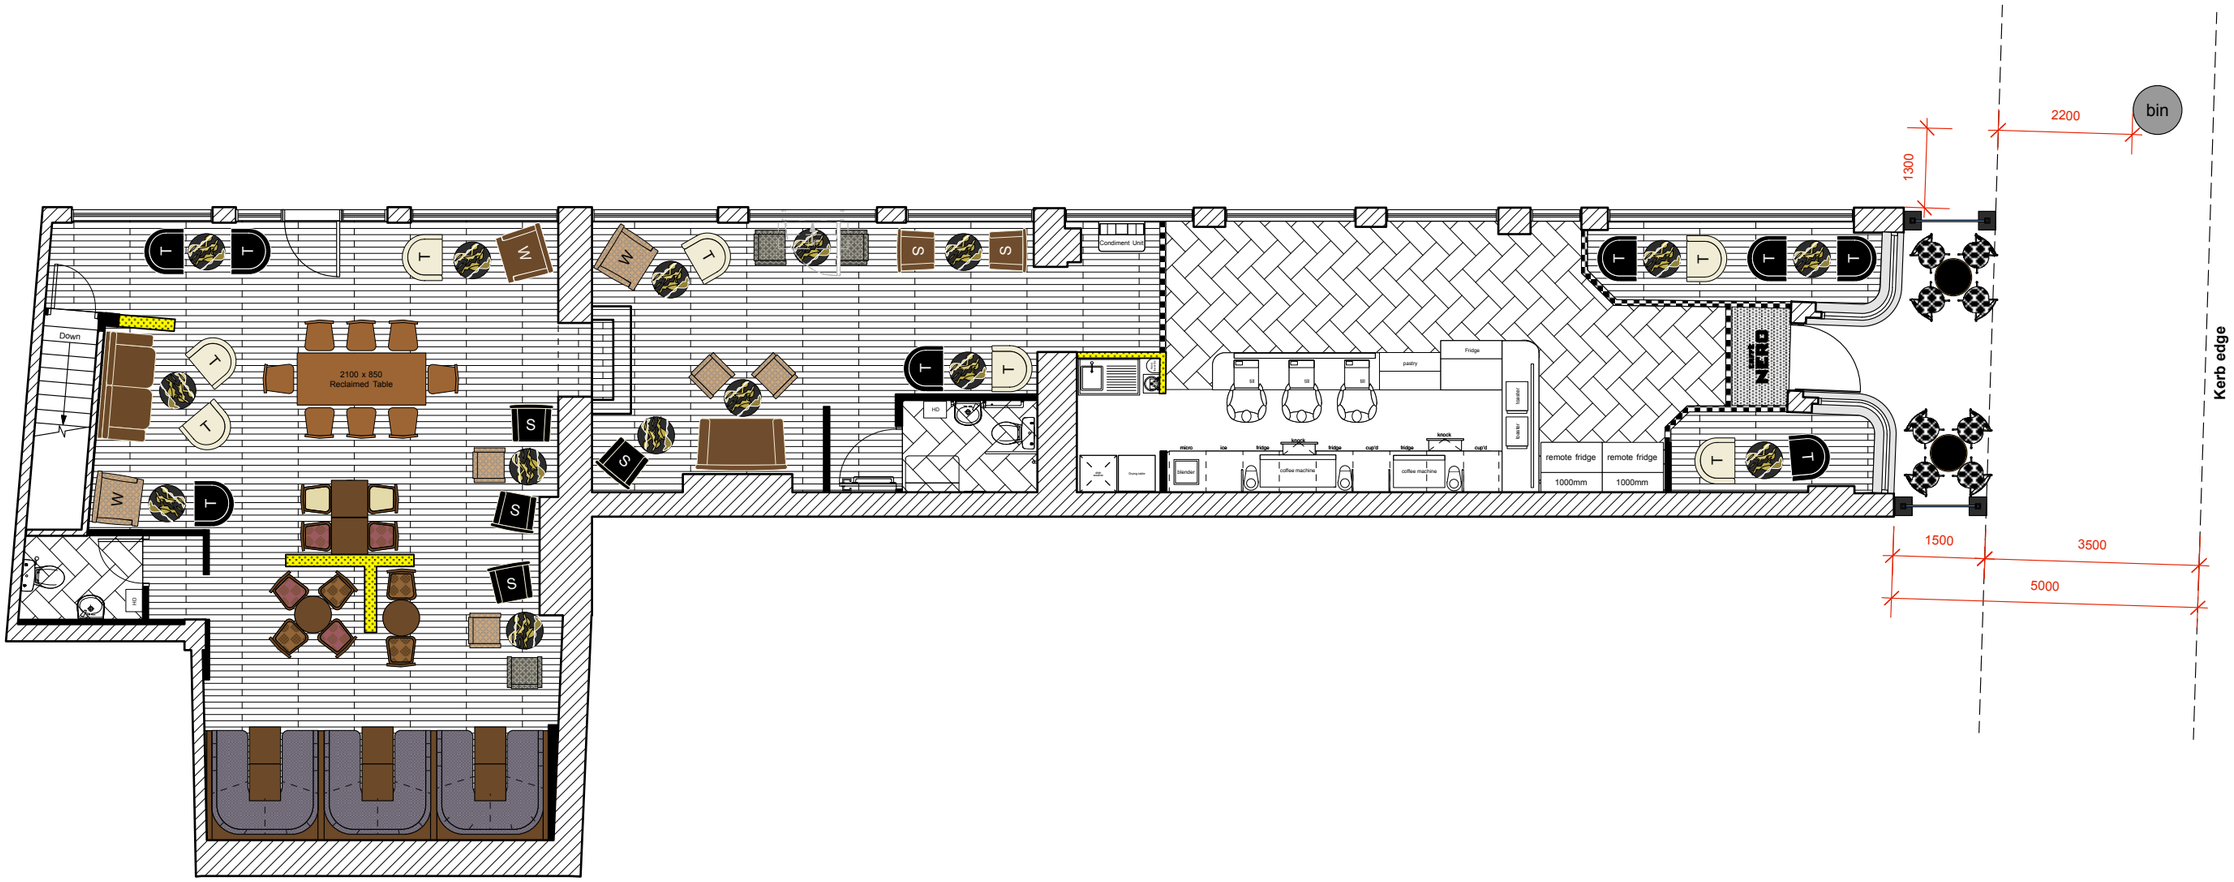

bedrock

Bedrock Design Consultants Ltd
2nd Floor, 39 Gold Street, Northampton,
NN1 1RA

T 01604 250002
F 01604 250003
info@bedrockdesign.co.uk

Client	Scale	Drawn by	Date
Caffe Nero	1:100@A3	RW	26.02.2016
Project	**Drawing Nº**		**Revision**
126 Tottenham Court Road	CN724 - 701		
Description			
Exernal Seating			

This drawing is the copyright of Bedrock Design Consultants Ltd. This drawing cannot be copied, reproduced, retained or disclosed to any unauthorised person without prior permission in writing from the designer.

Rev Nº	Description	Drawn by	Date

AS BUILT

Notes

This drawing represents a performance guide upon which the contractor/subcontractor must base his/her working drawings & details. Include all necessary tolerances prior to manufacture and installation.

Contractor to must undertake a full survey of the area to establish all dimensions & ensure accurate setting out.

Advise on suitability of all details shown to ensure structural stability, ease and economy of construction

Refer to digital master artwork in regard to all graphic work shown